

QUARRY BANK MILL, STYAL, CHESHIRE

Survey Report

**Volume 3 -
Survey Figures**

Oxford Archaeology North

September 2014

NATIONAL TRUST

**Issue No: 2013-14/1452
OA North Job No: L10603
NGR: SJ 836 829**

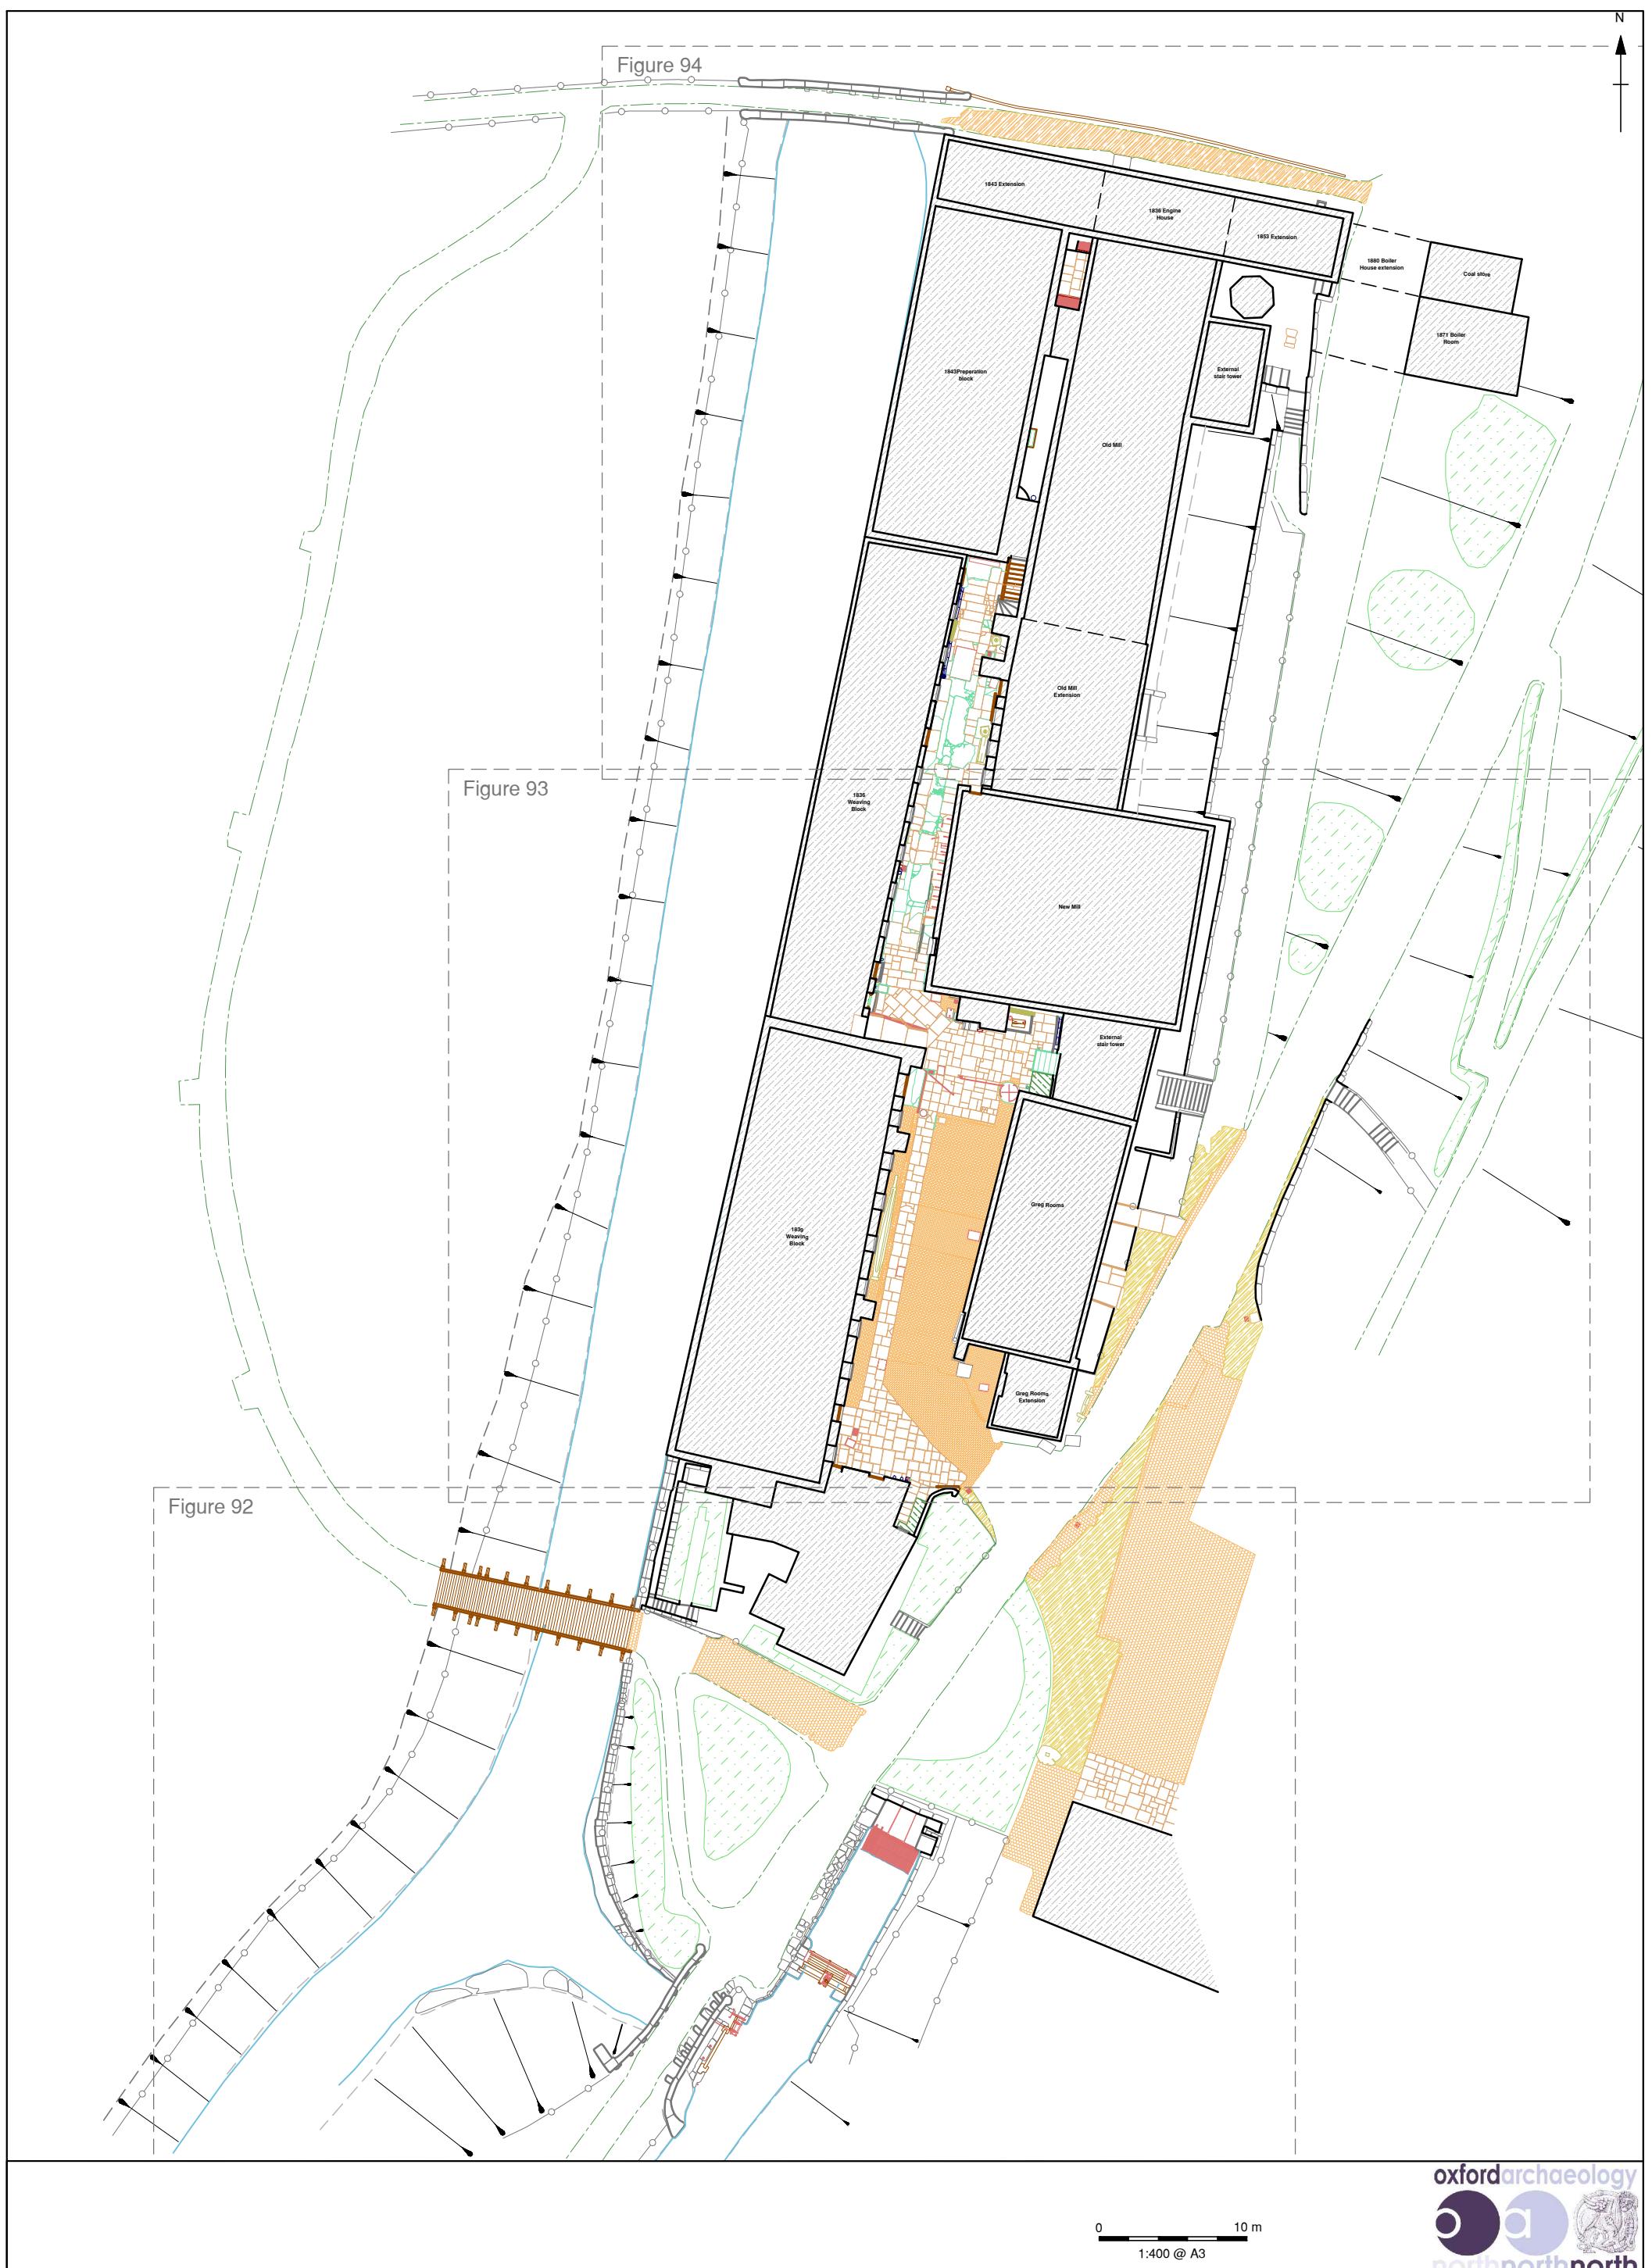


Figure 91: Topographic survey, showing location of detailed plans

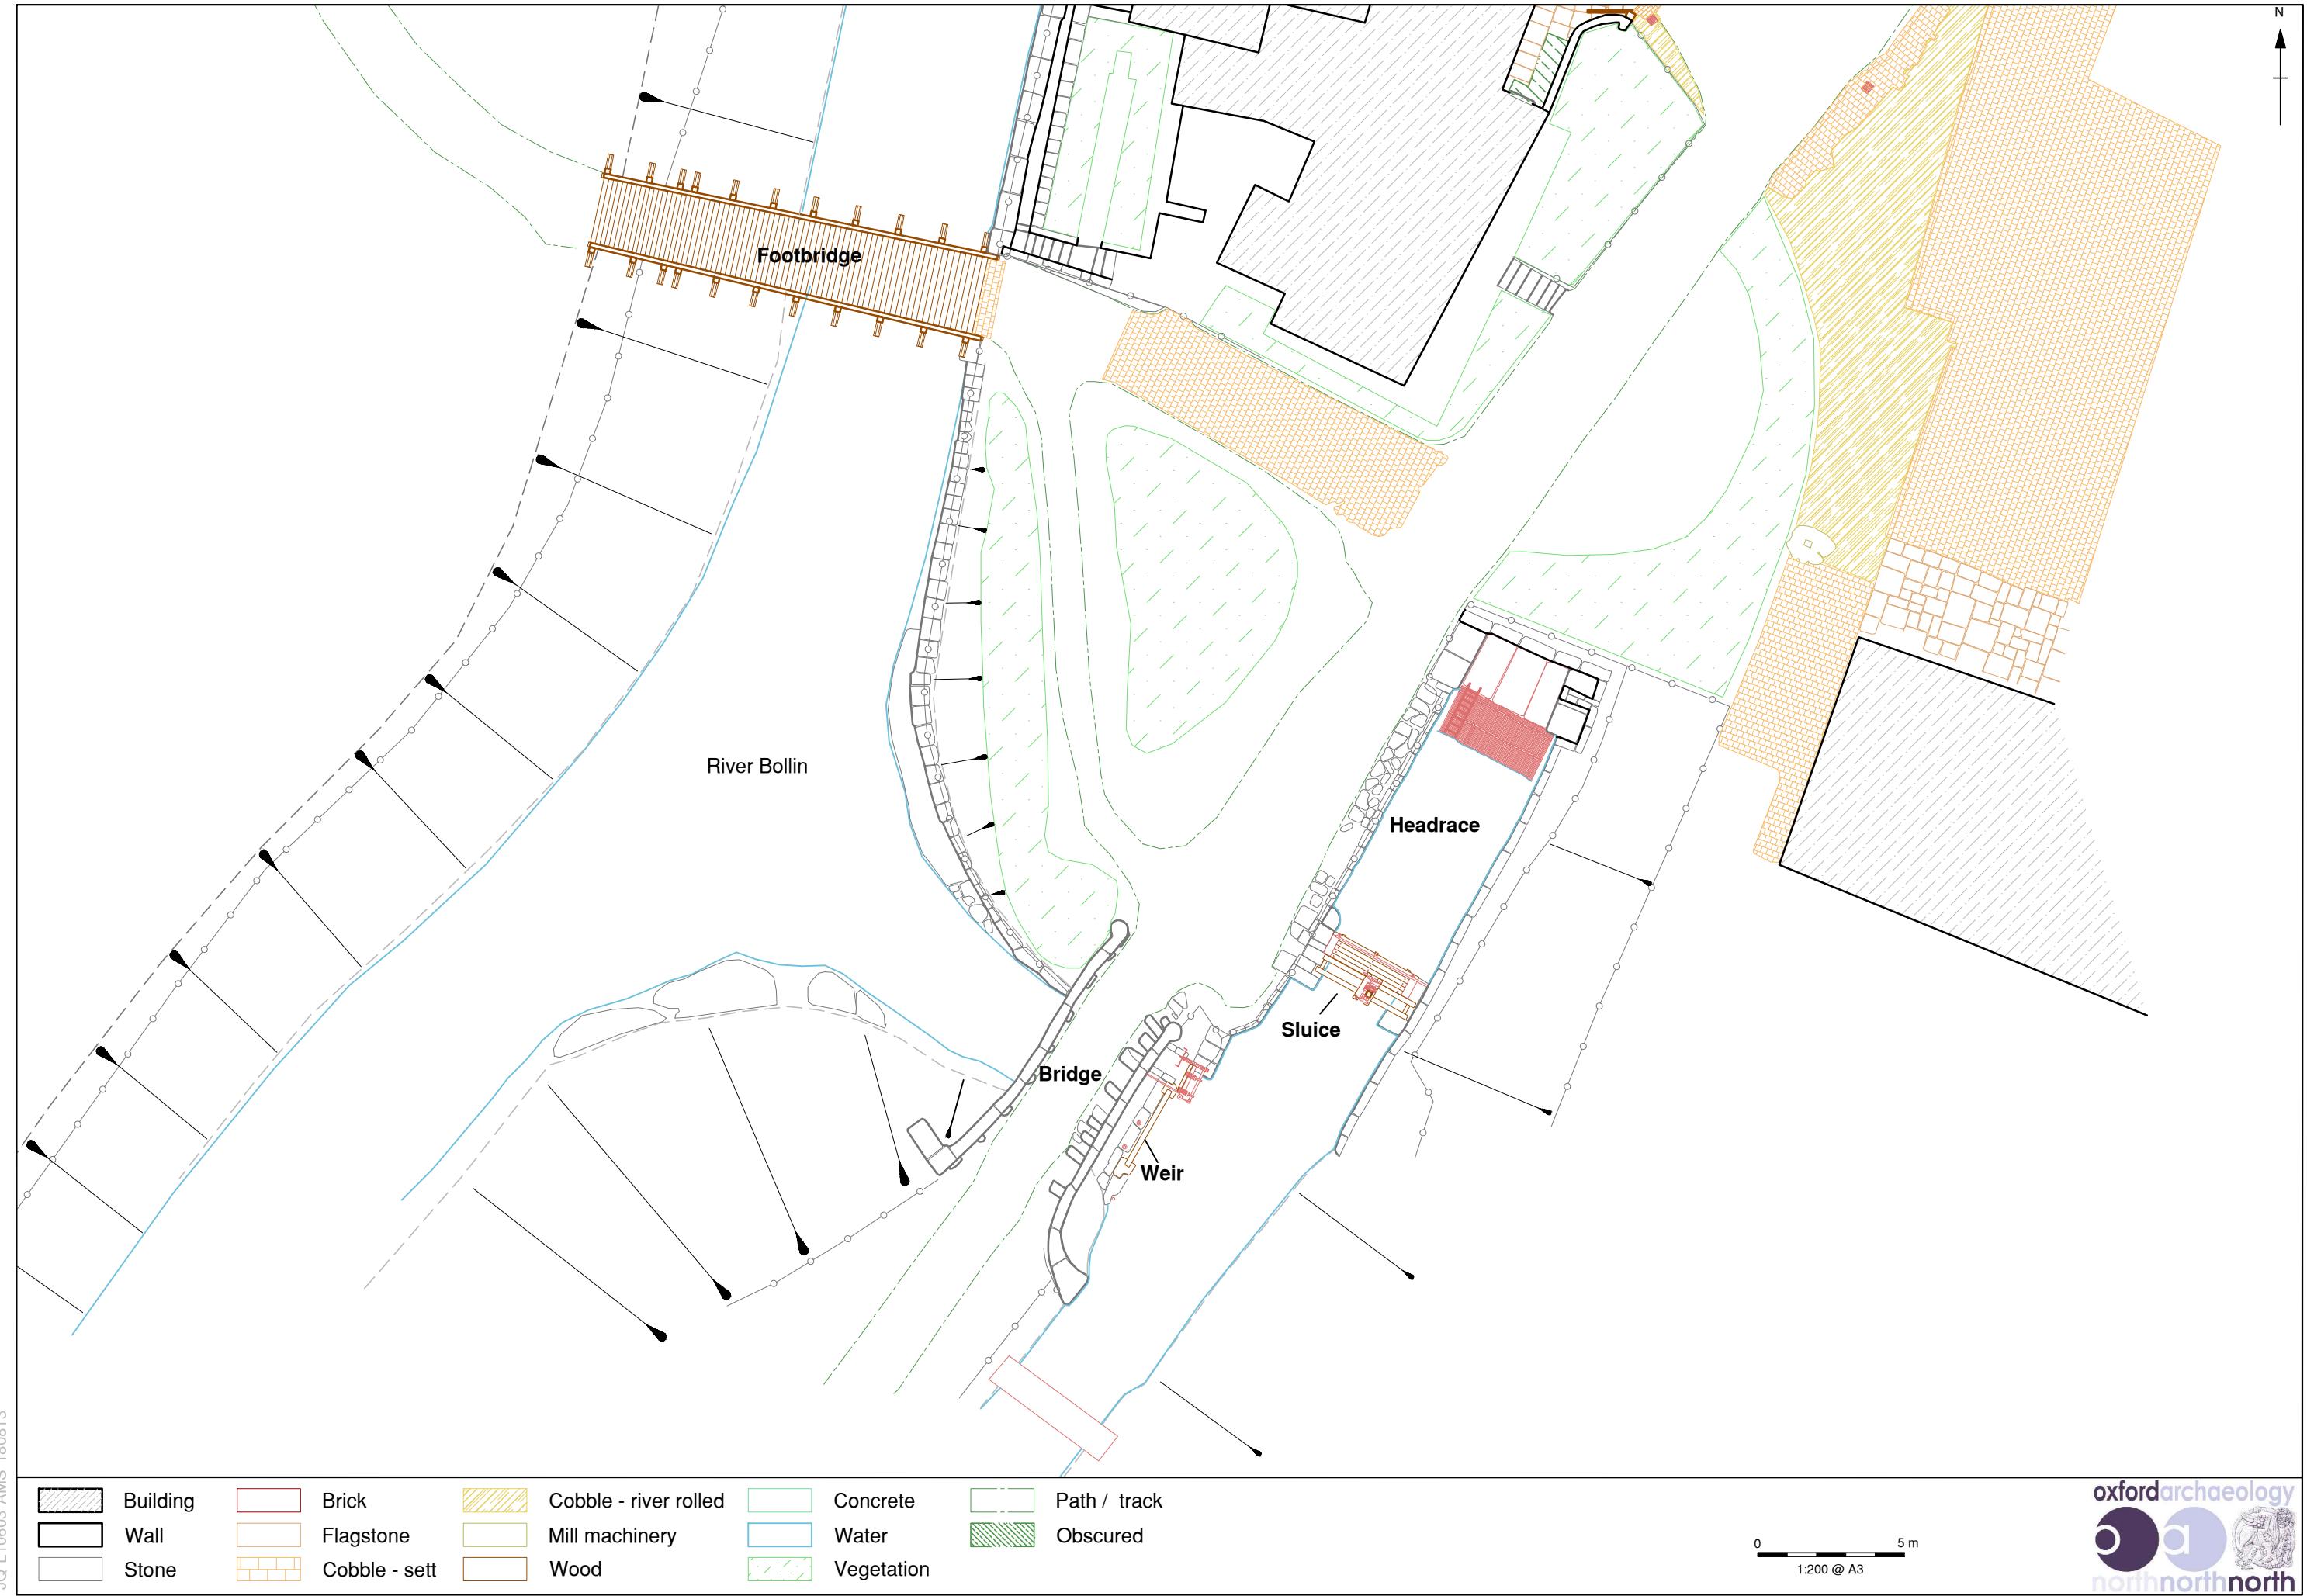


Figure 92: Topographic survey (South)

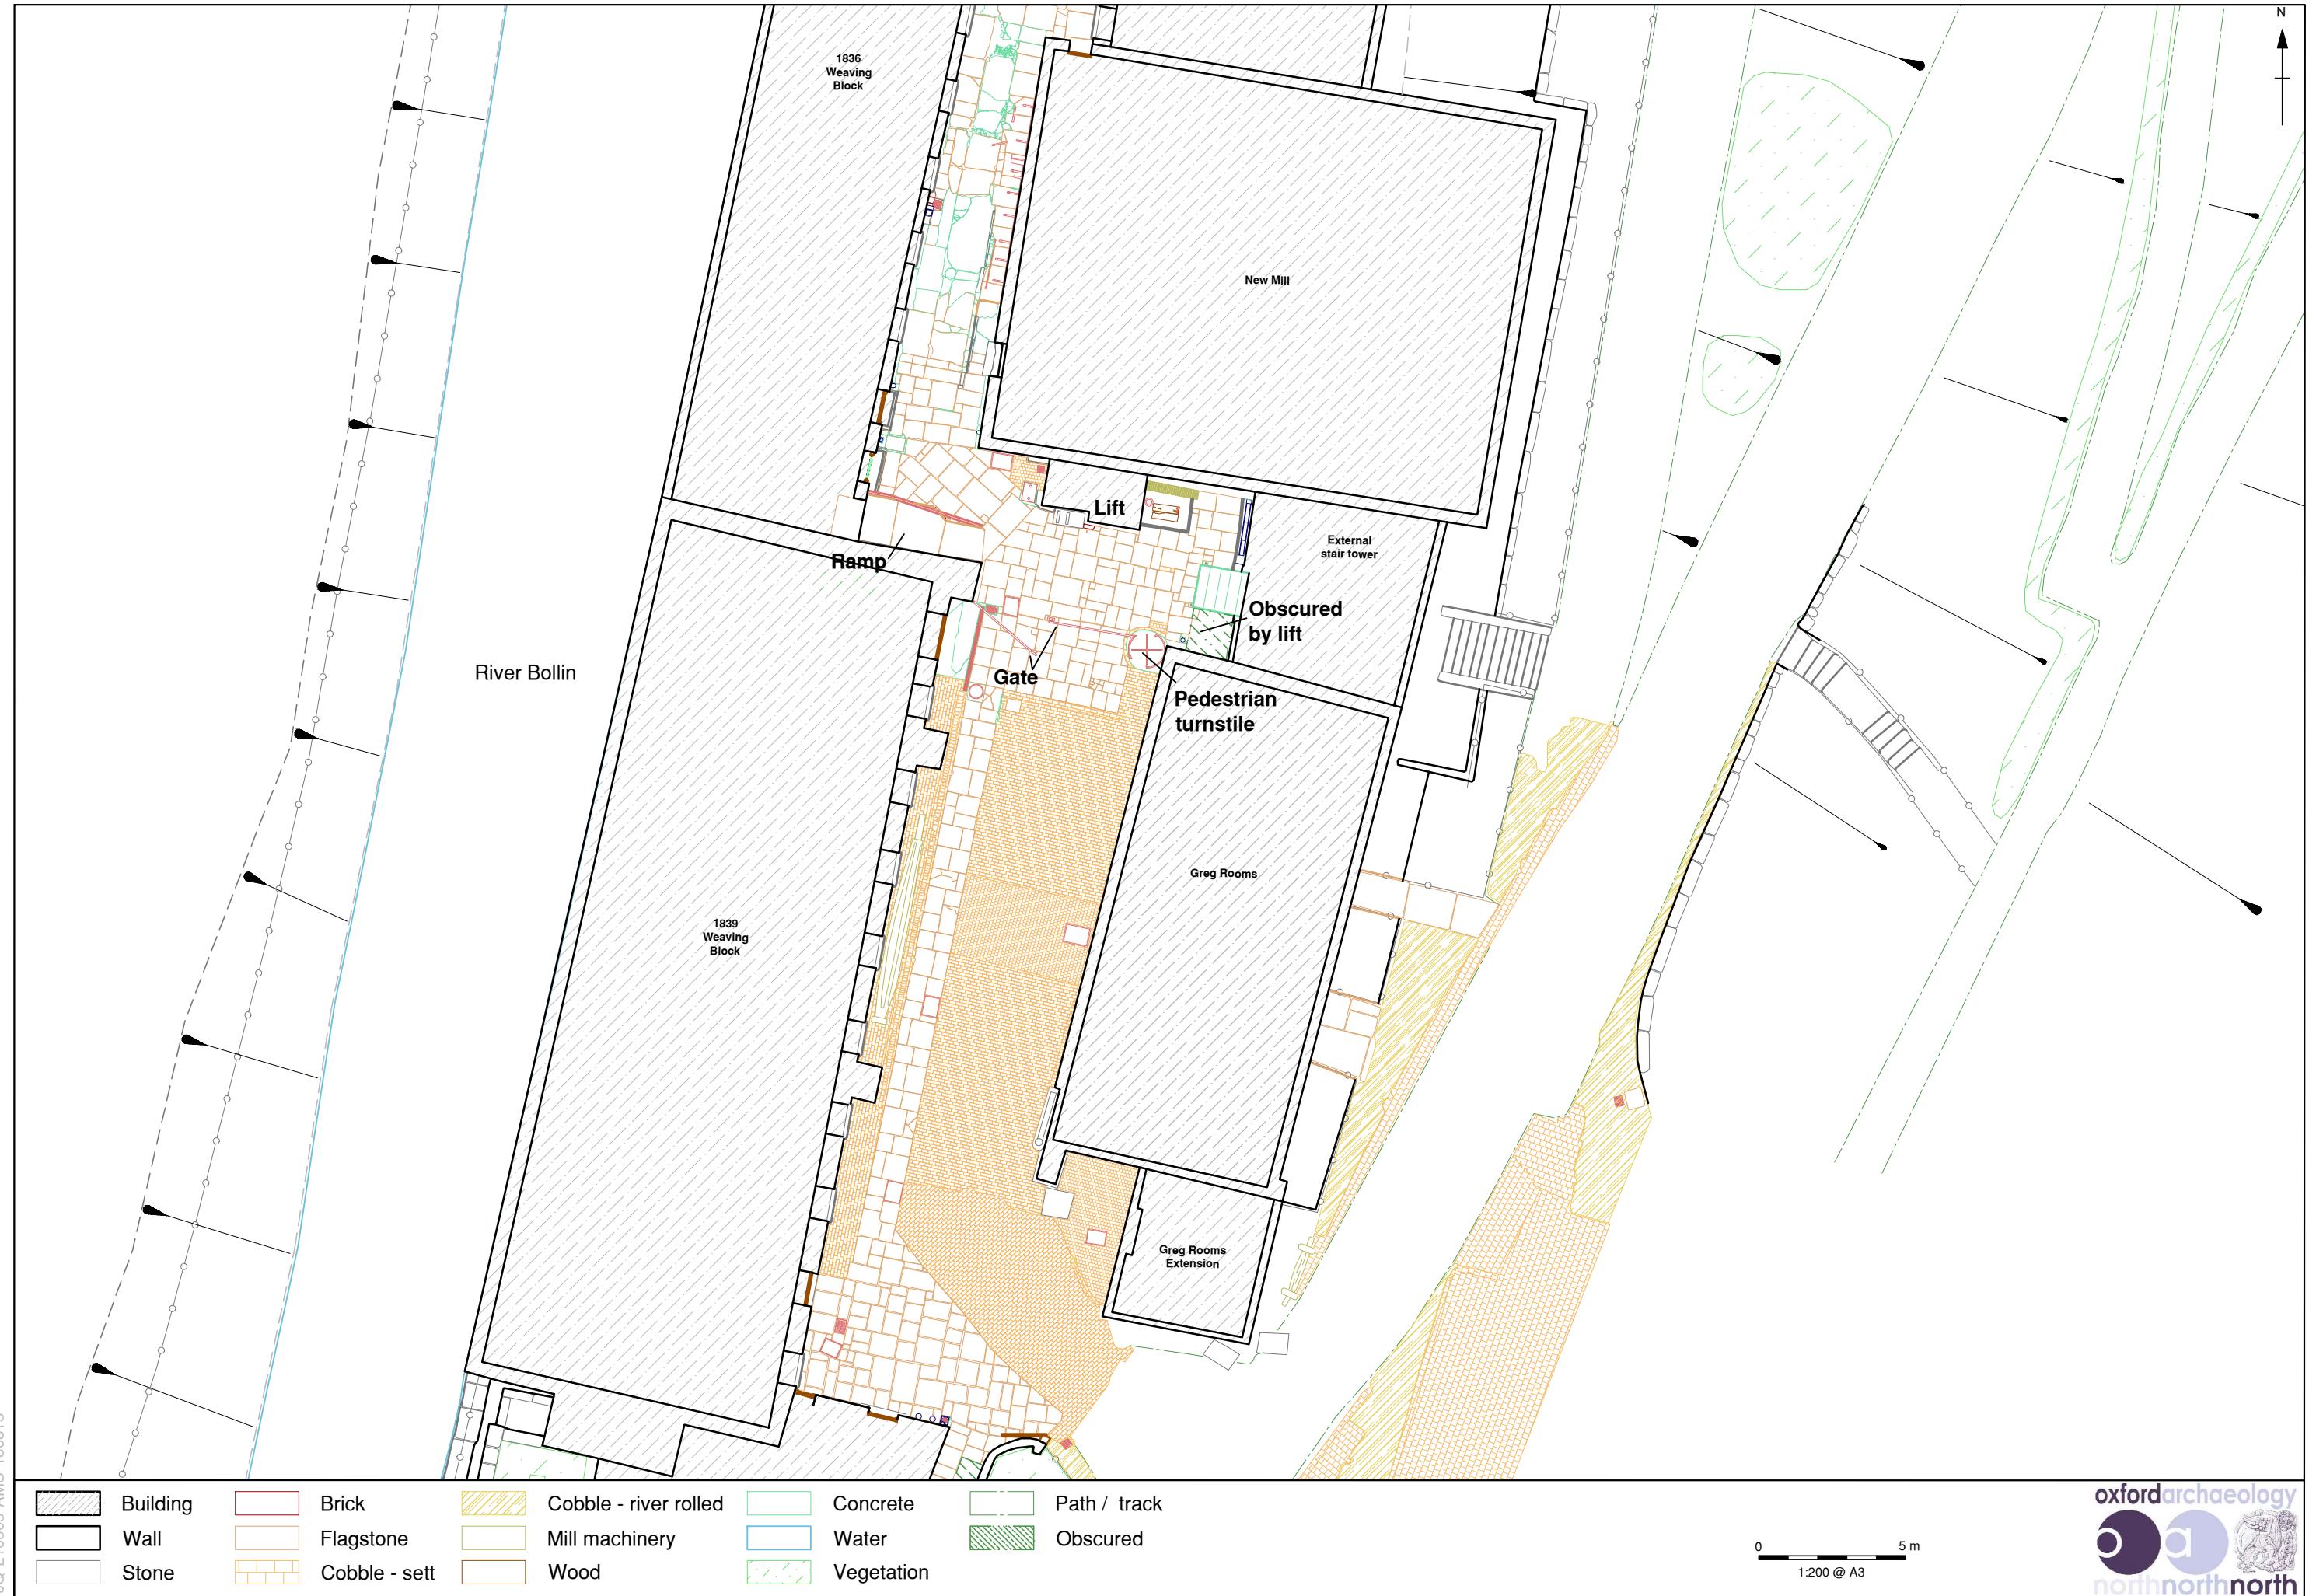


Figure 93: Topographic survey (central)

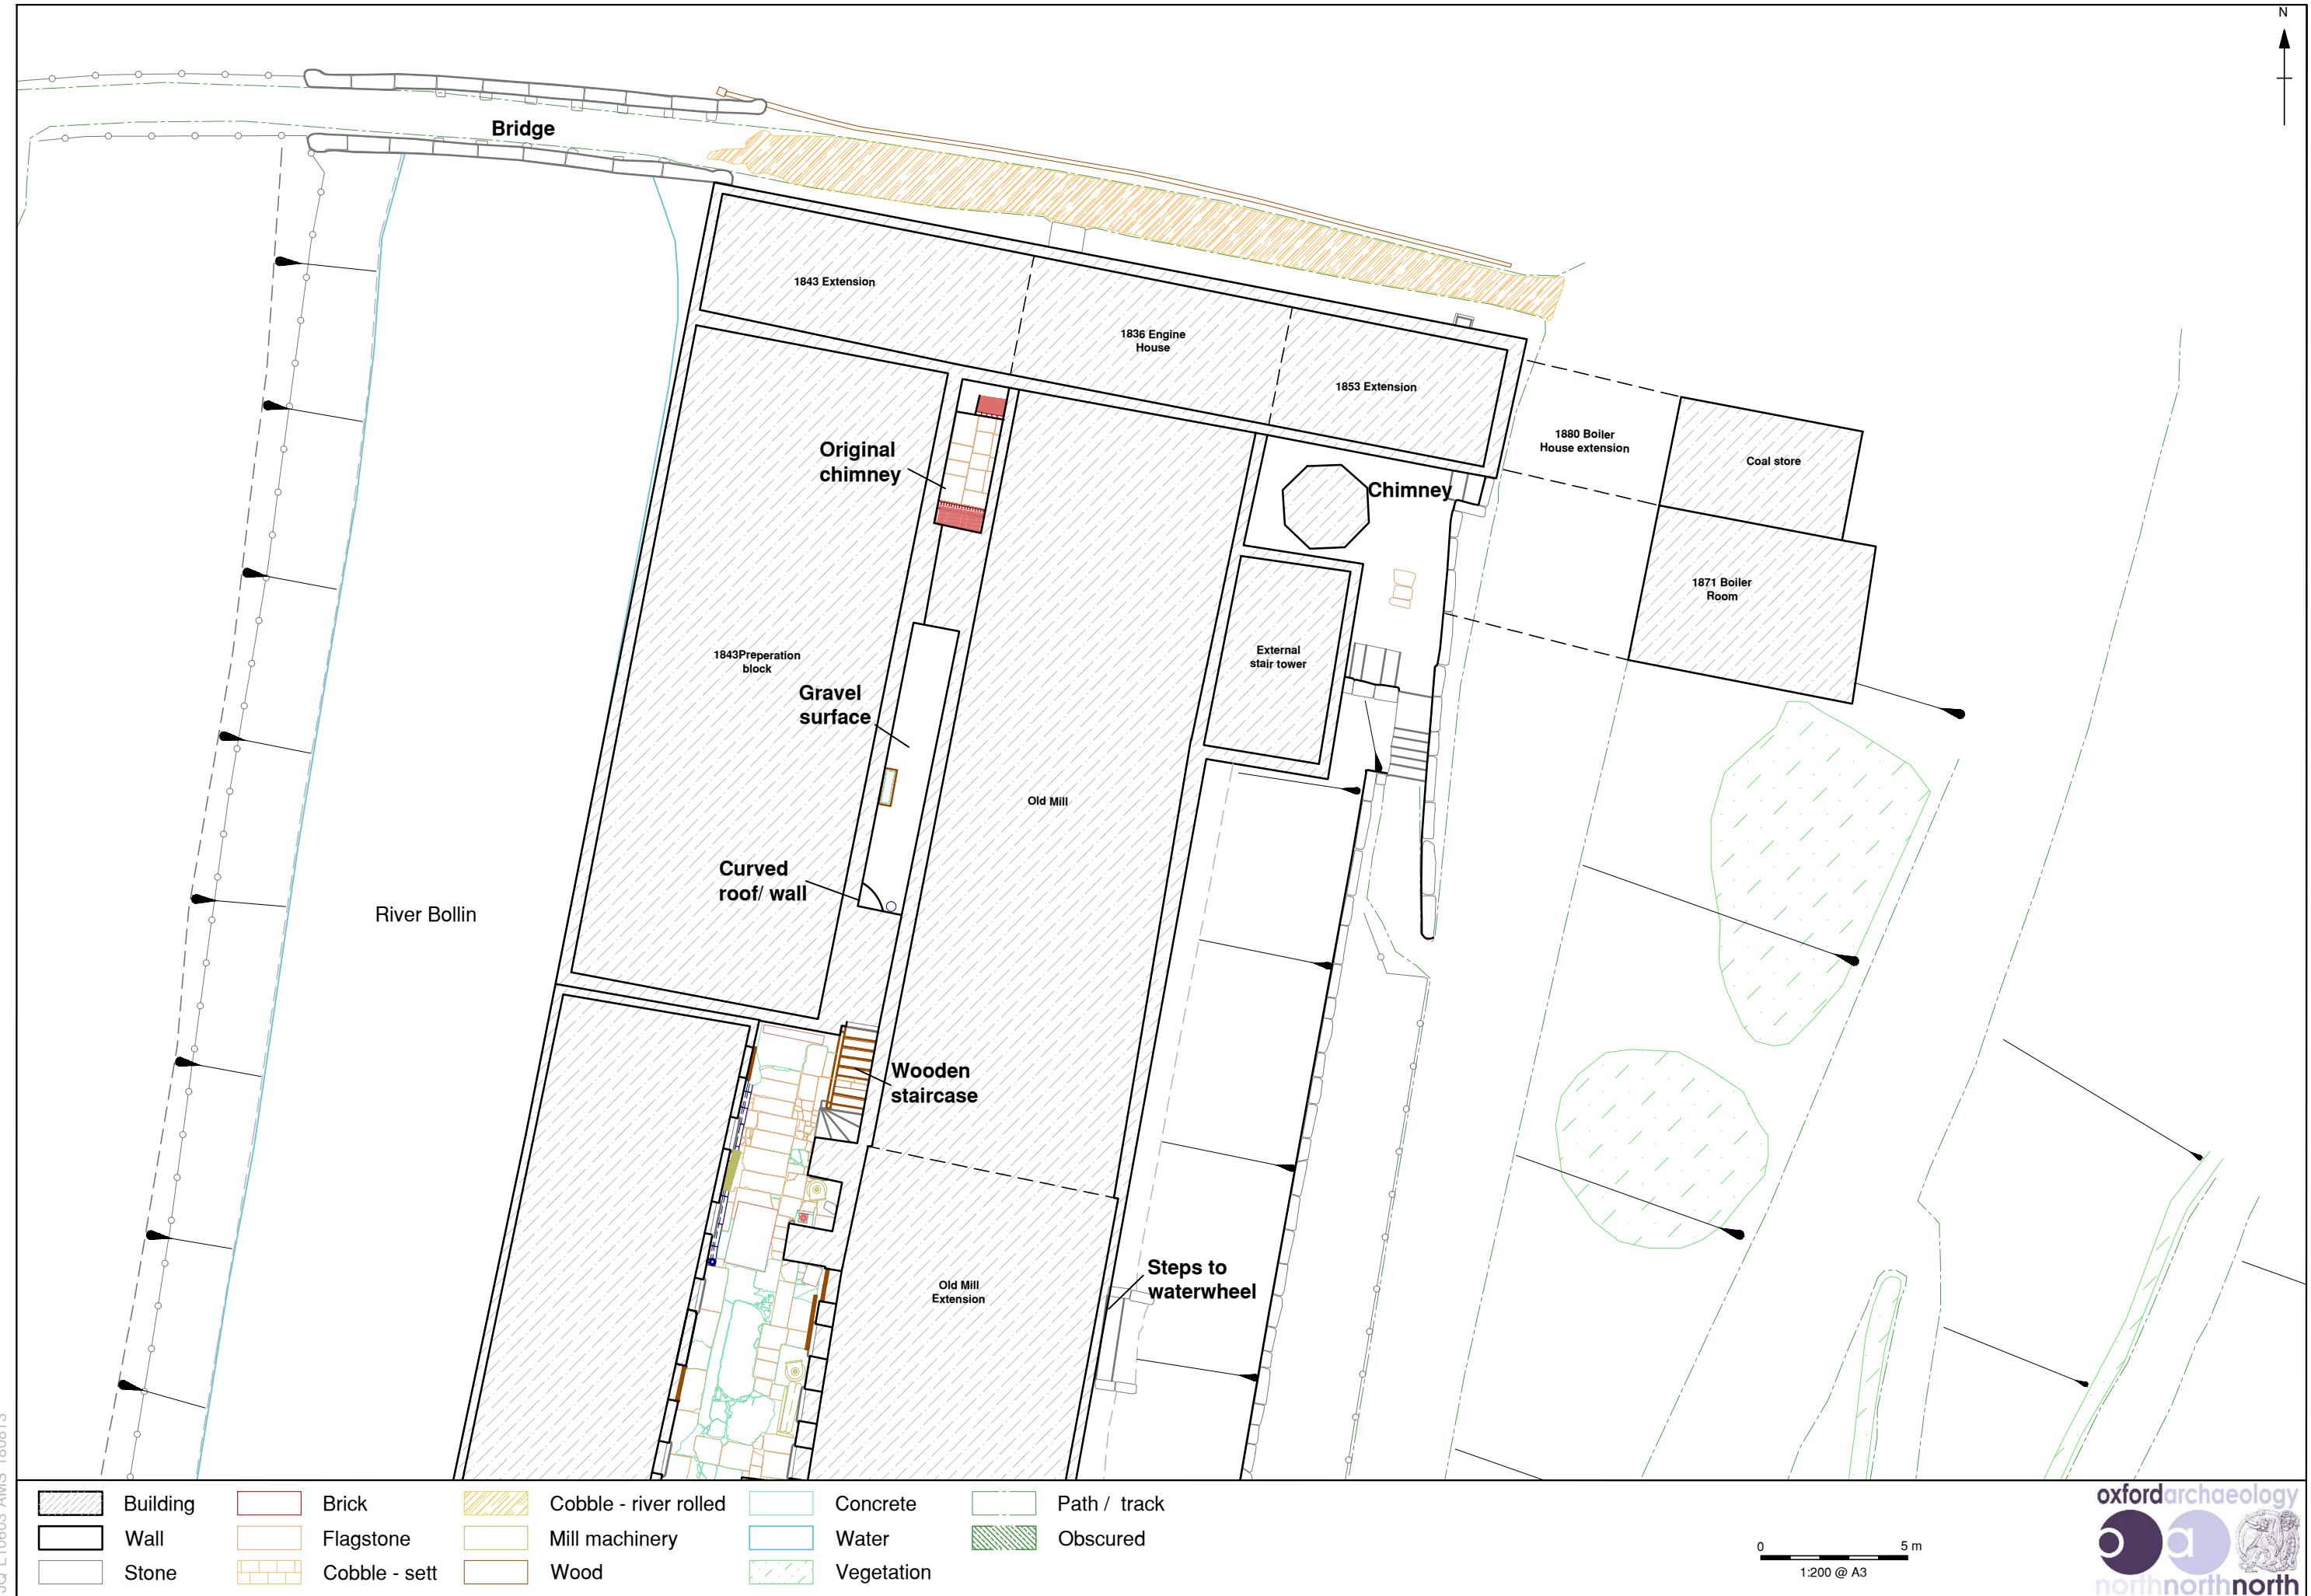
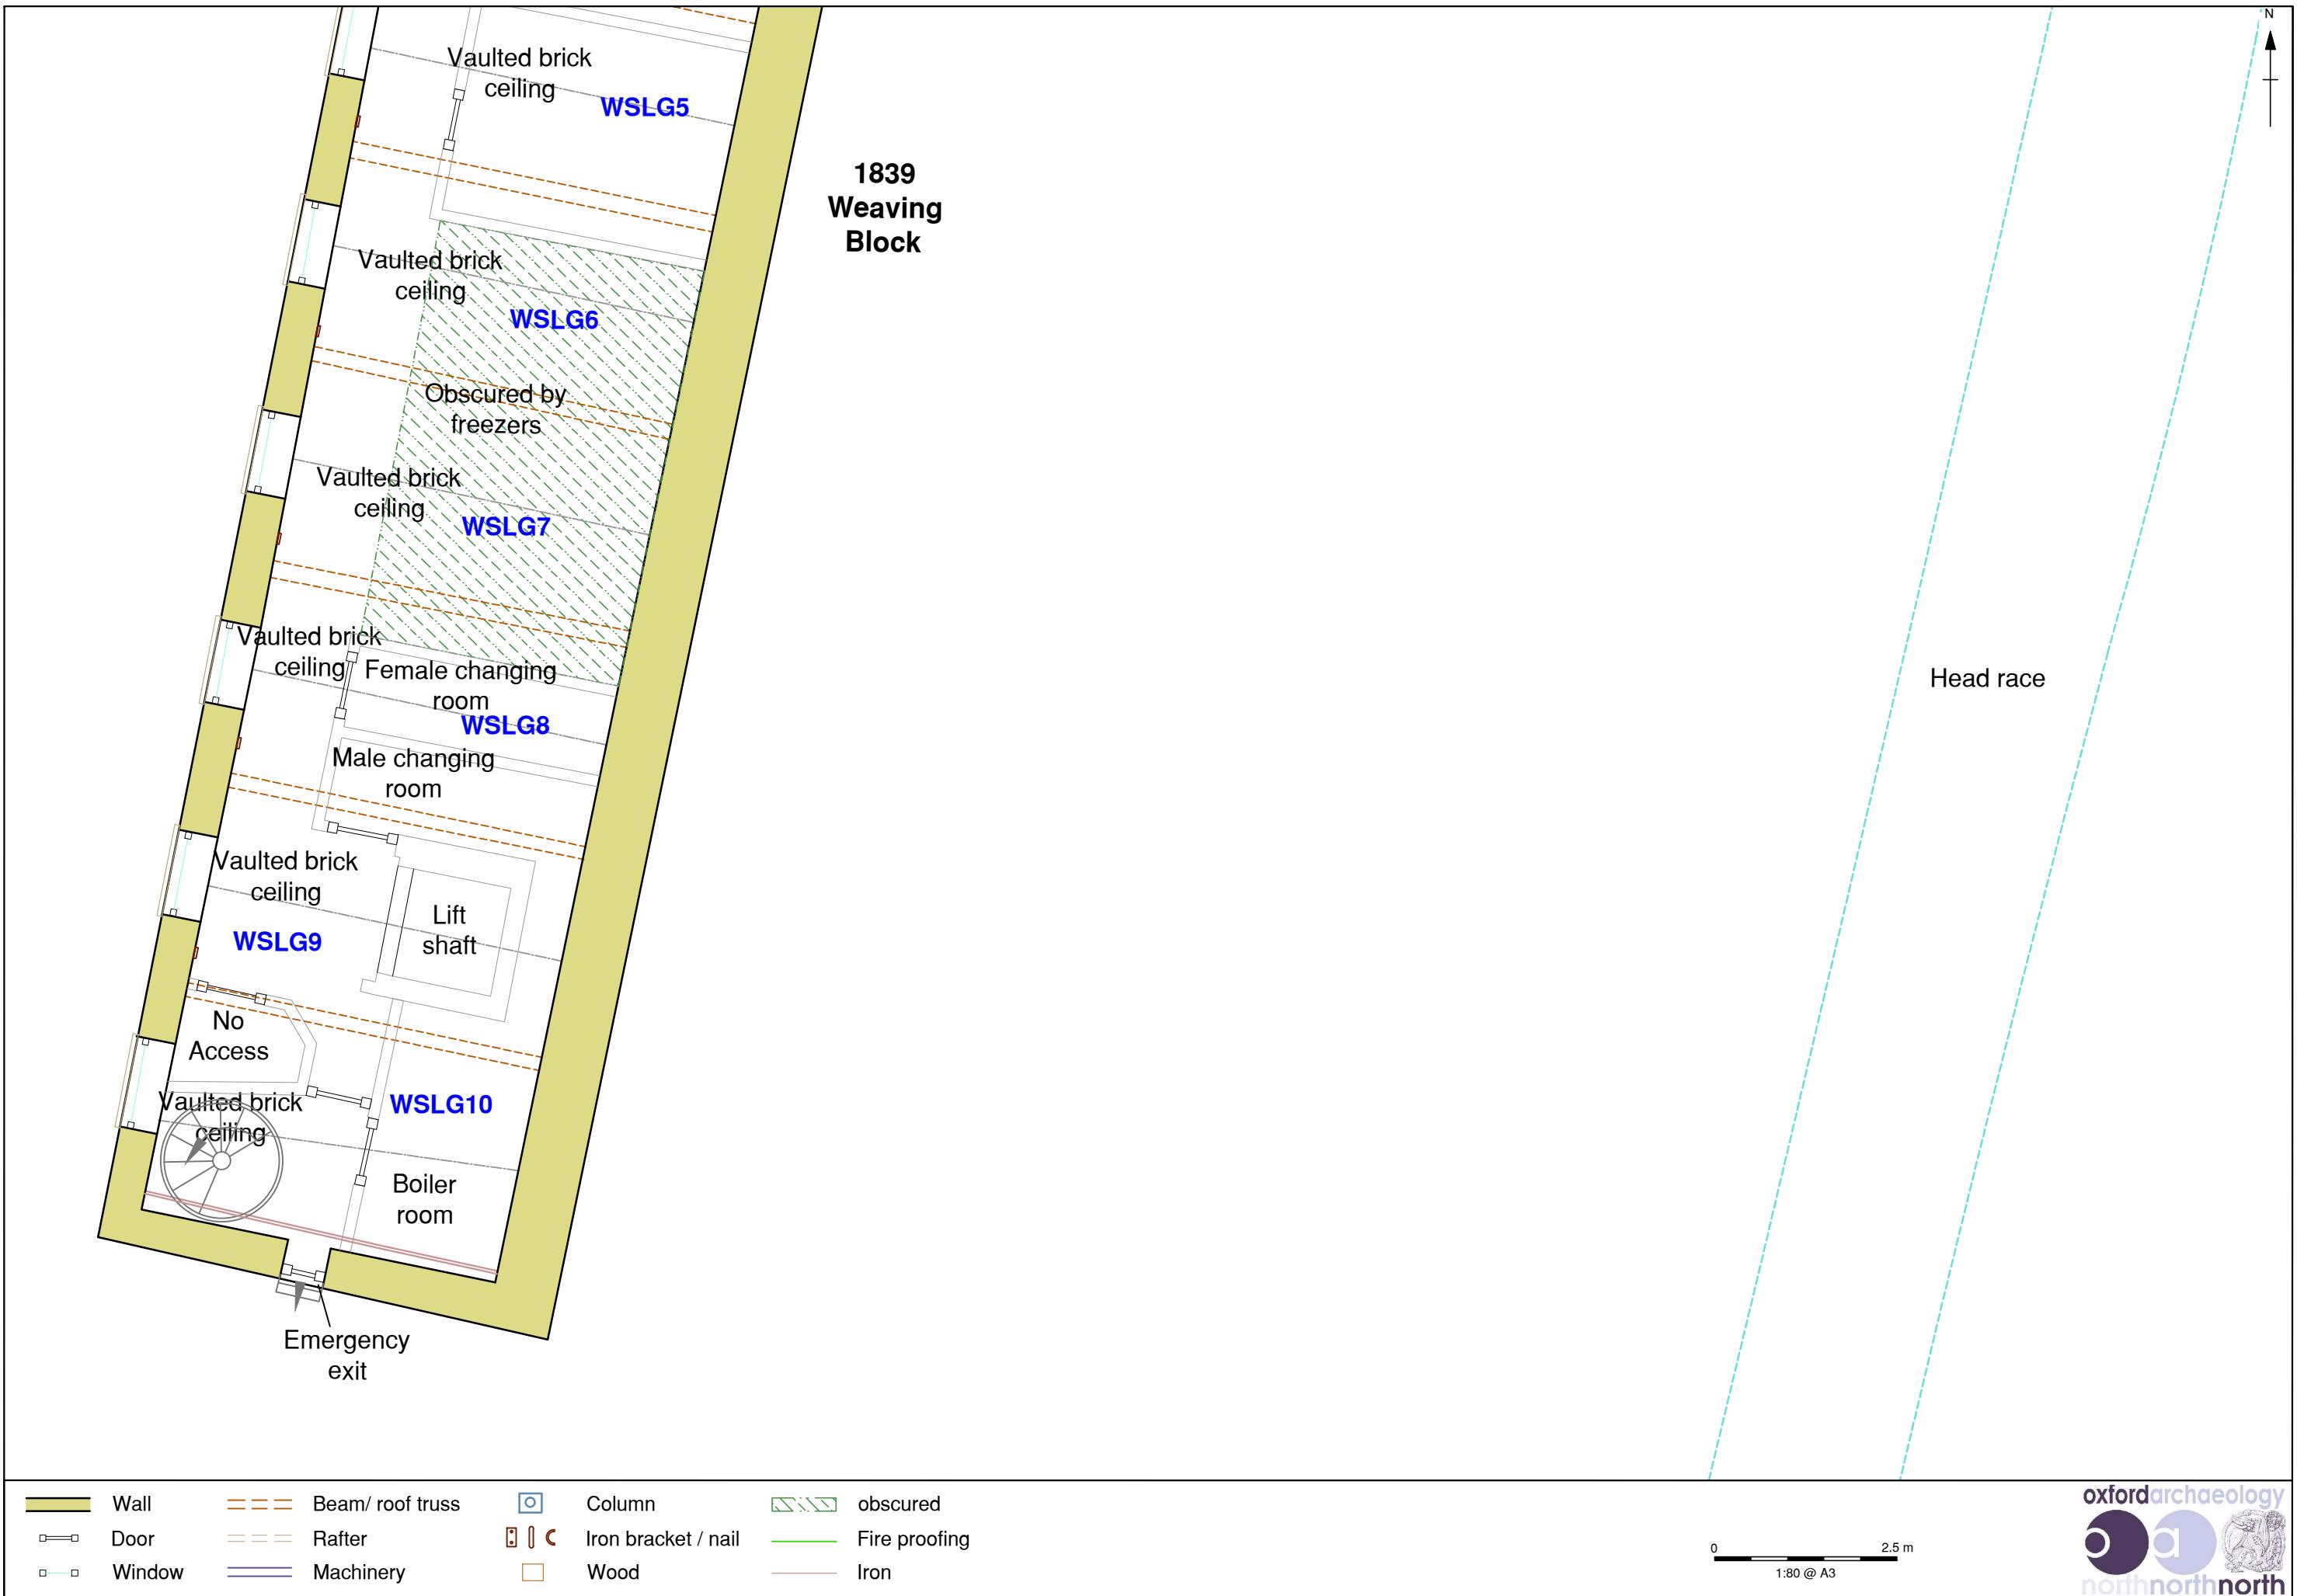


Figure 94: Topographic survey (north)



Figure 95: Quarry Bank Mill Overall Lower Ground Floor Plan



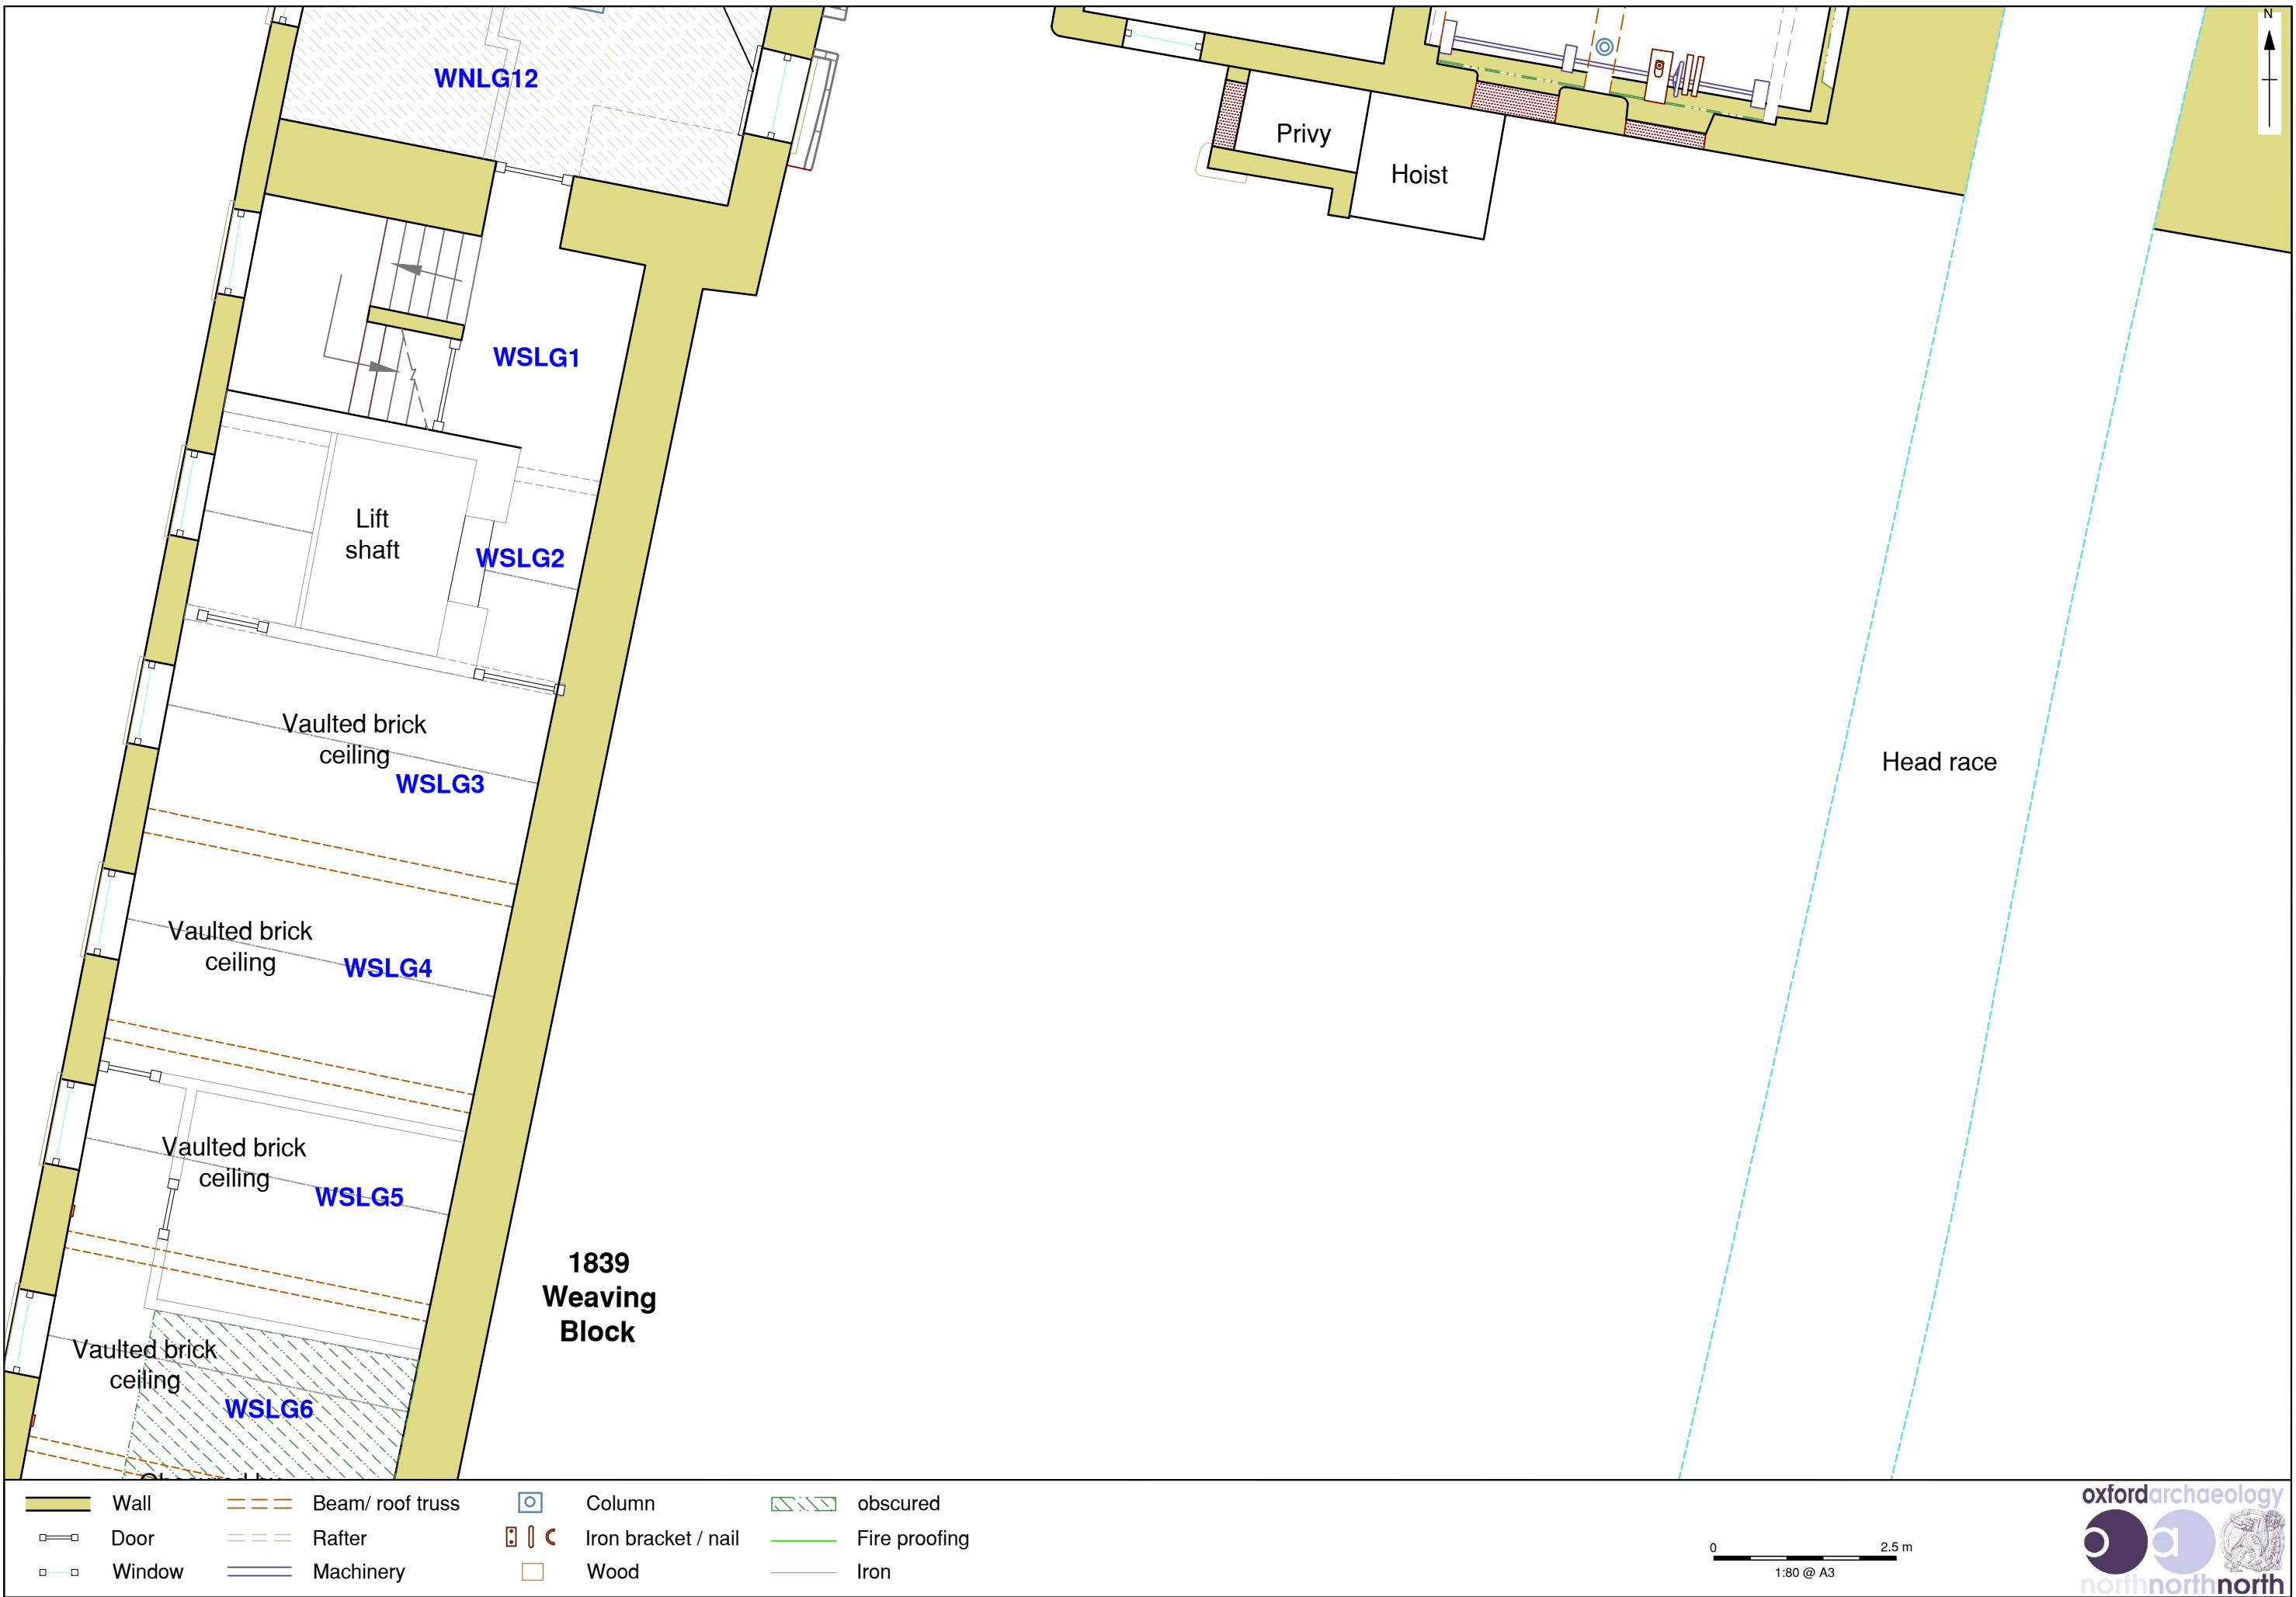


Figure 97: Lower Ground Floor - 1839 Weaving Block (North)-

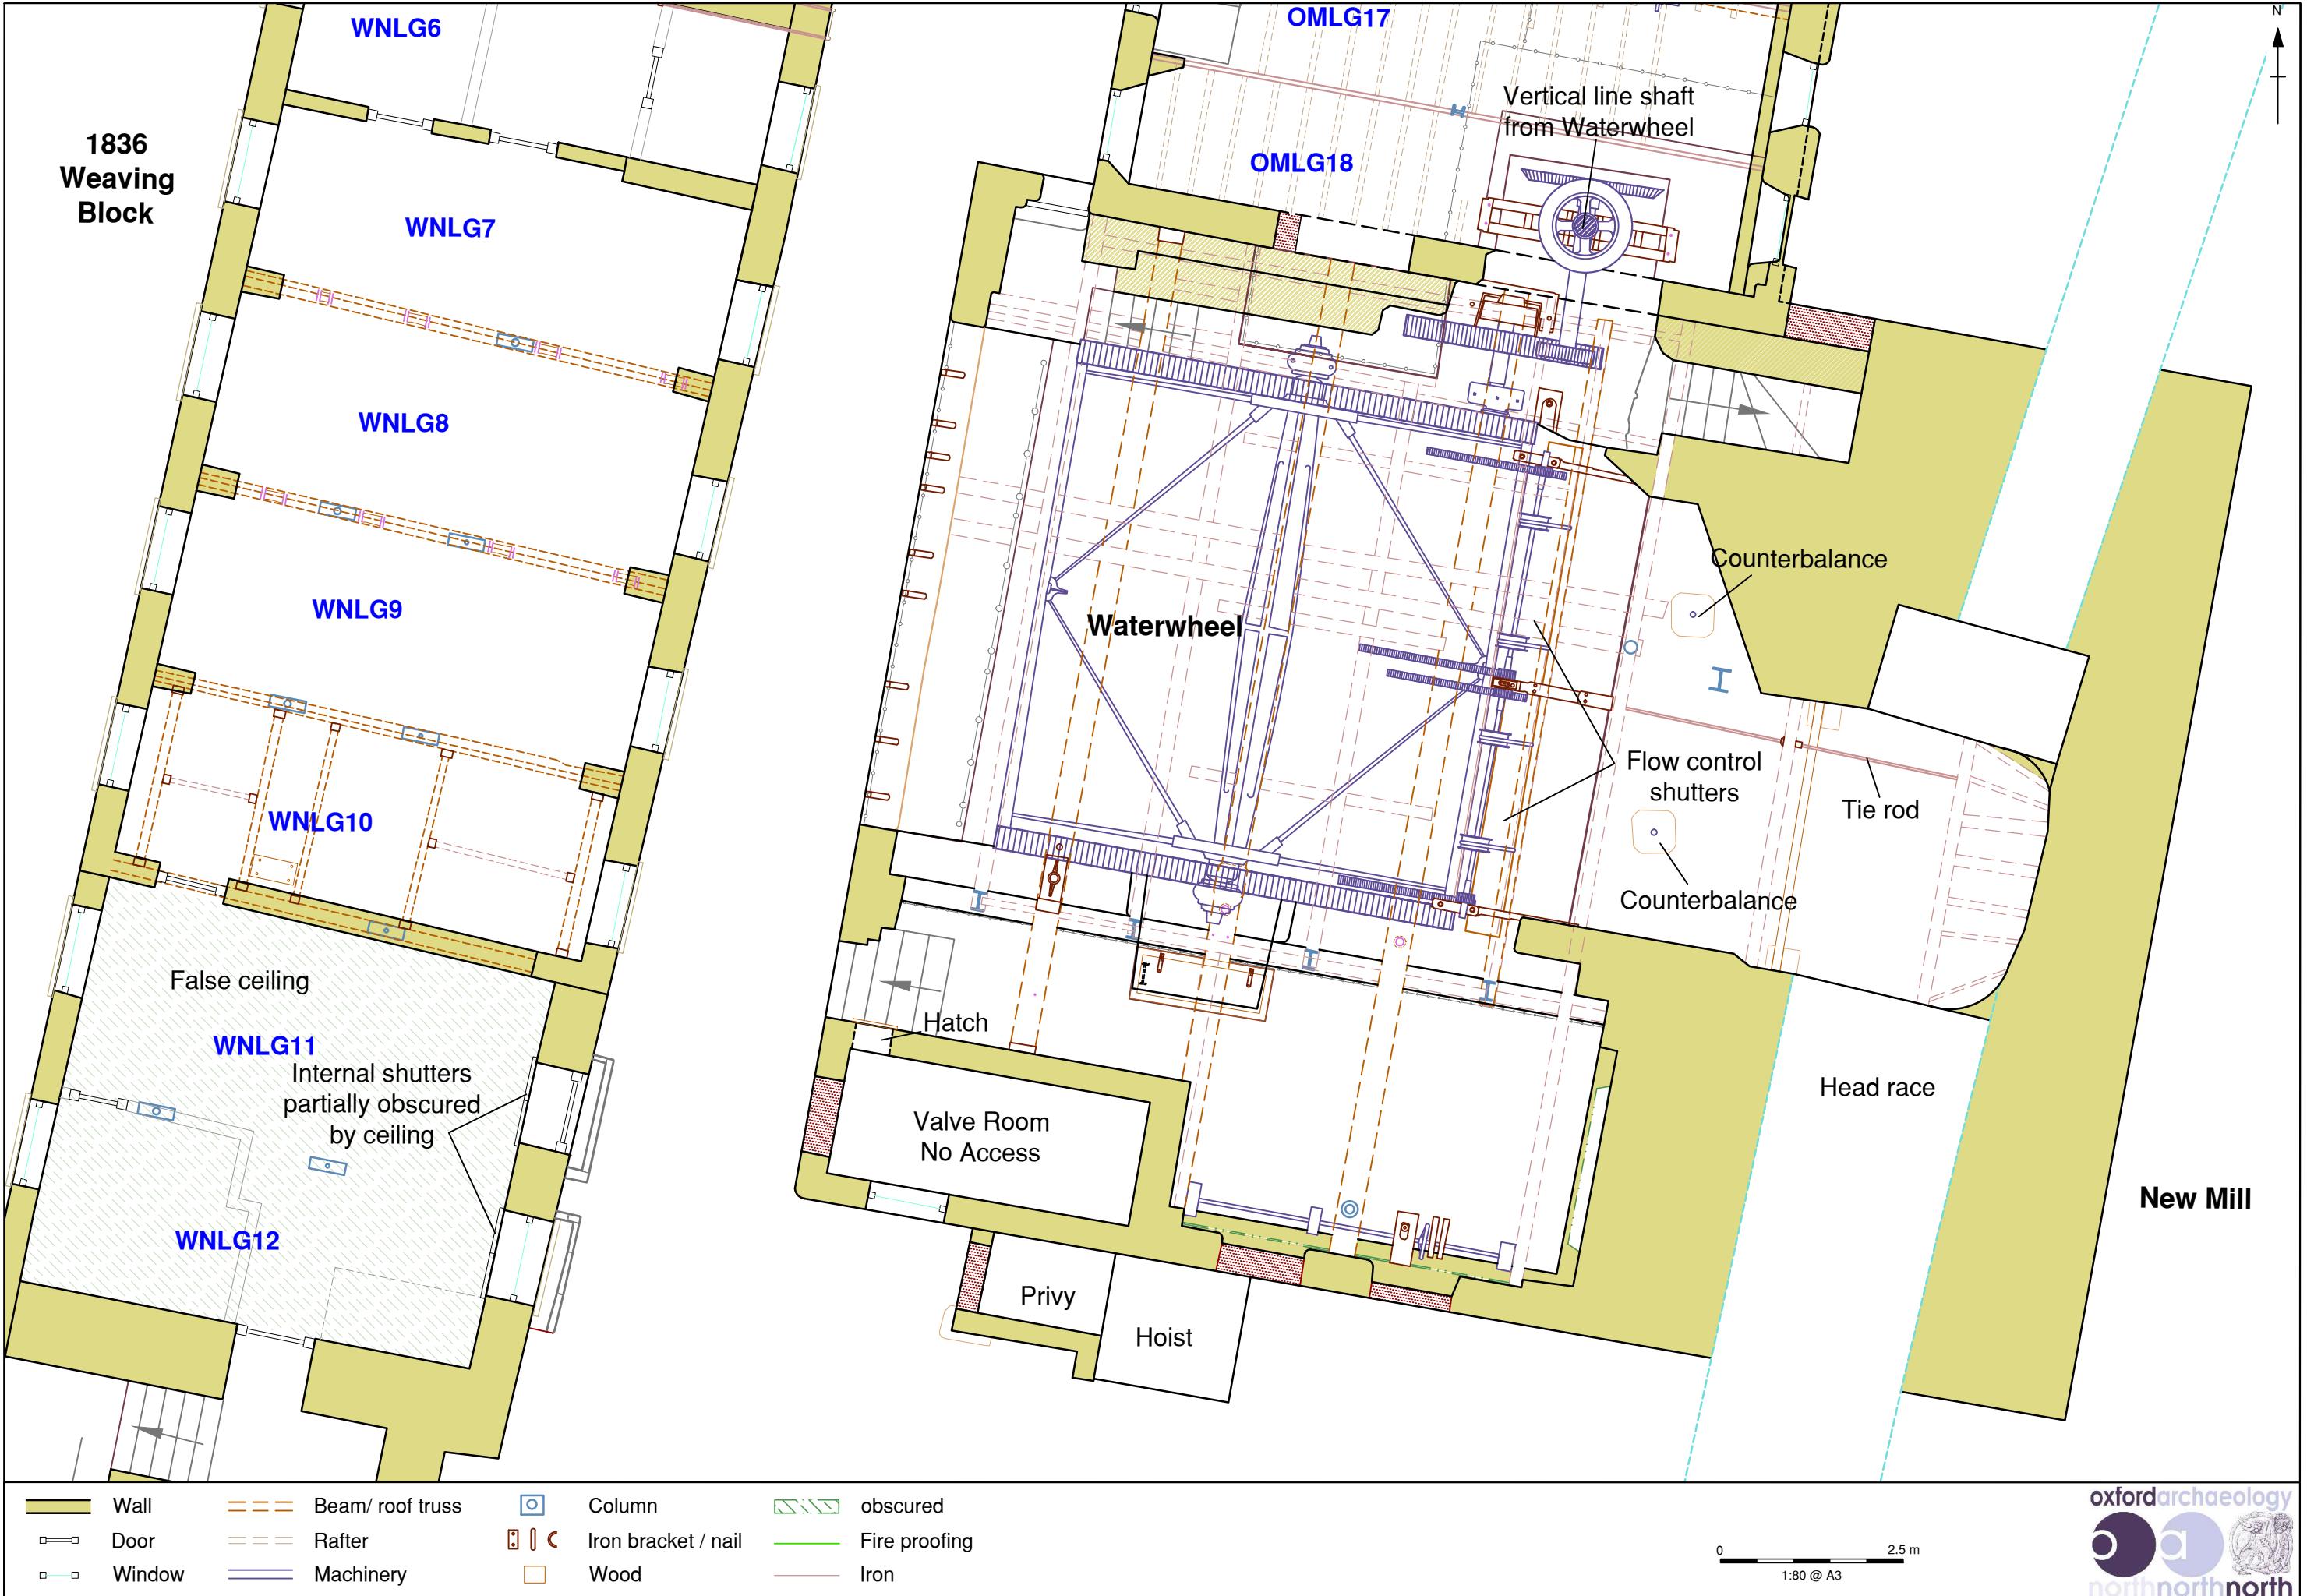


Figure 98: Lower Ground Floor - New Mill

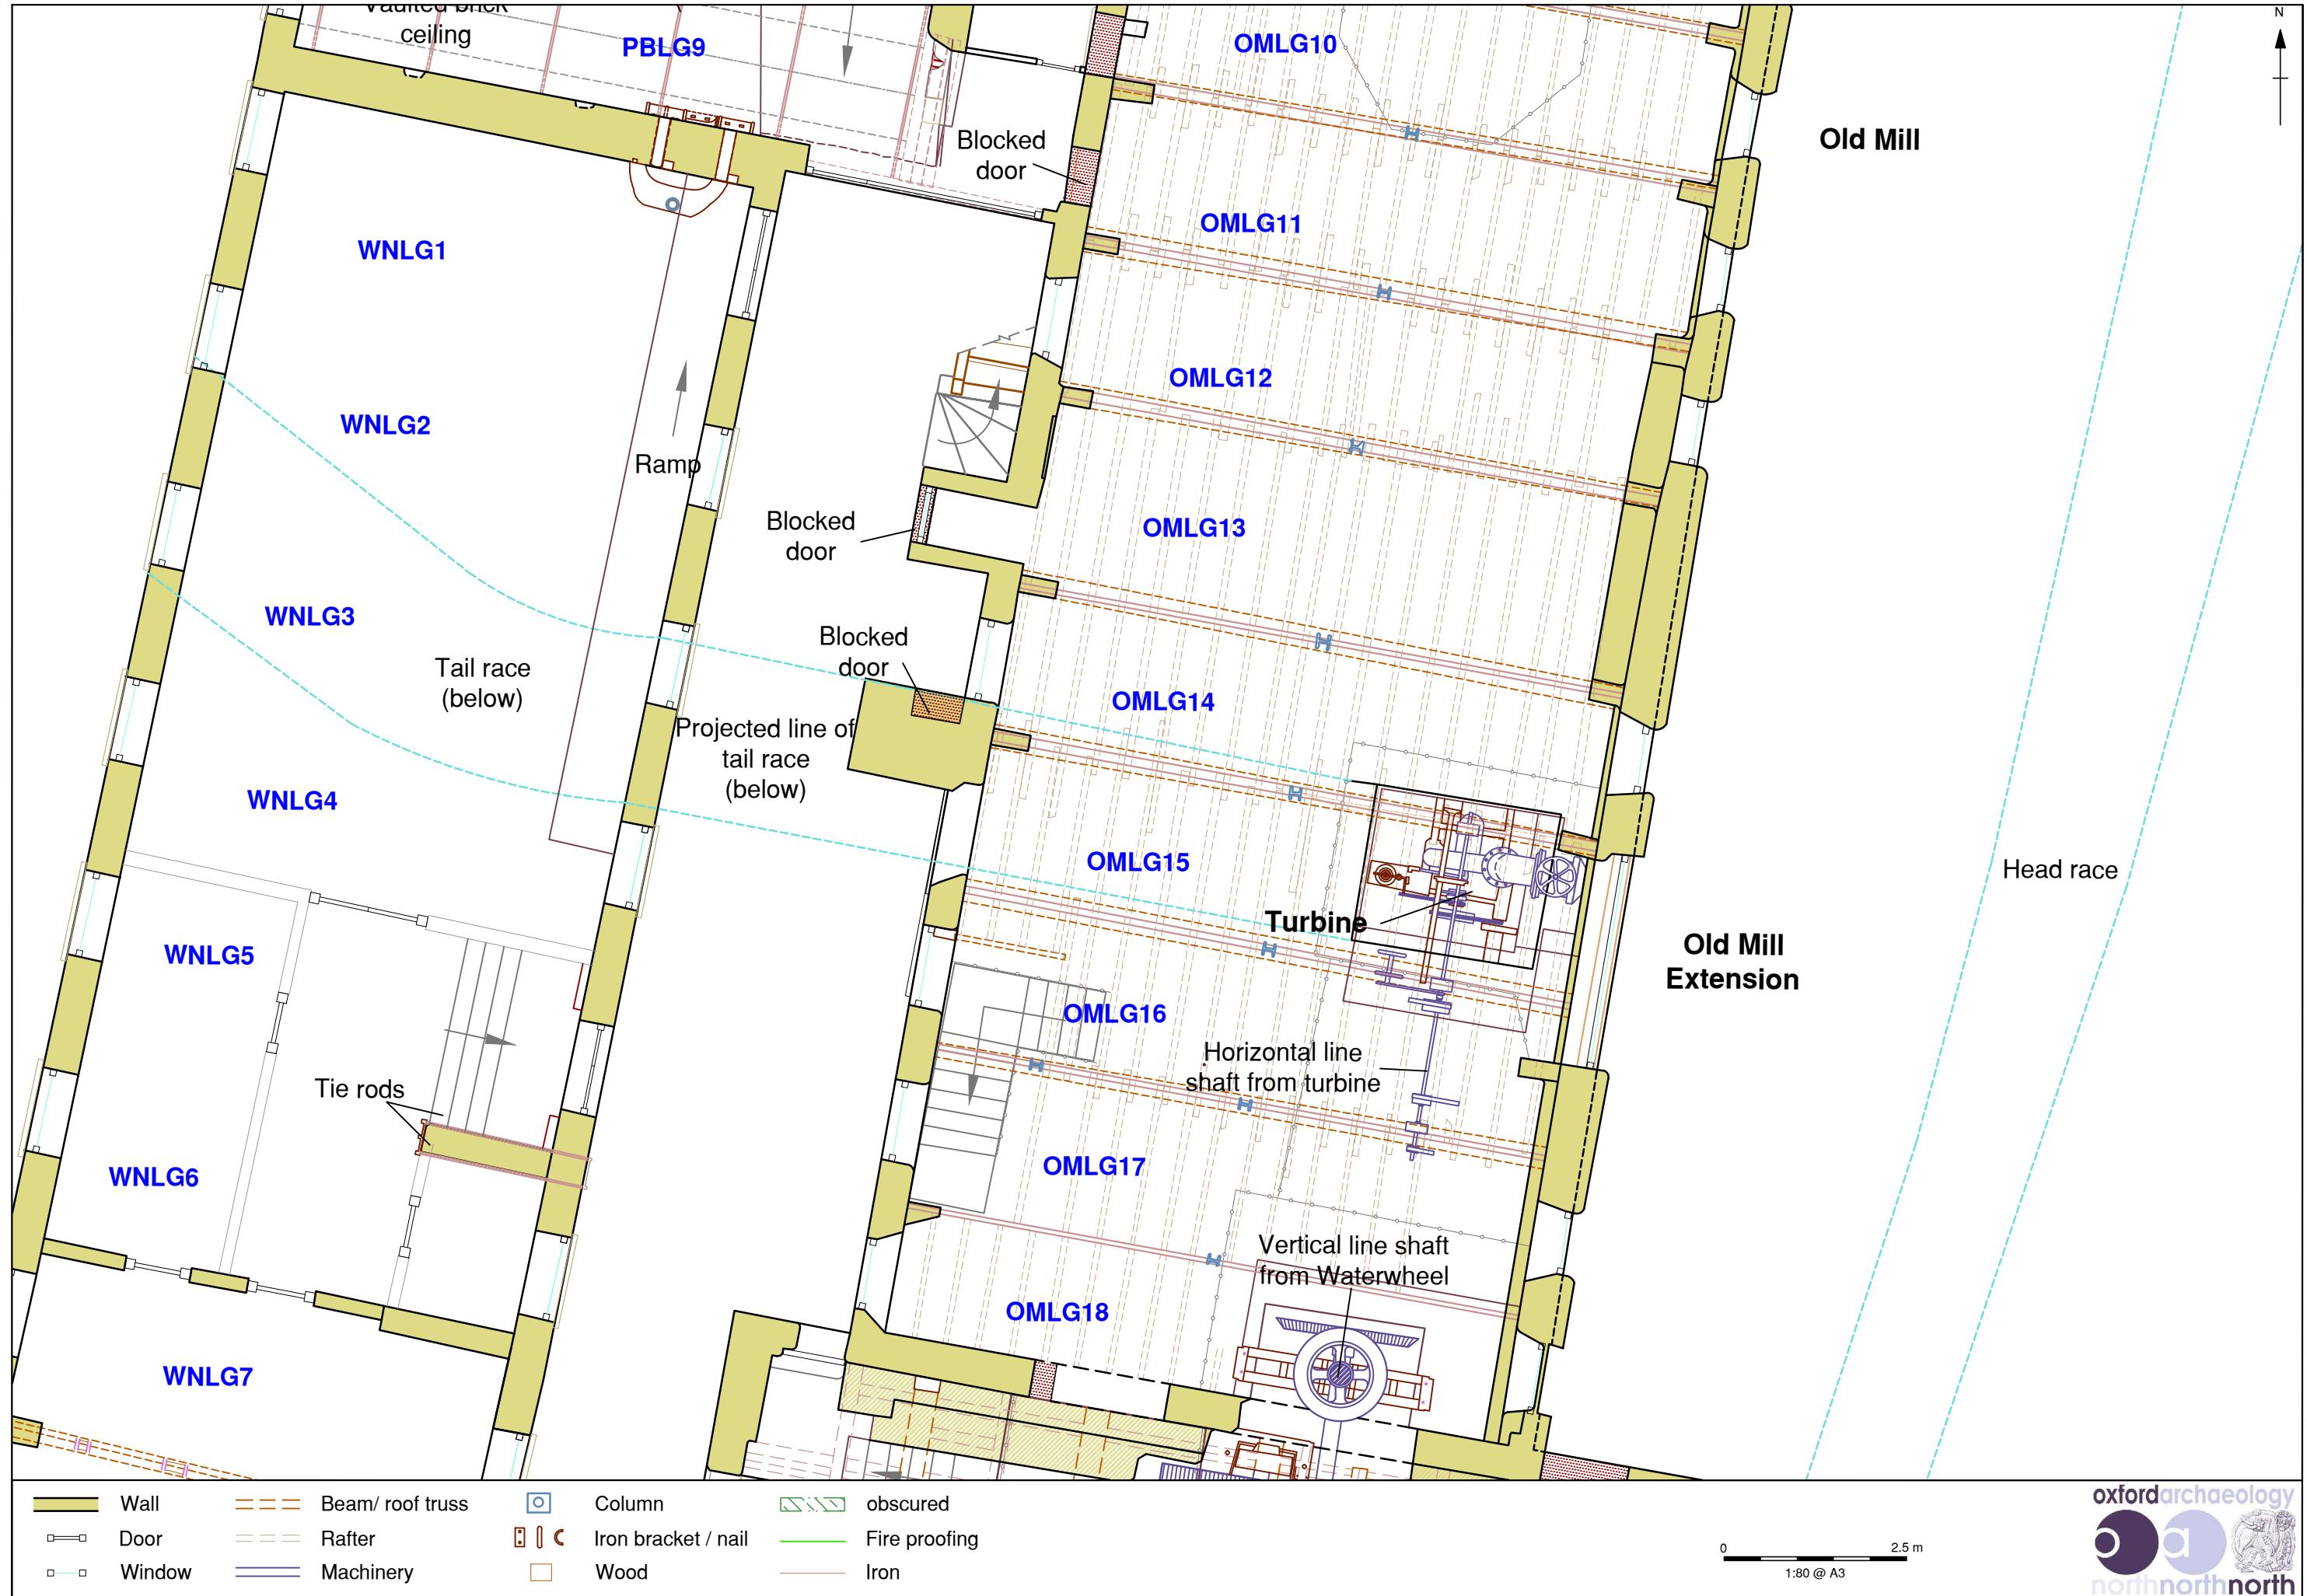


Figure 99: Lower Ground Floor - Old Mill Extension

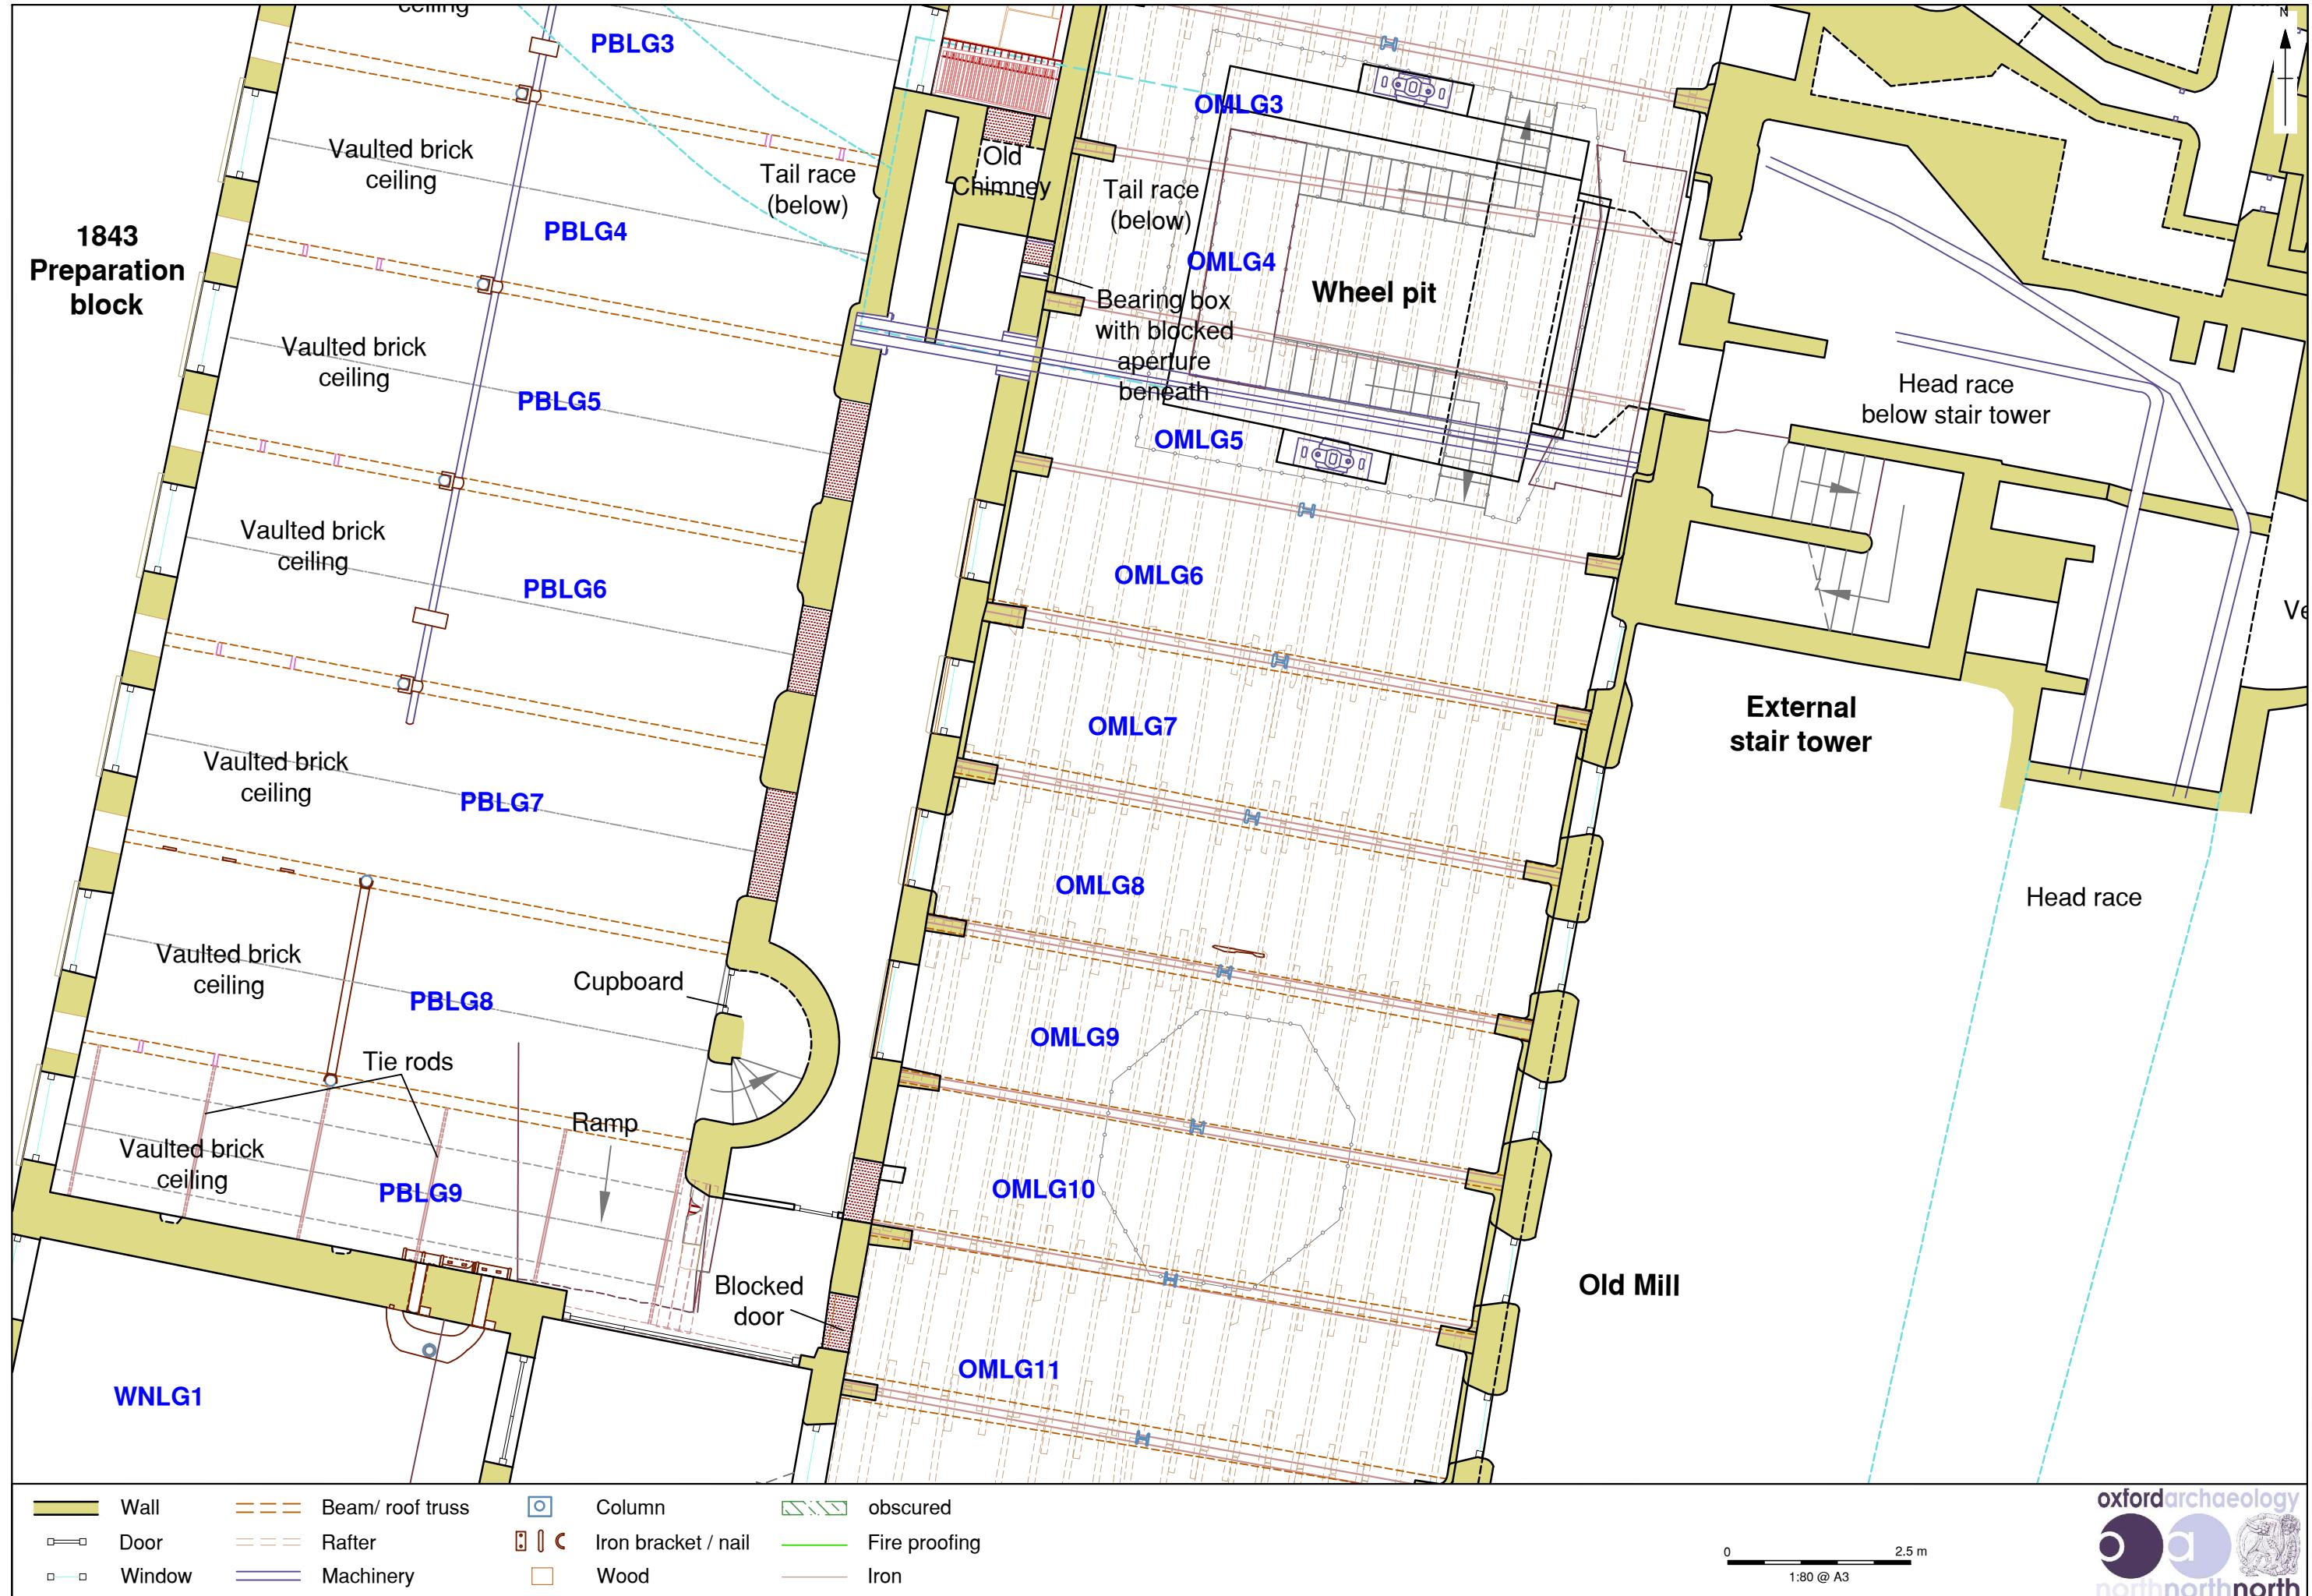
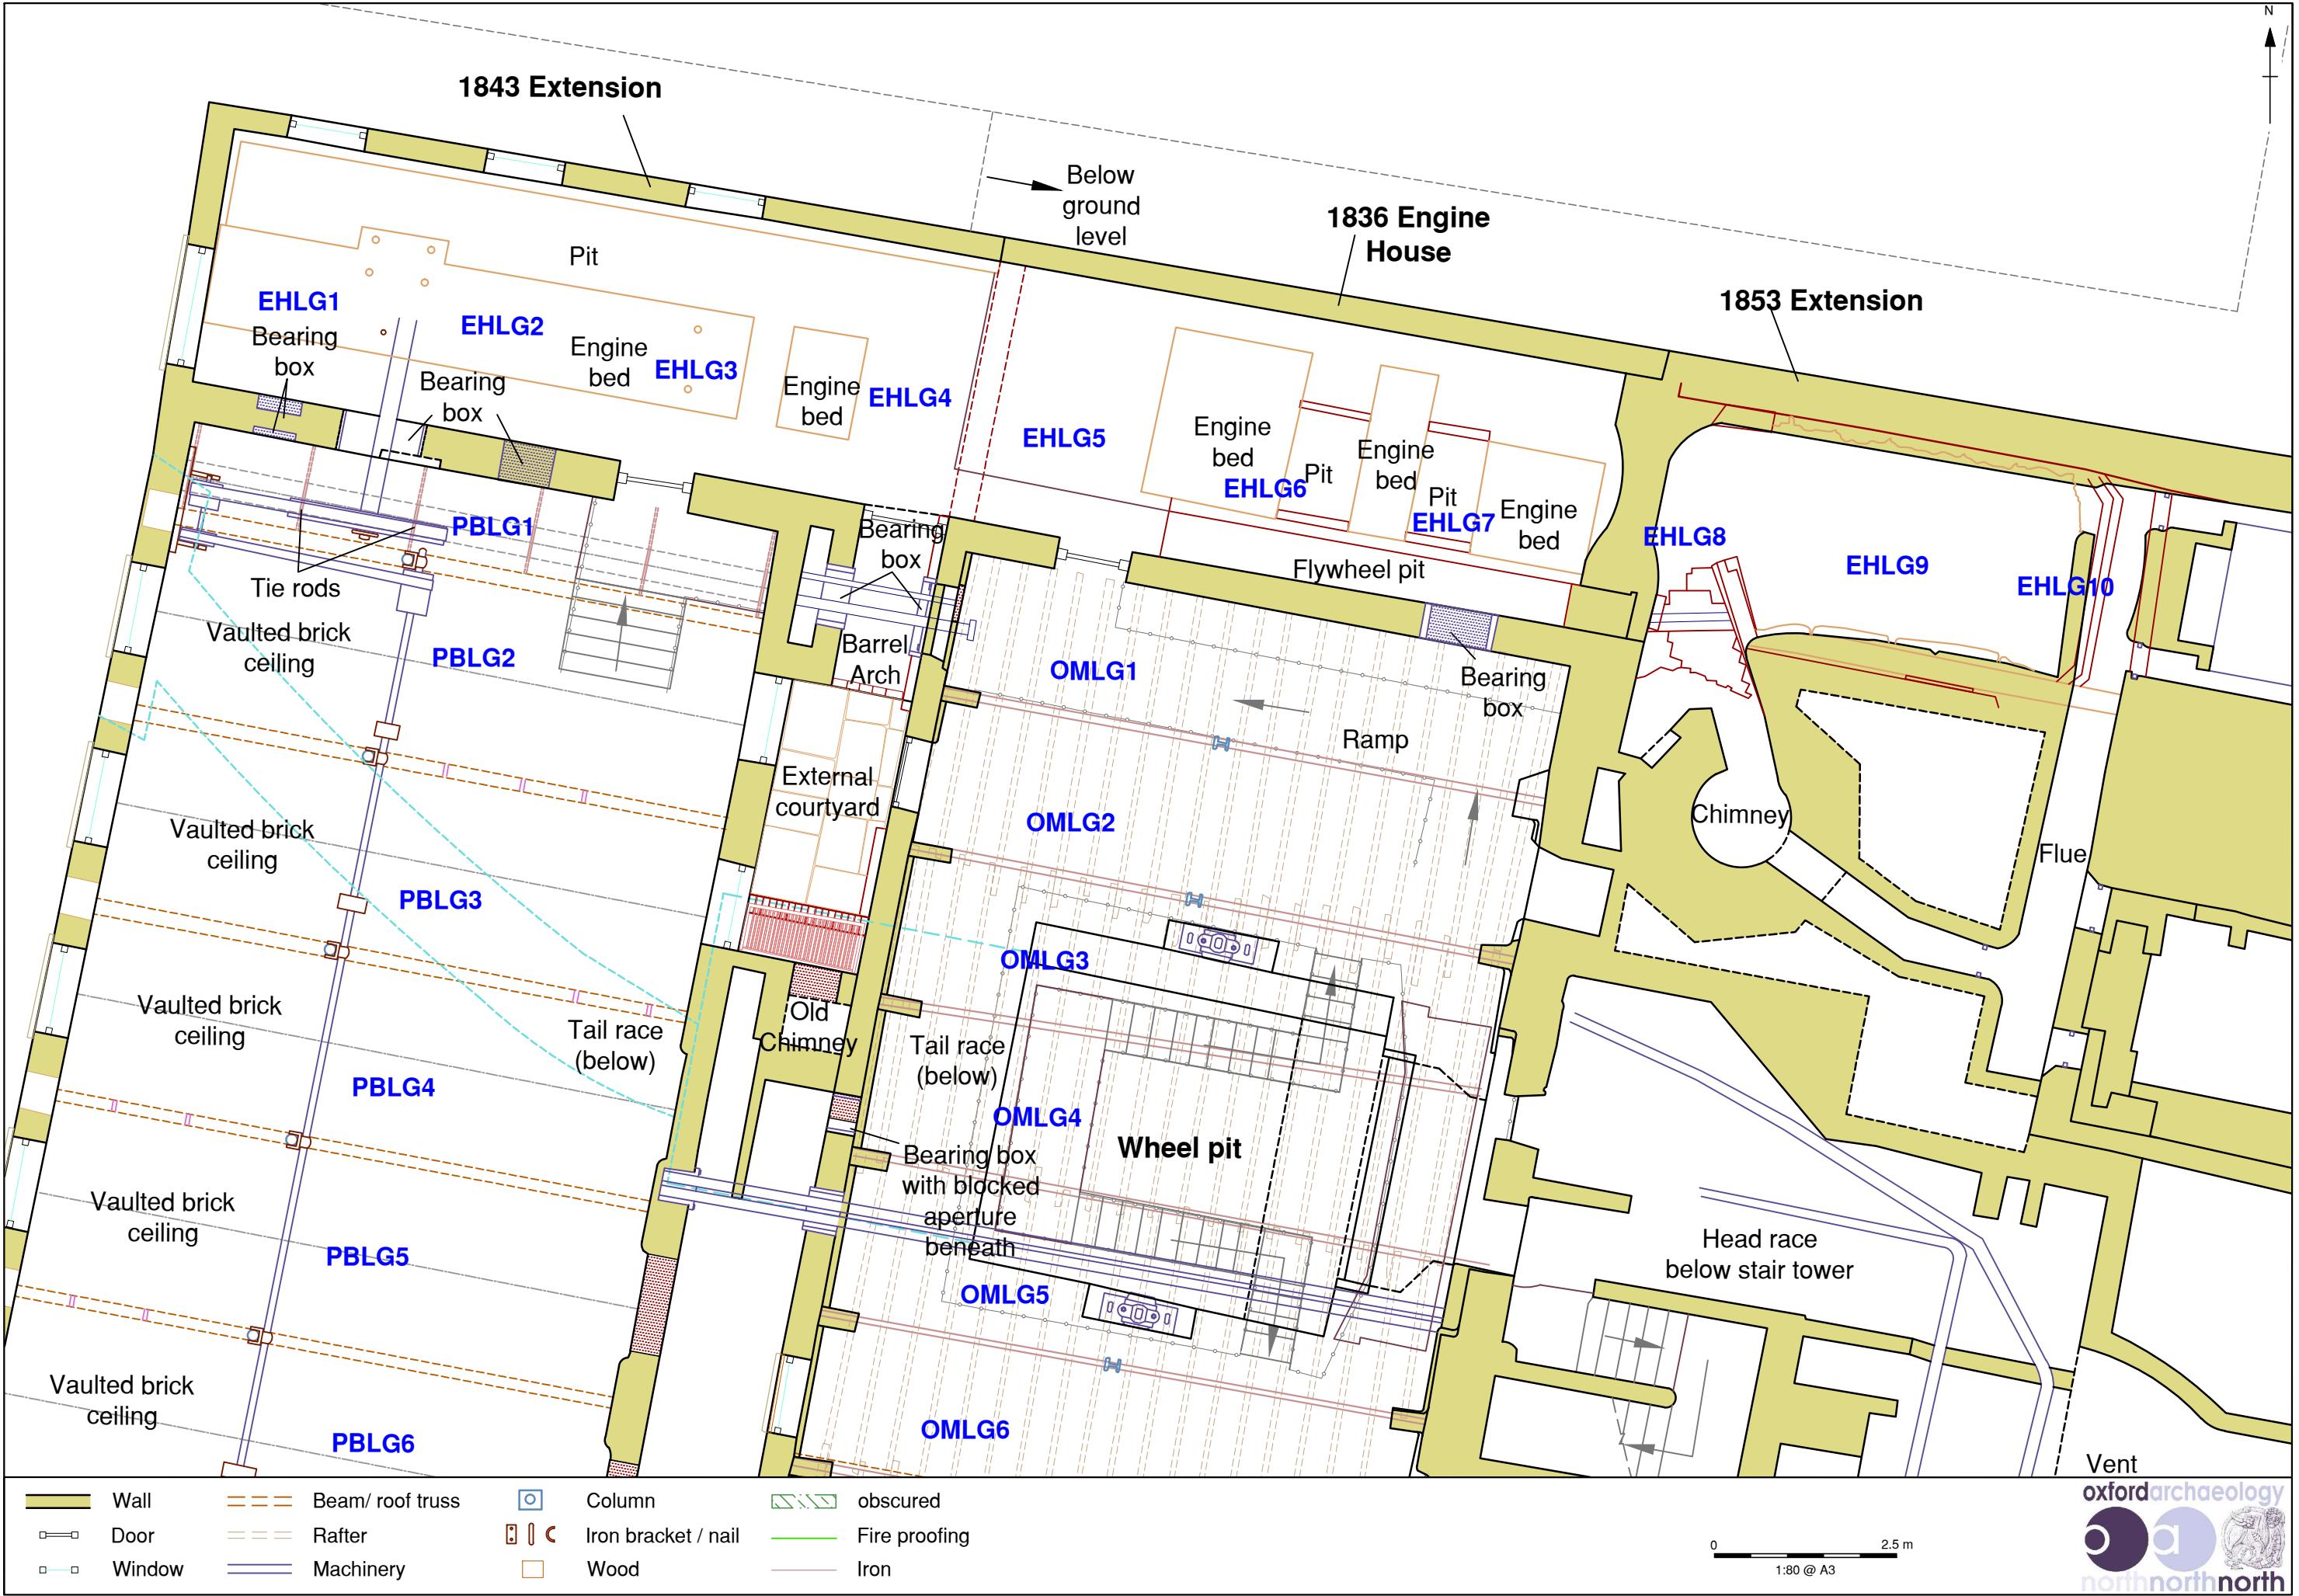


Figure 100: Lower Ground Floor - Old Mill and 1843 Preparation Block



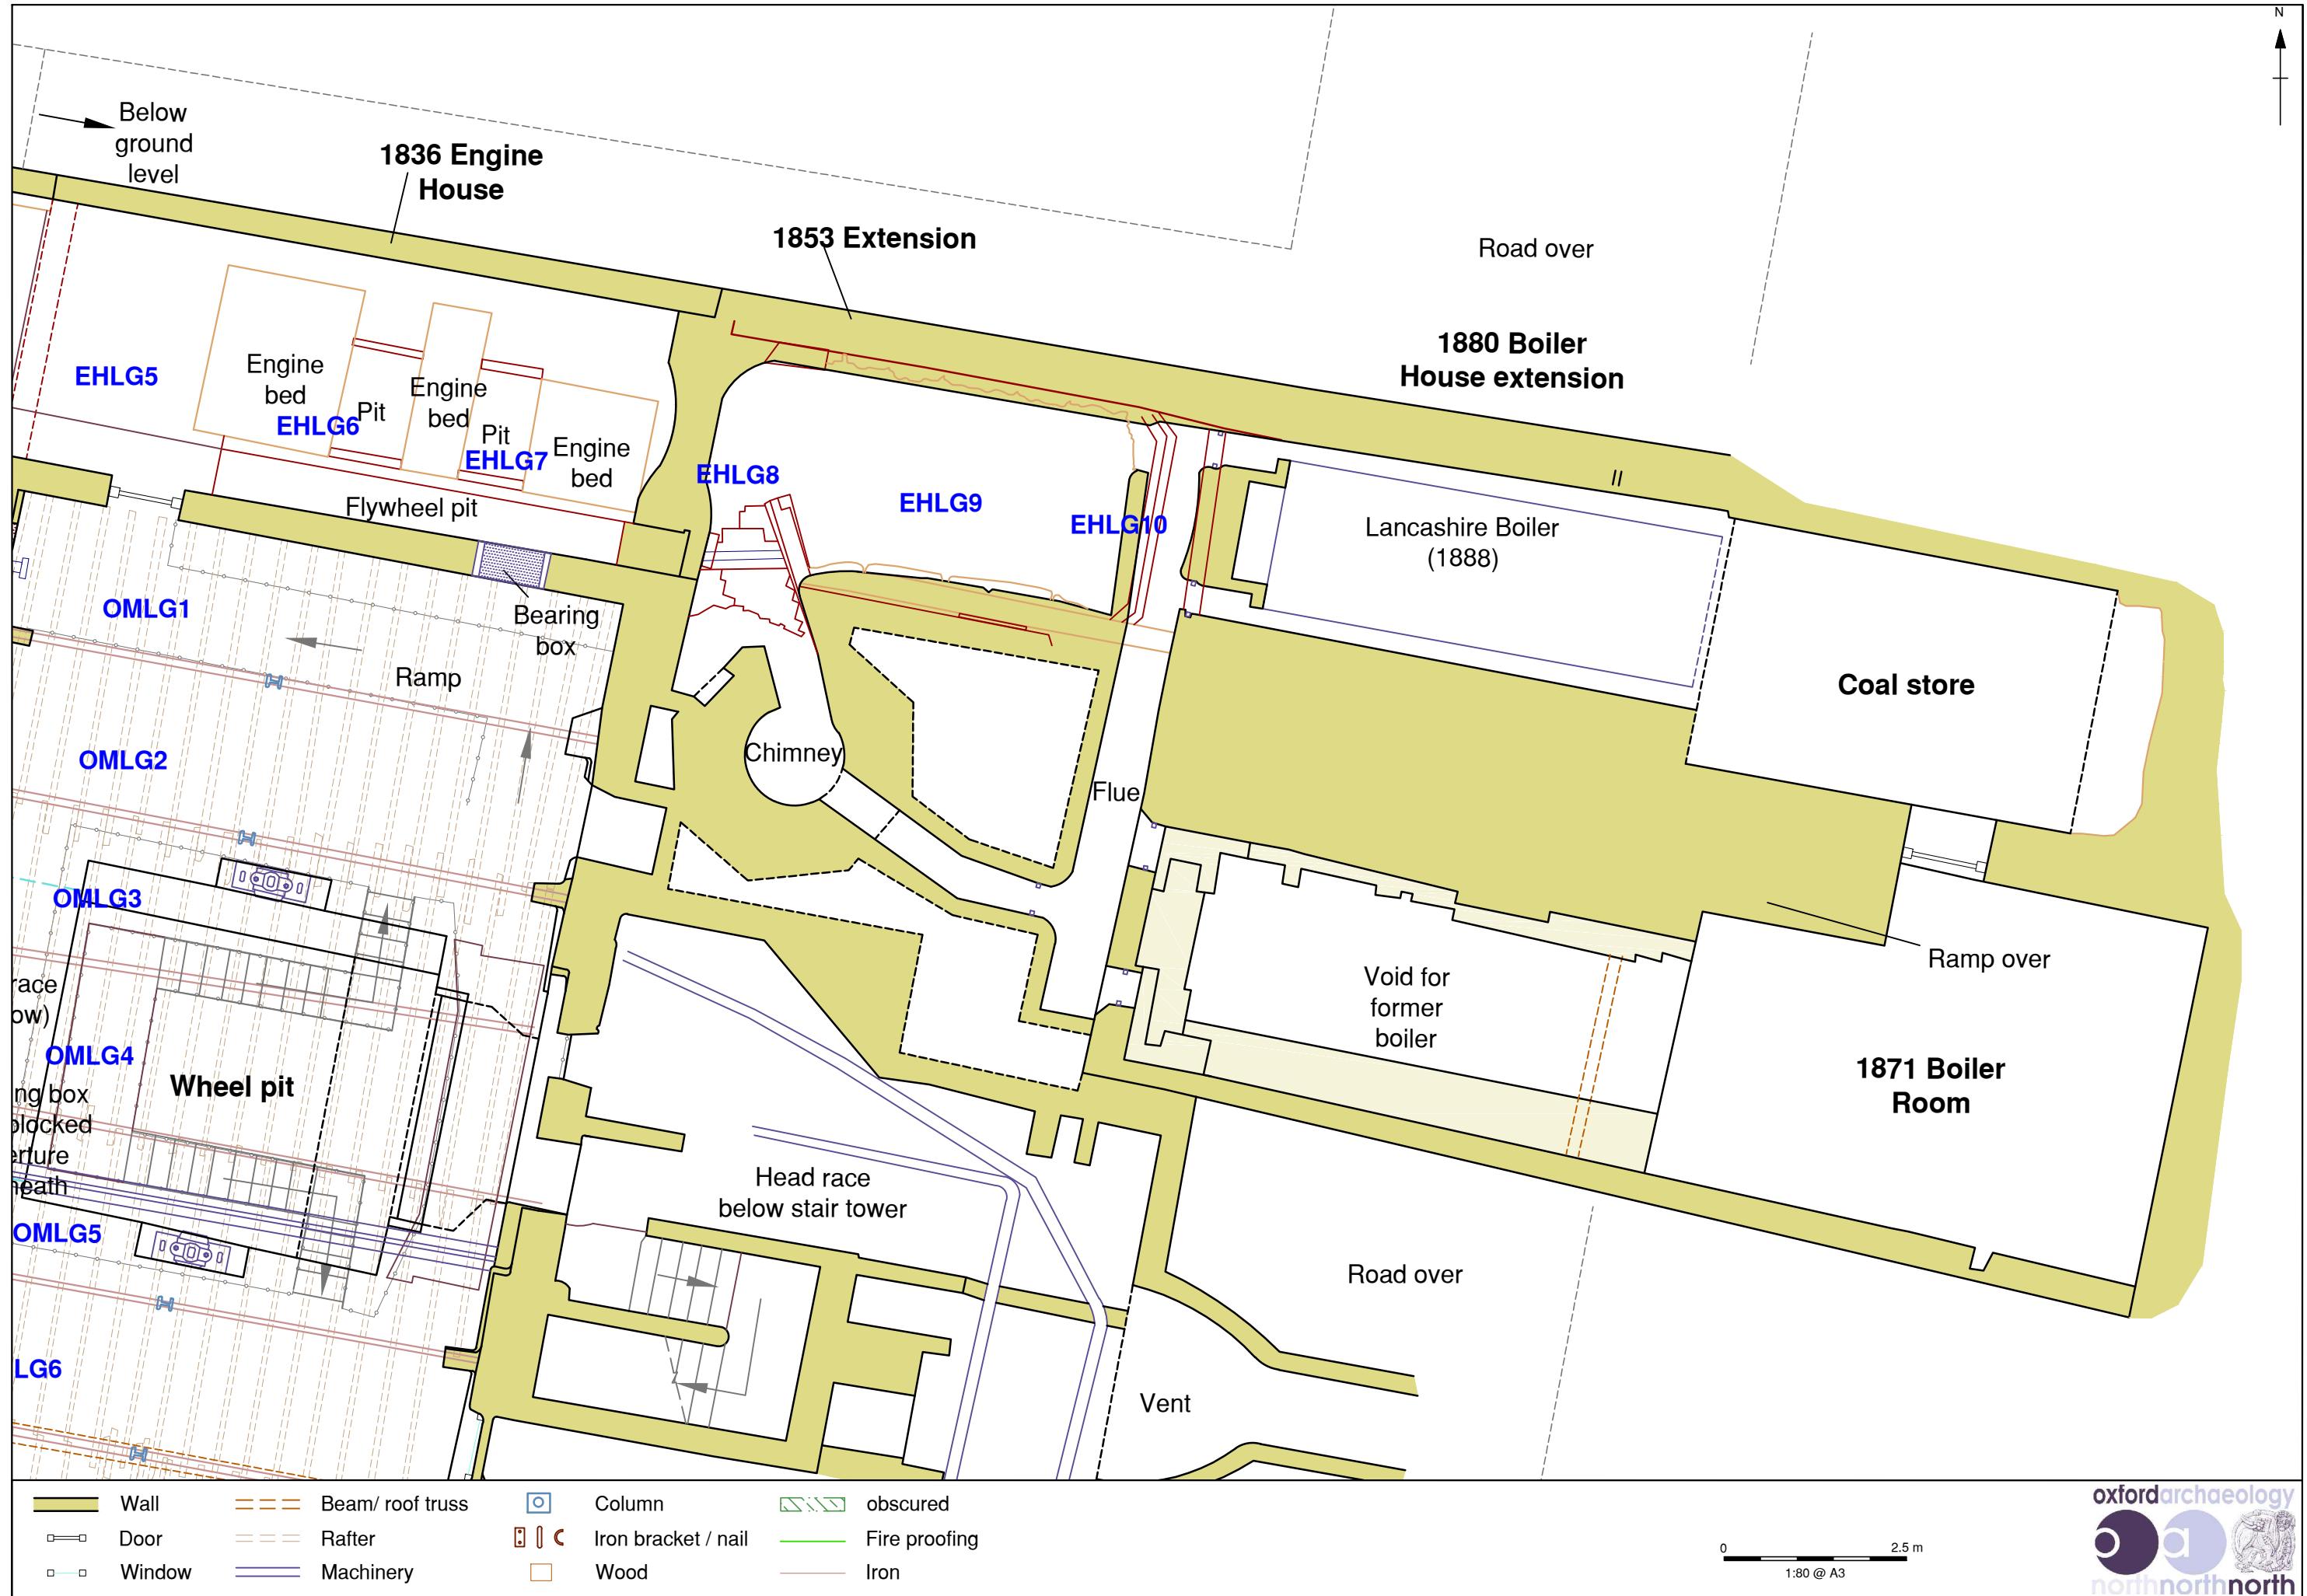


Figure 102: Lower Ground Floor - Engine House



Figure 103: Quarry Bank Mill Overall Ground Floor Plan

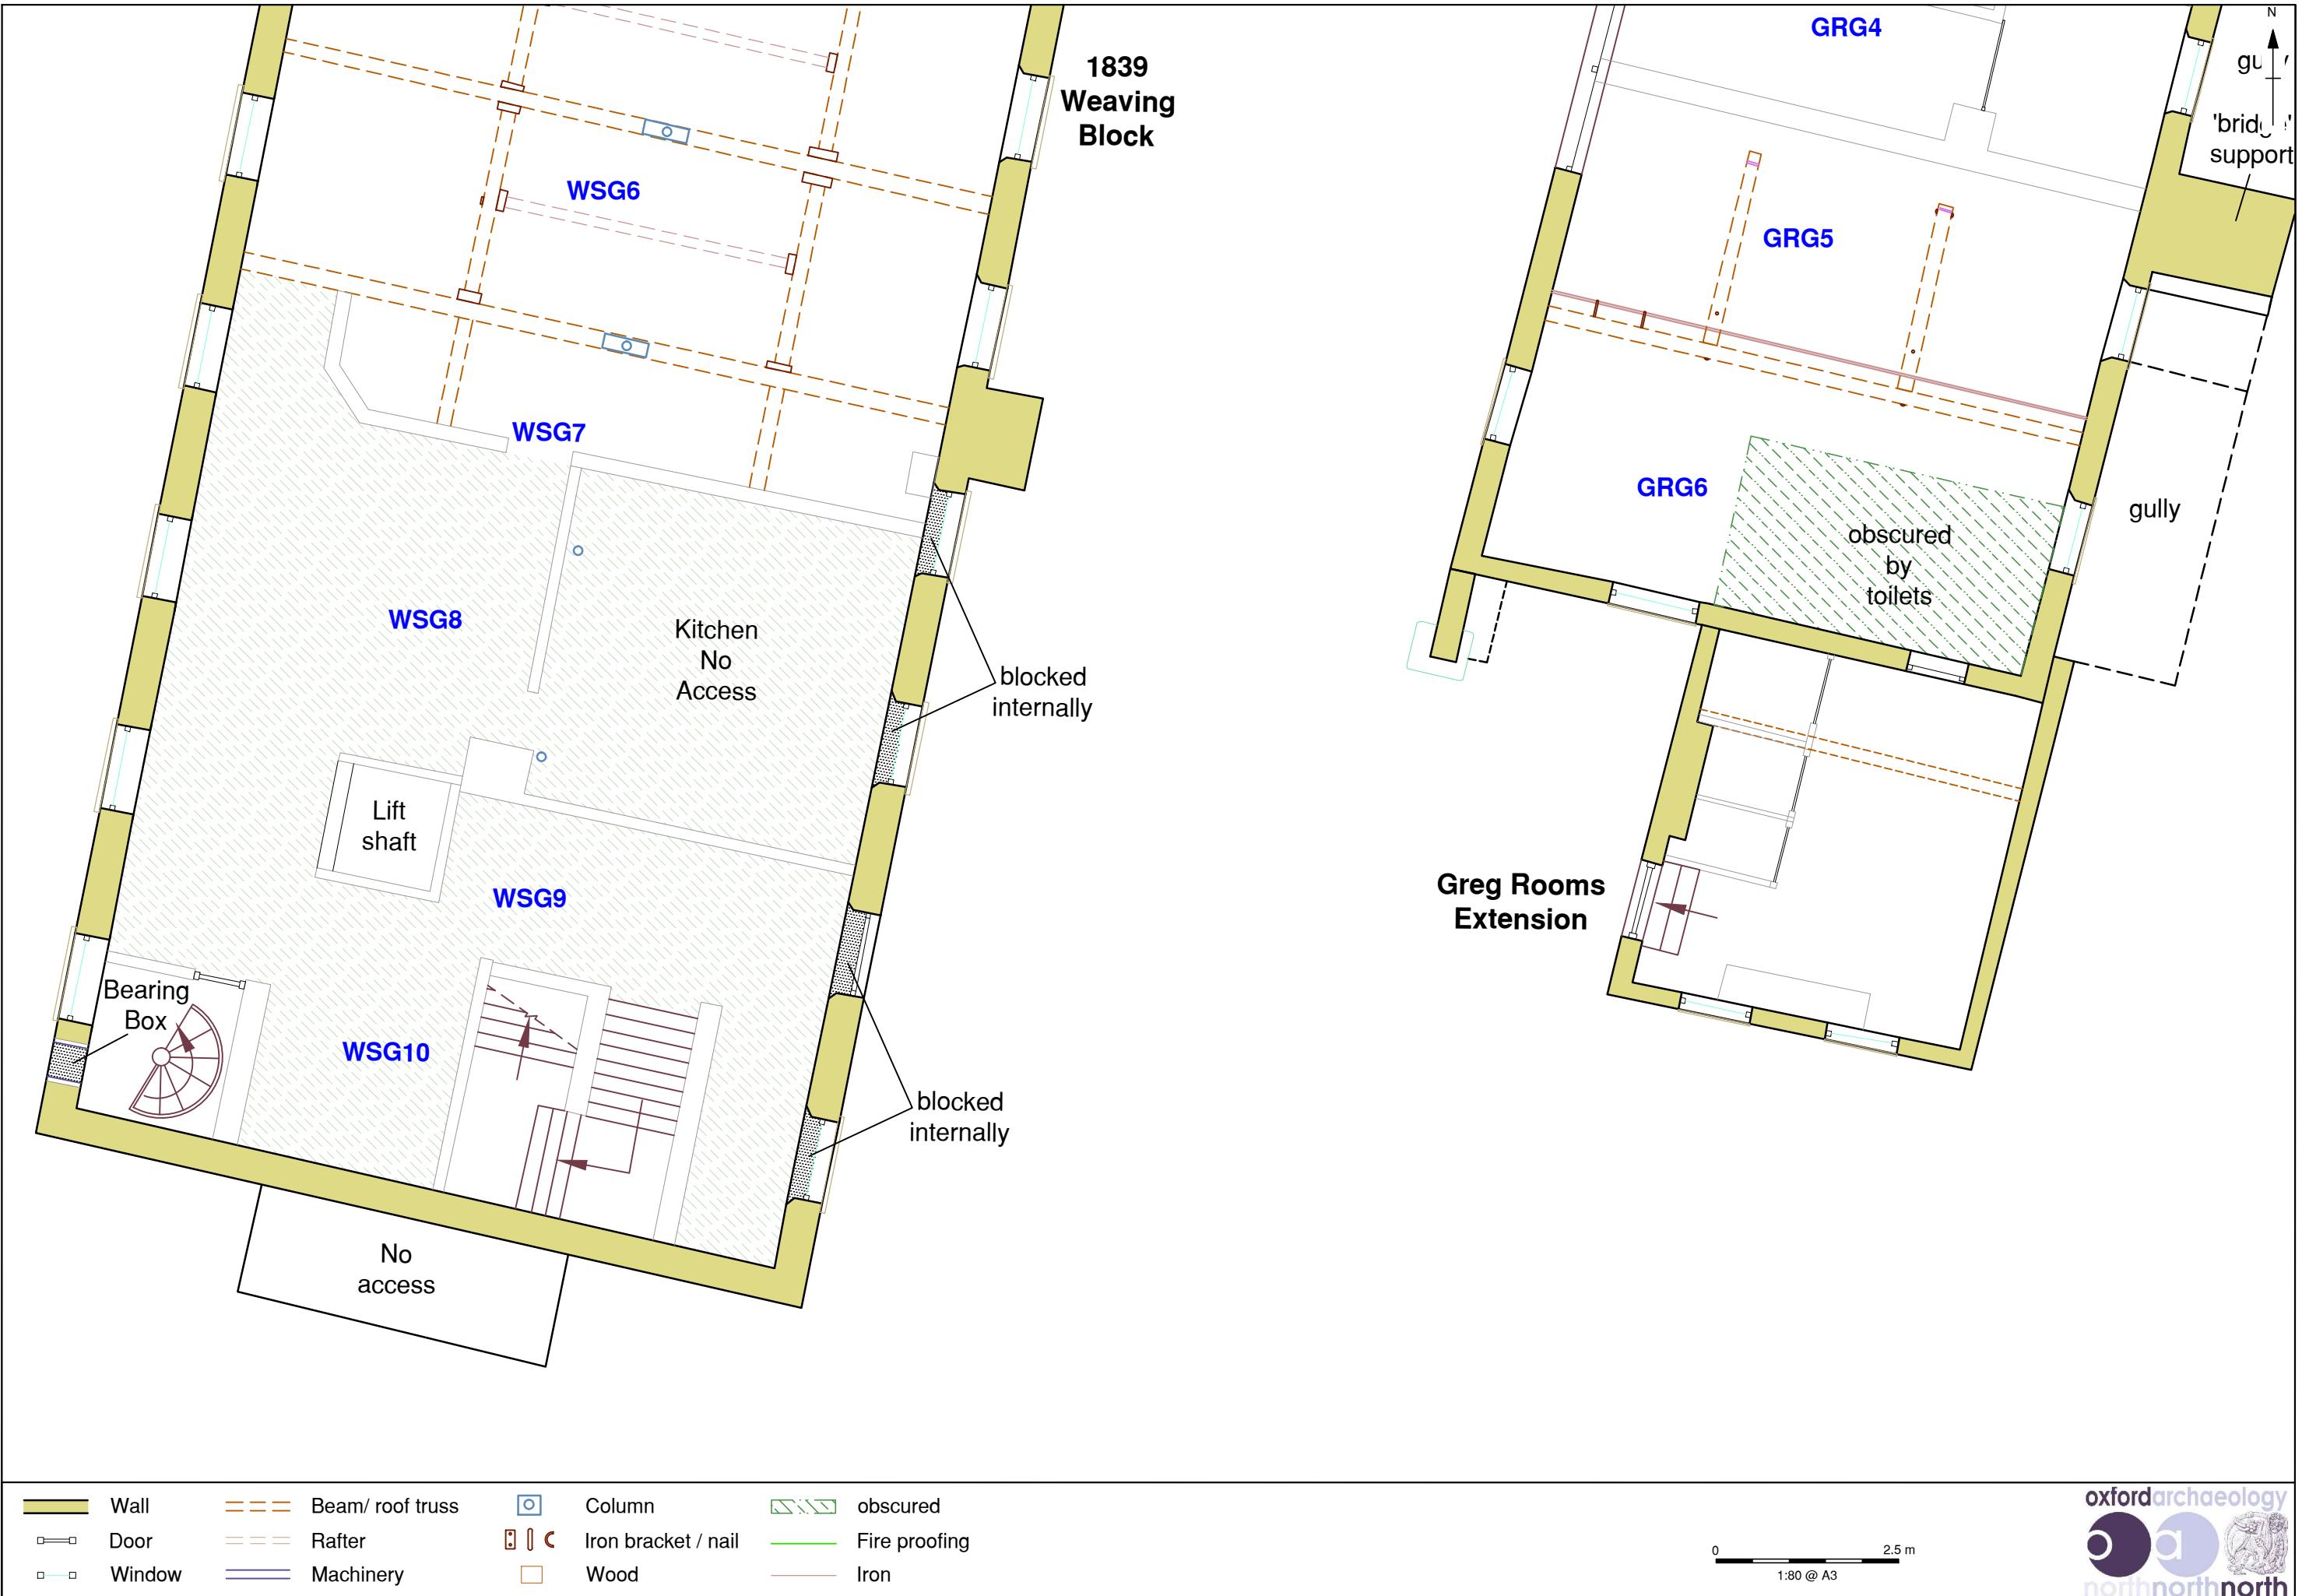
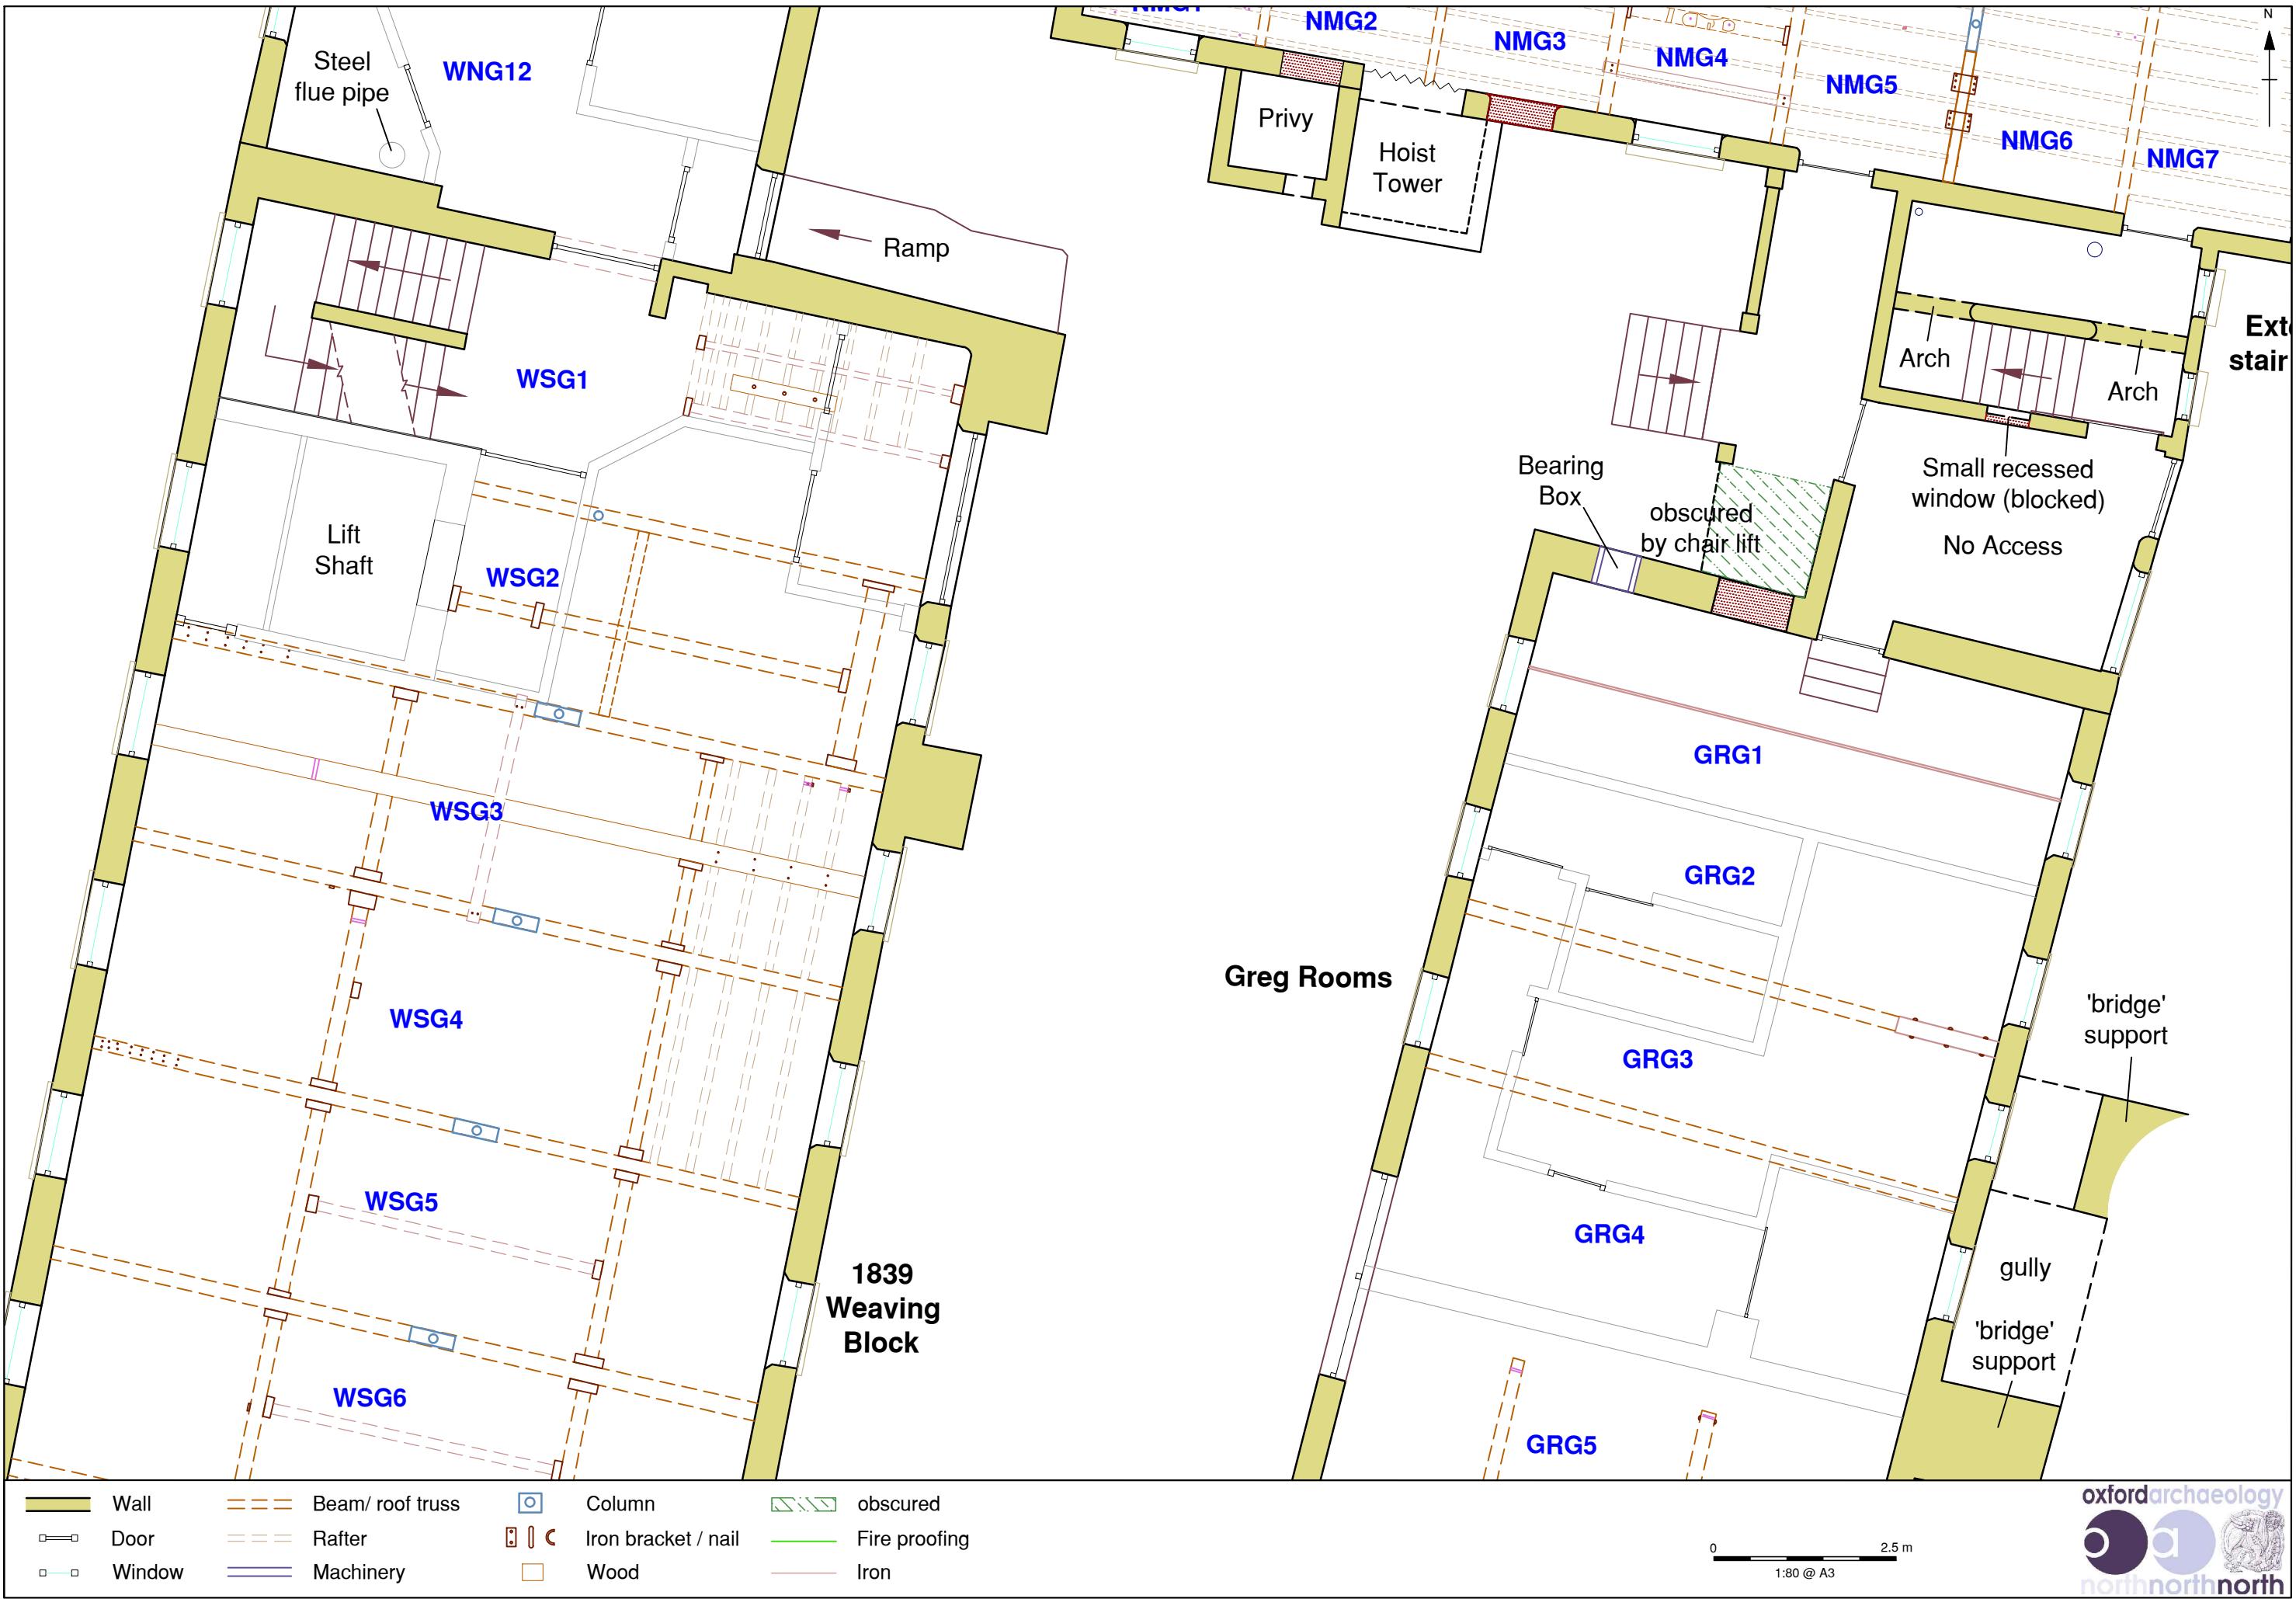


Figure 104: Ground Floor - 1939 Weaving Block and Greg Rooms (South)



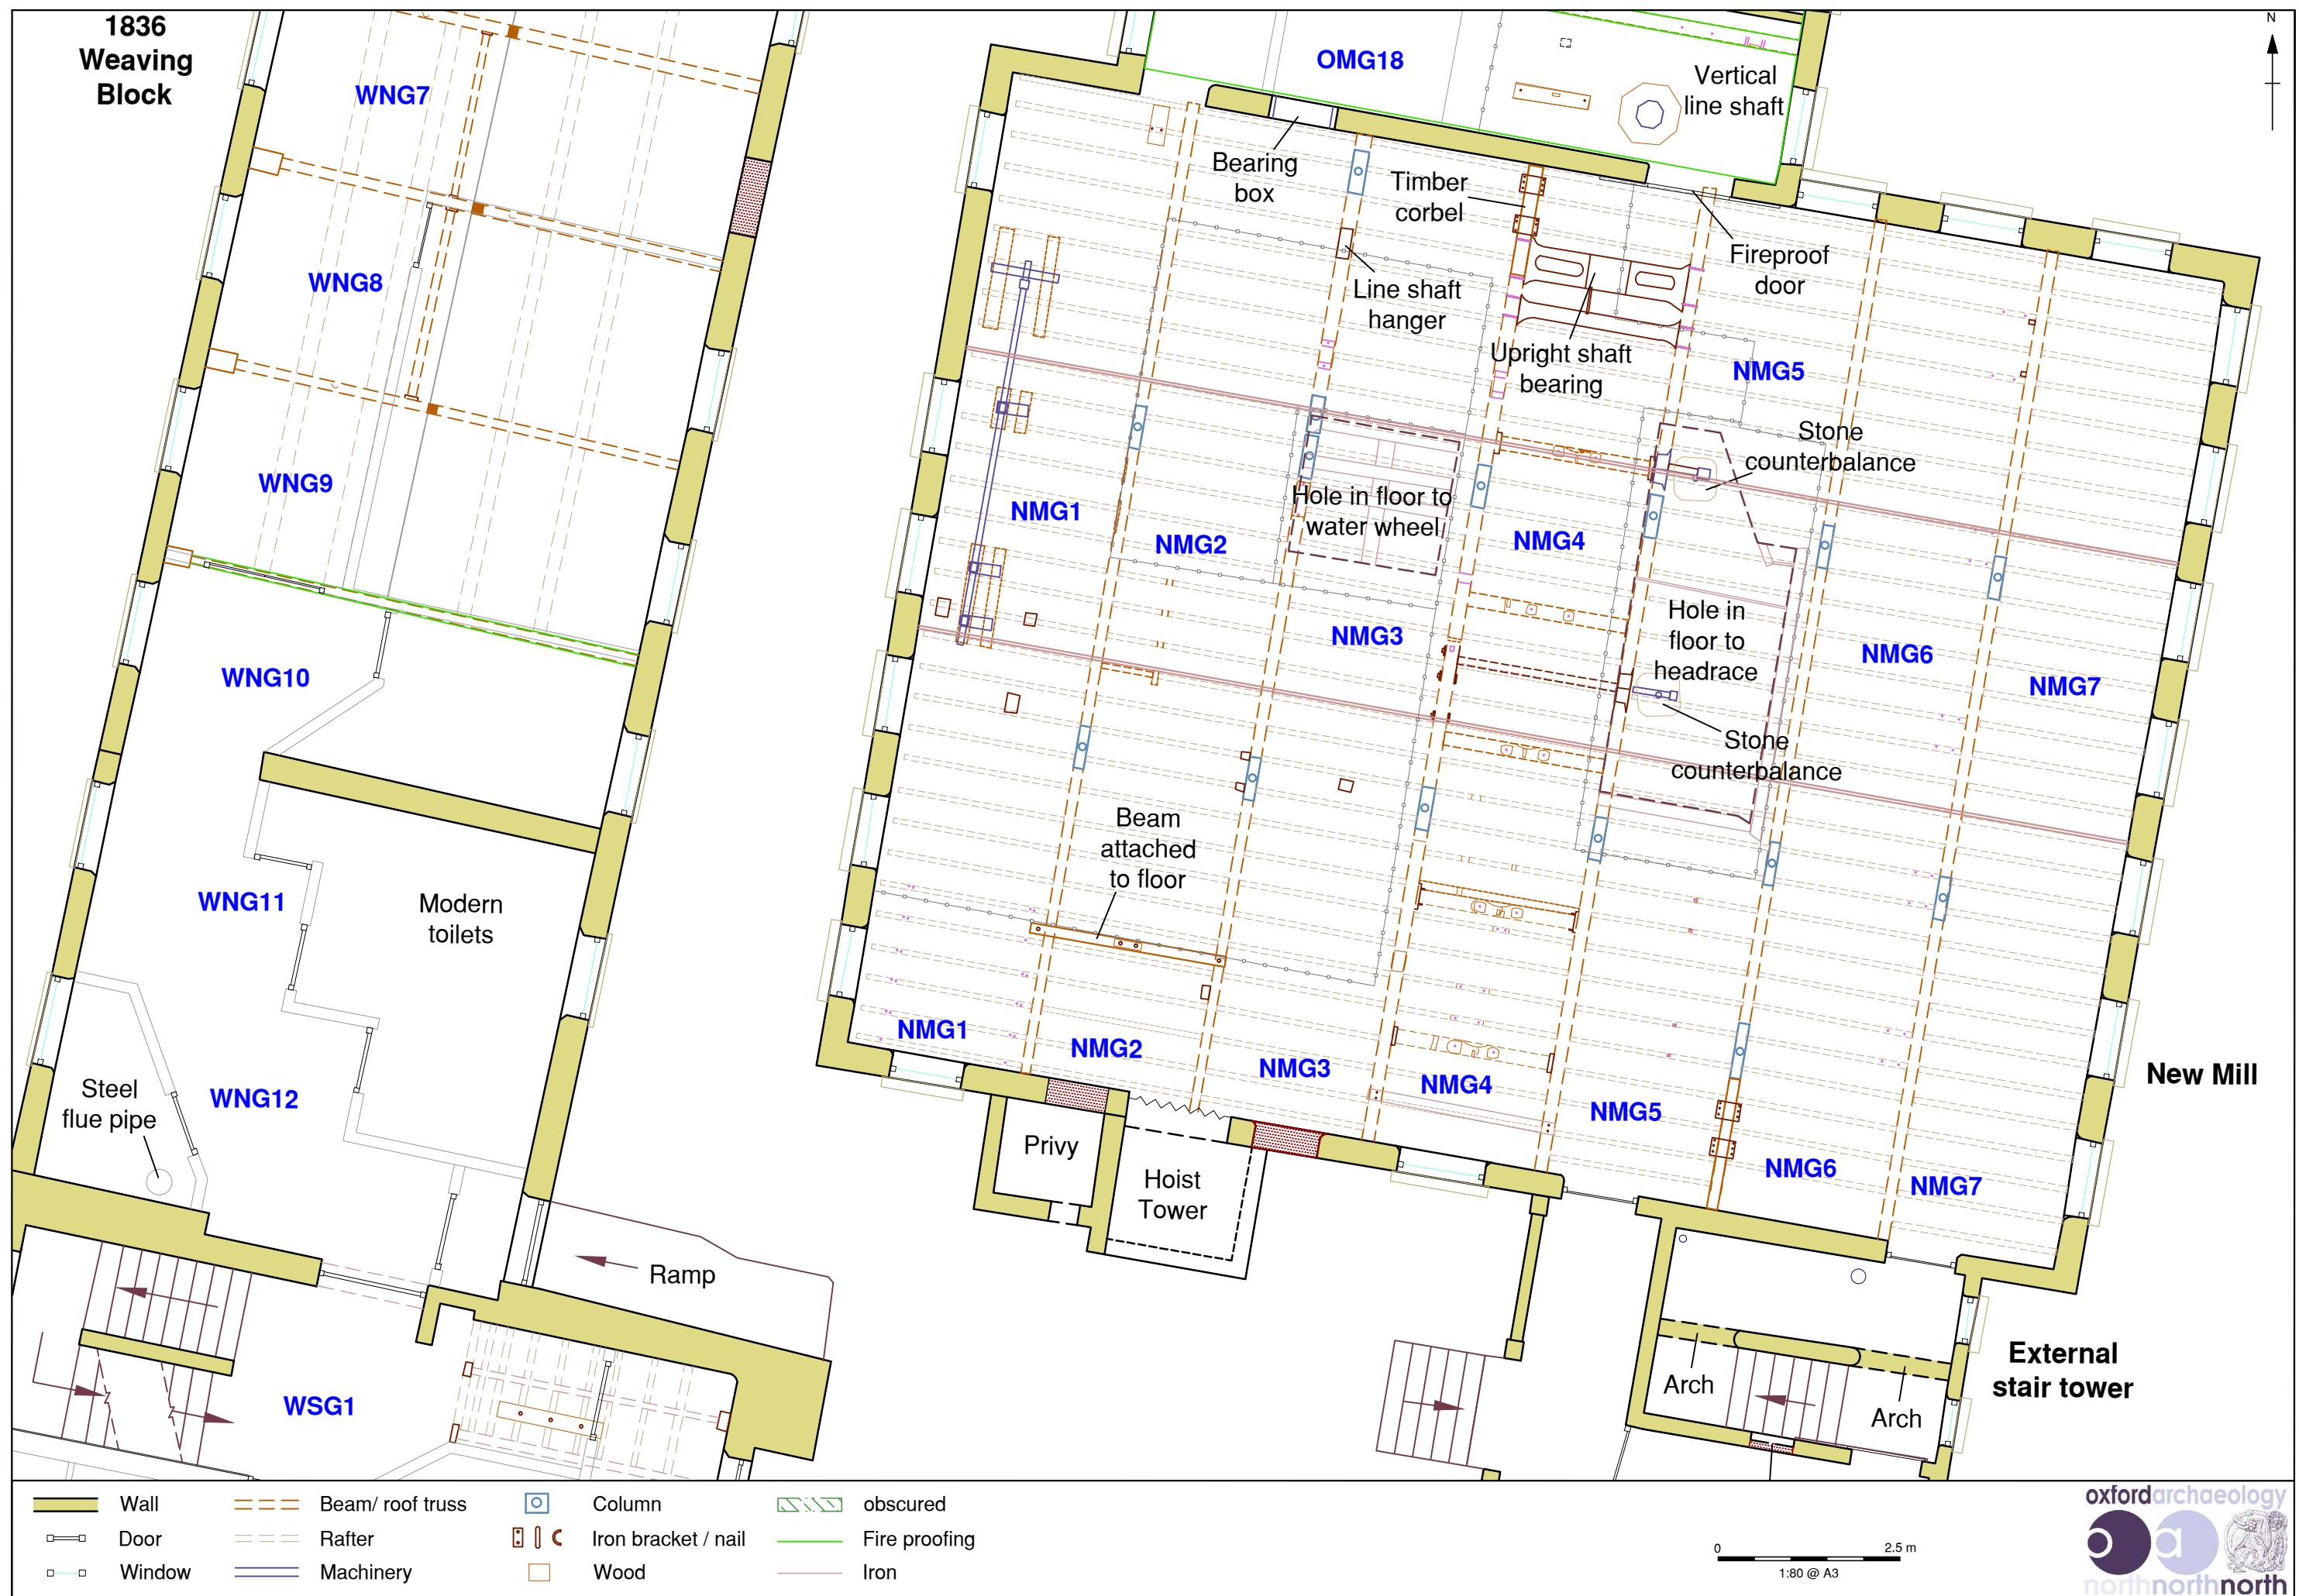


Figure 106: Ground Floor - New Mill

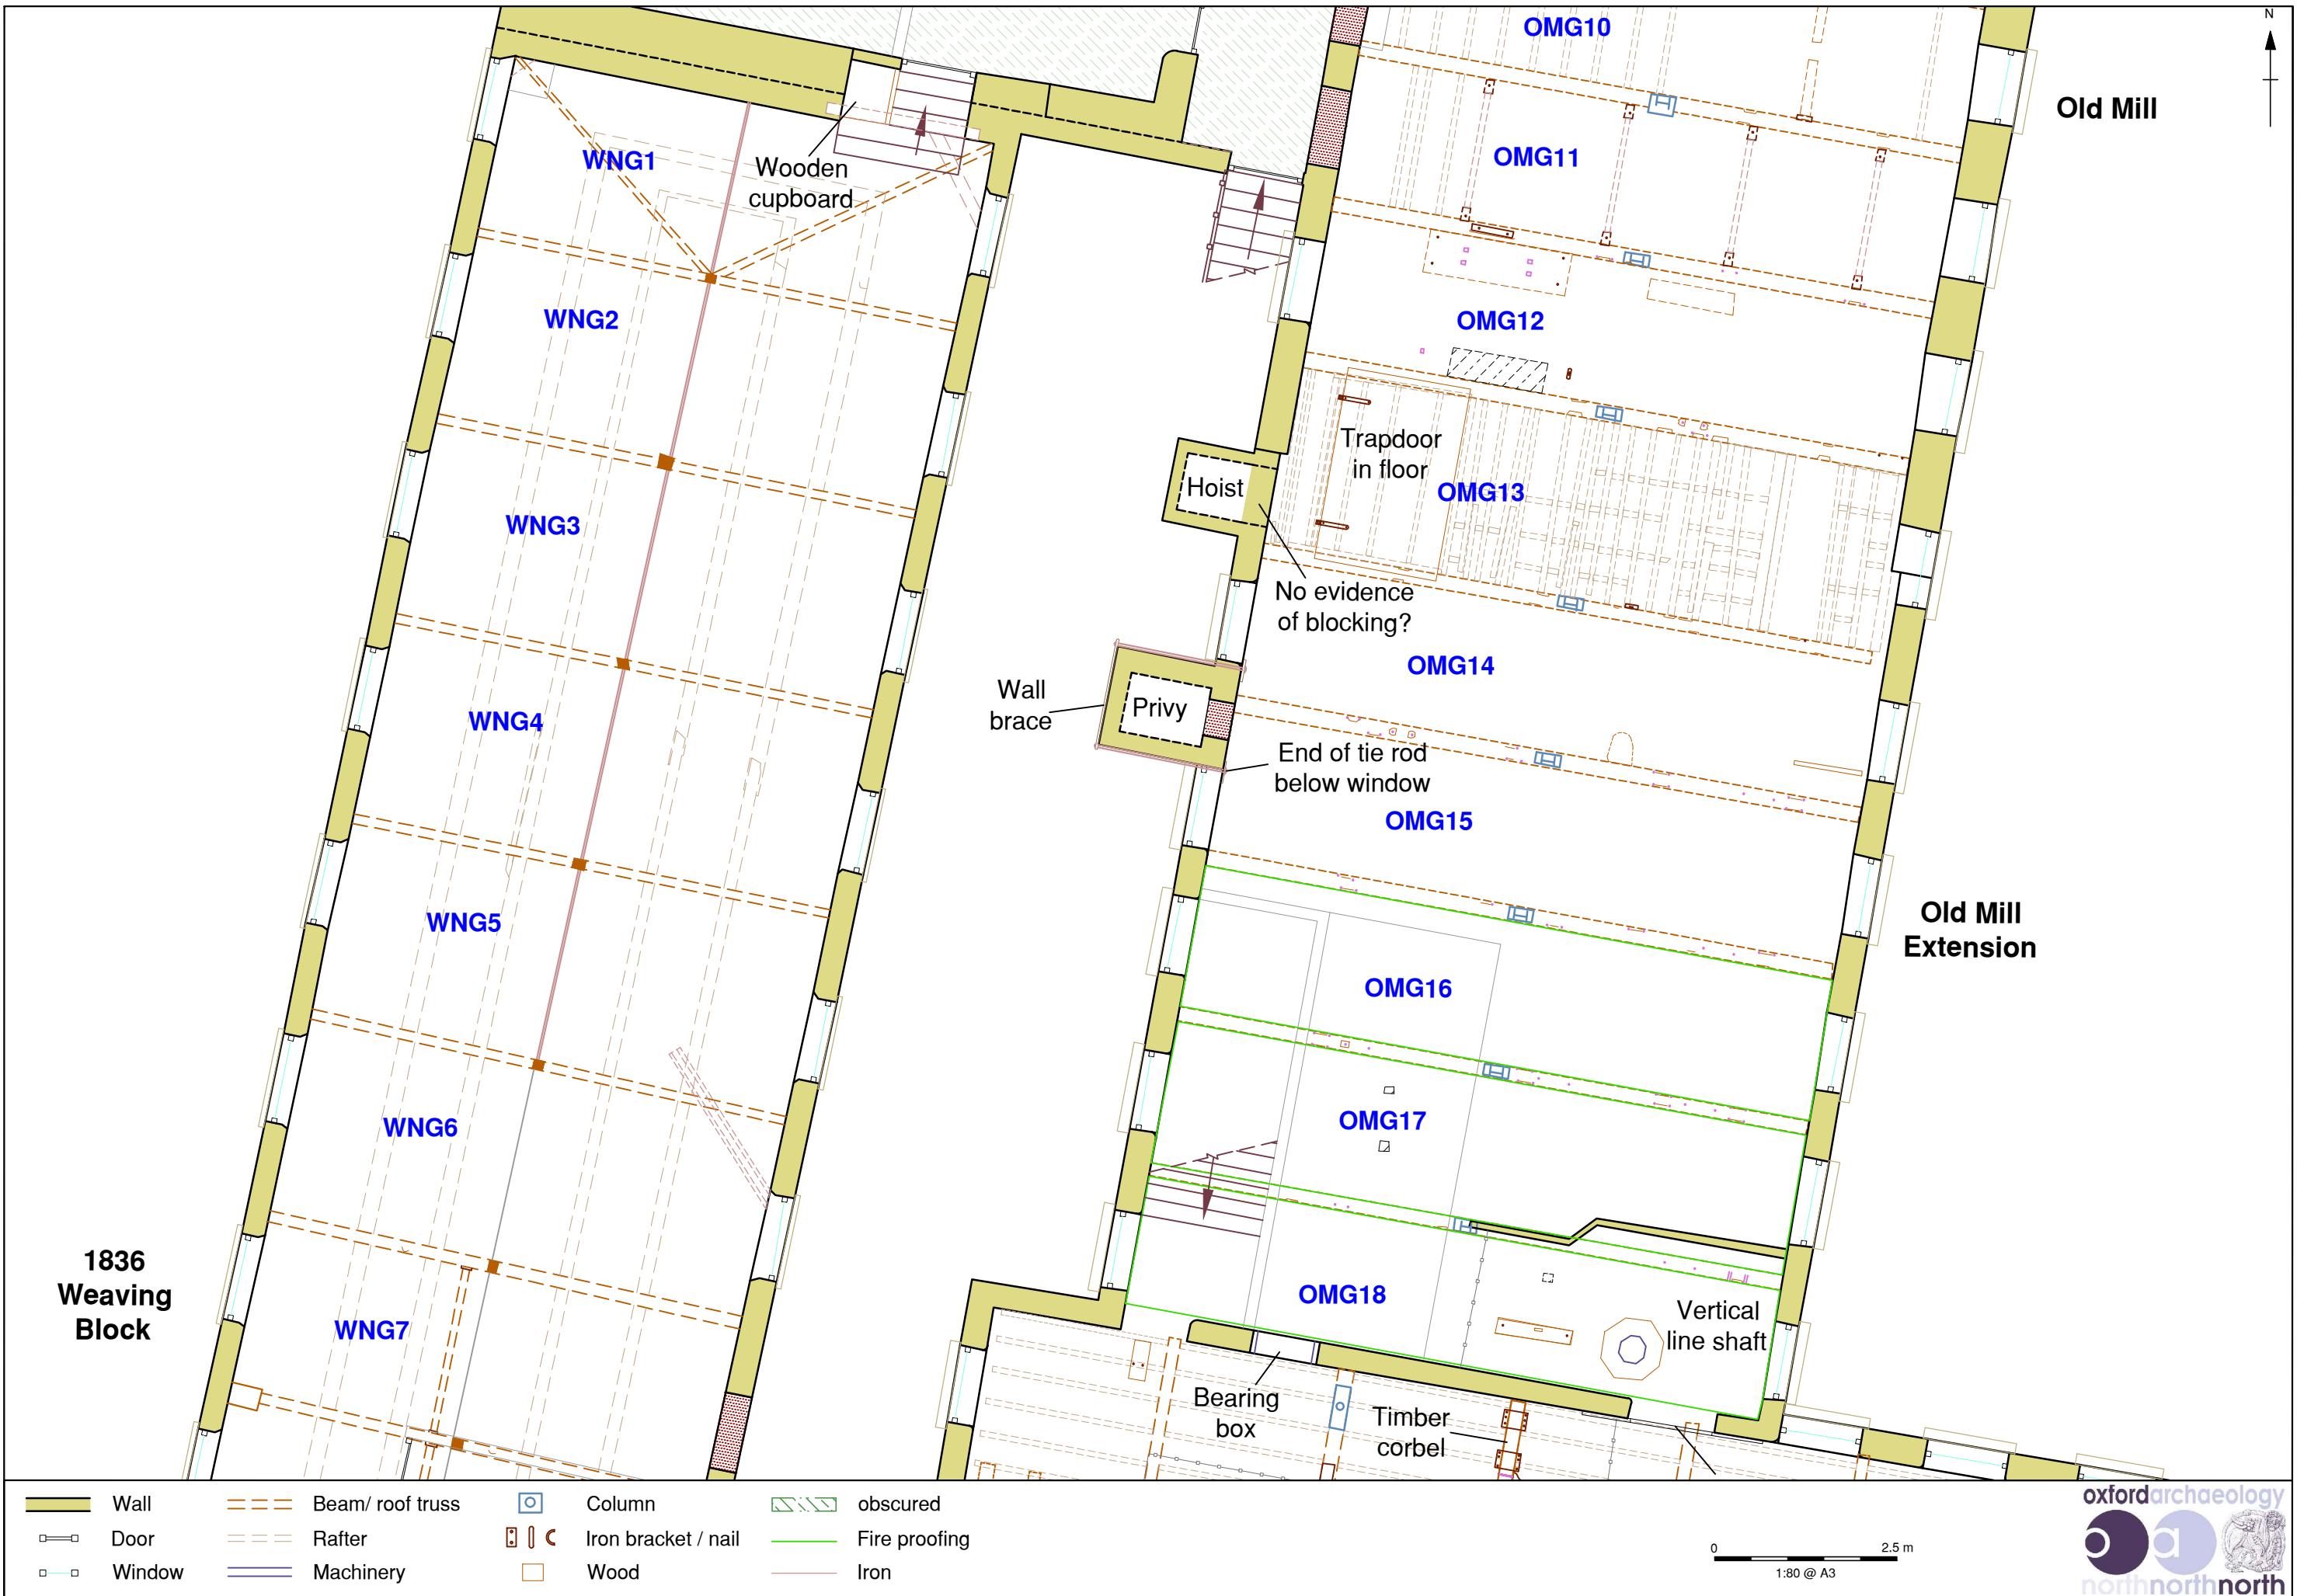


Figure 107: Ground Floor - Old Mill Extension and 1836 Weaving Block



Figure 108: Ground Floor - Old Mill and 1843 Preparation Block

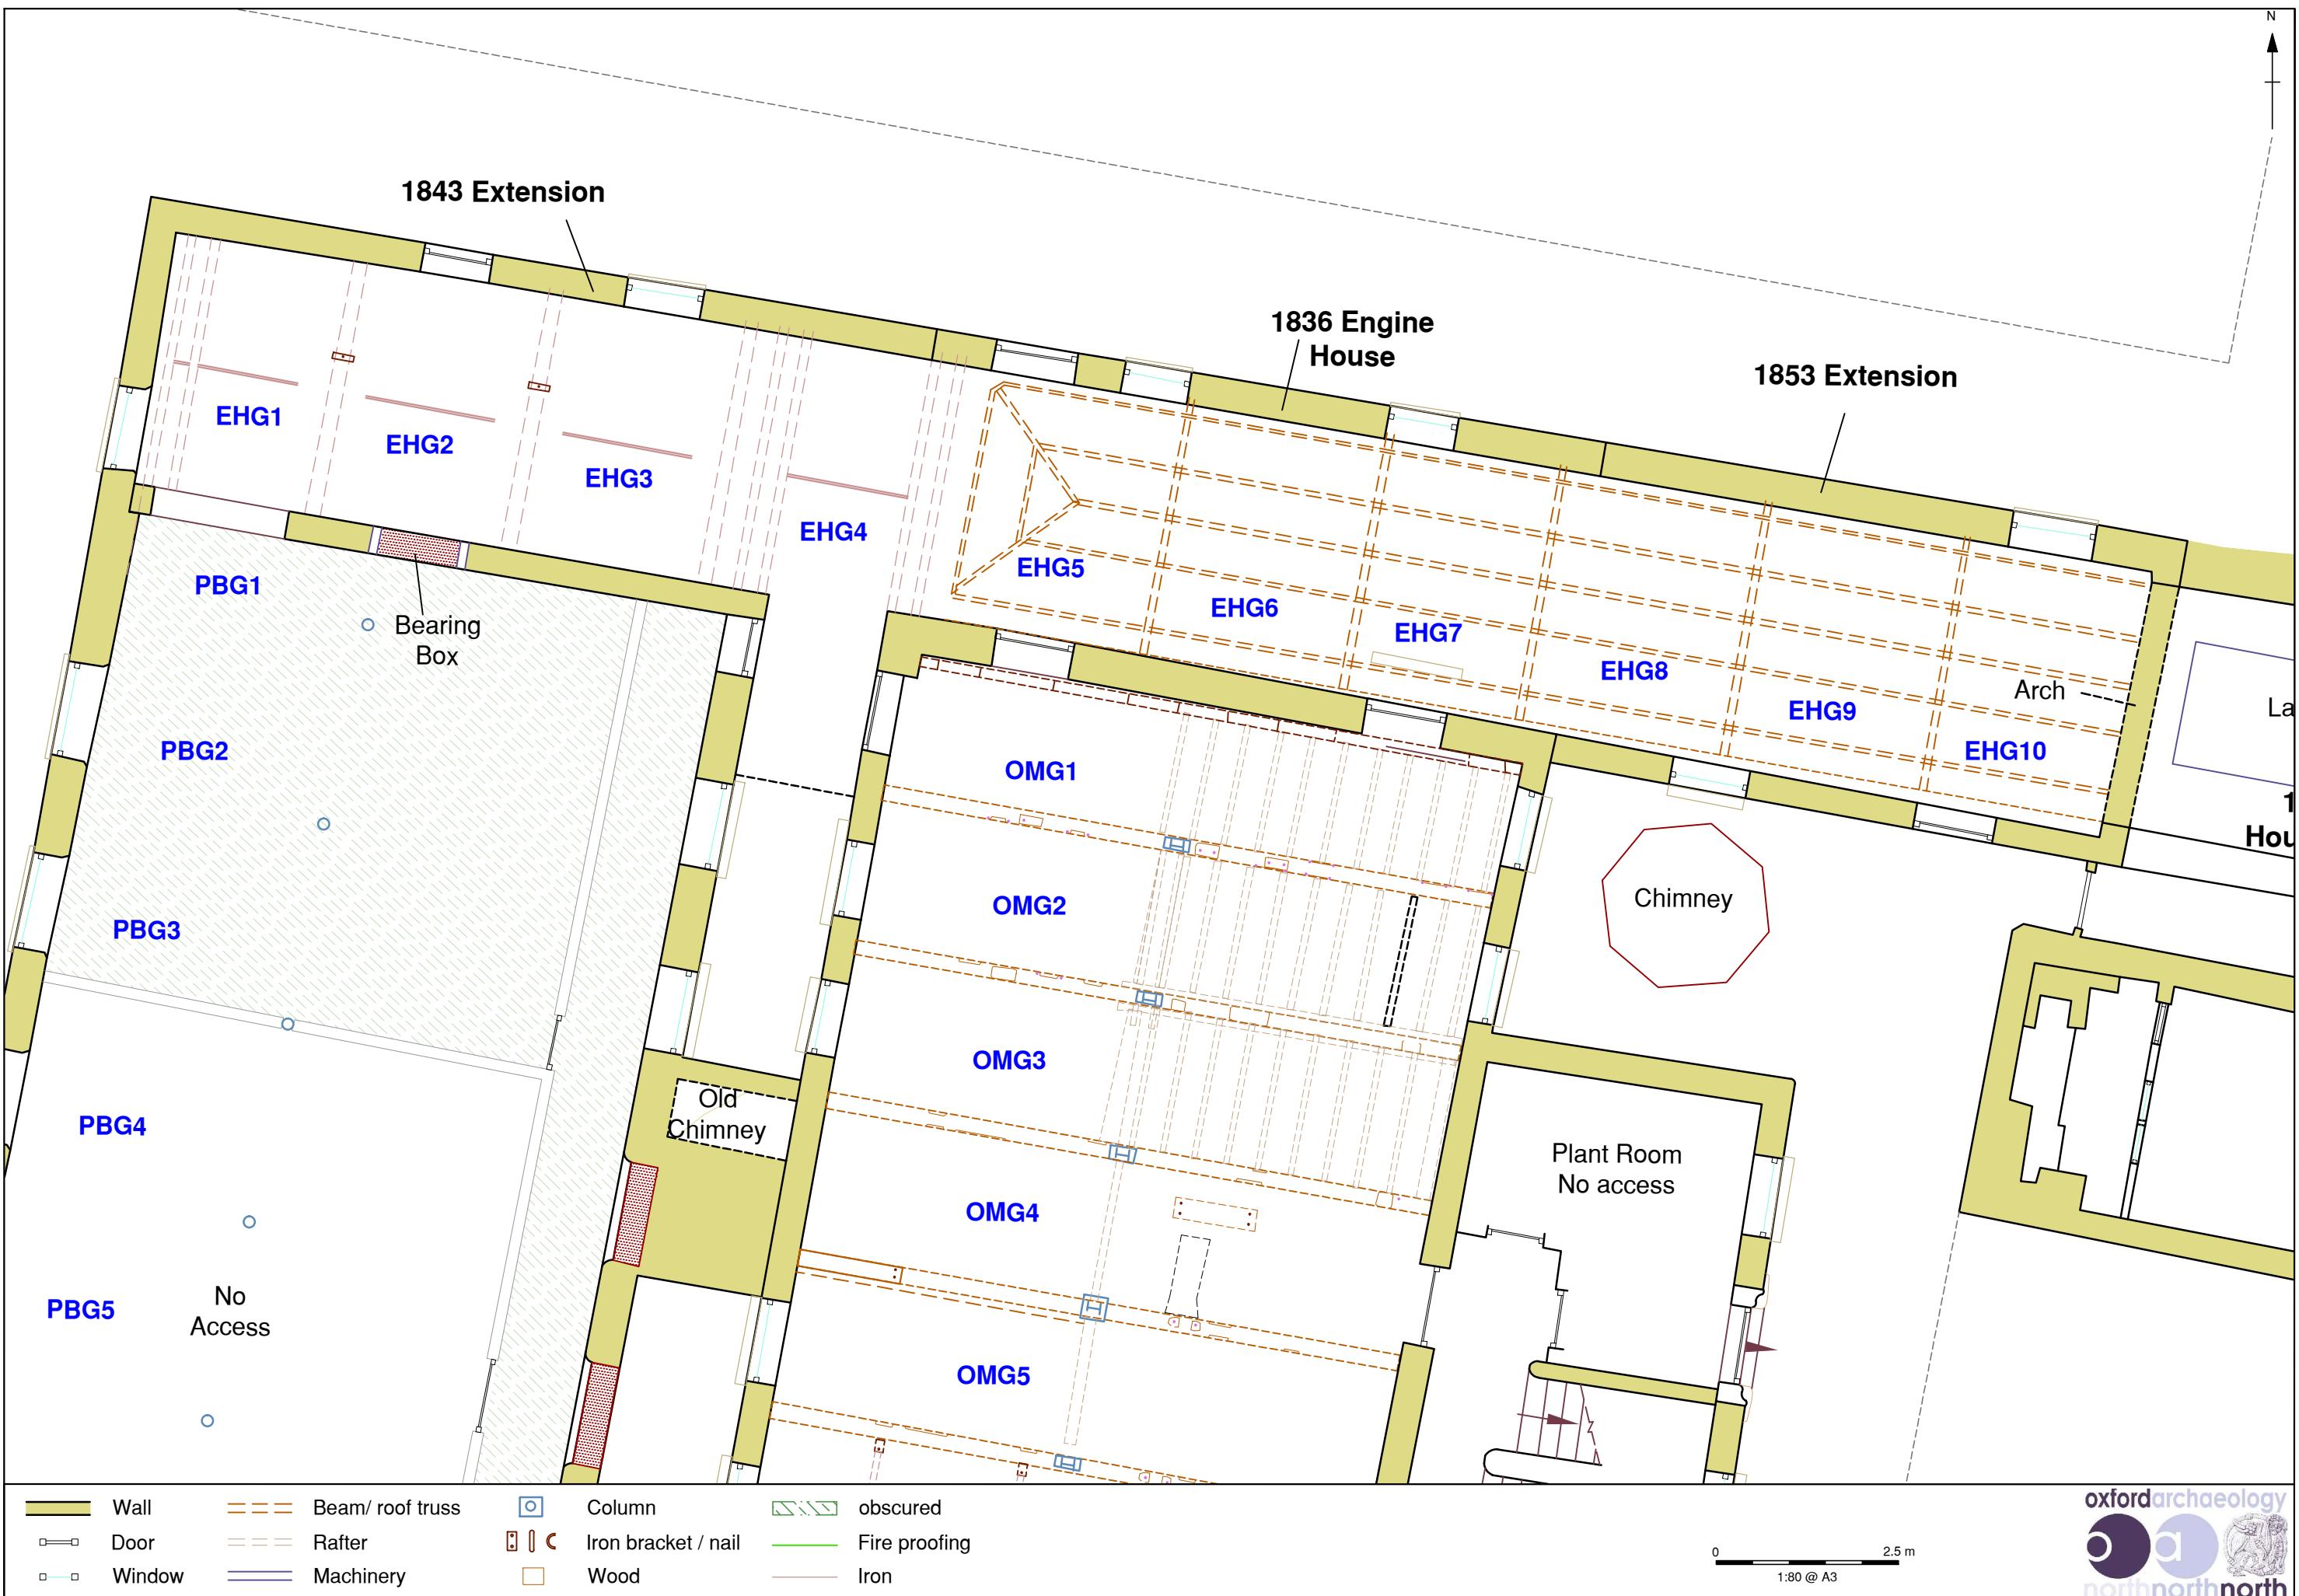


Figure 109: Ground Floor - Old Mill (North) and Engine House

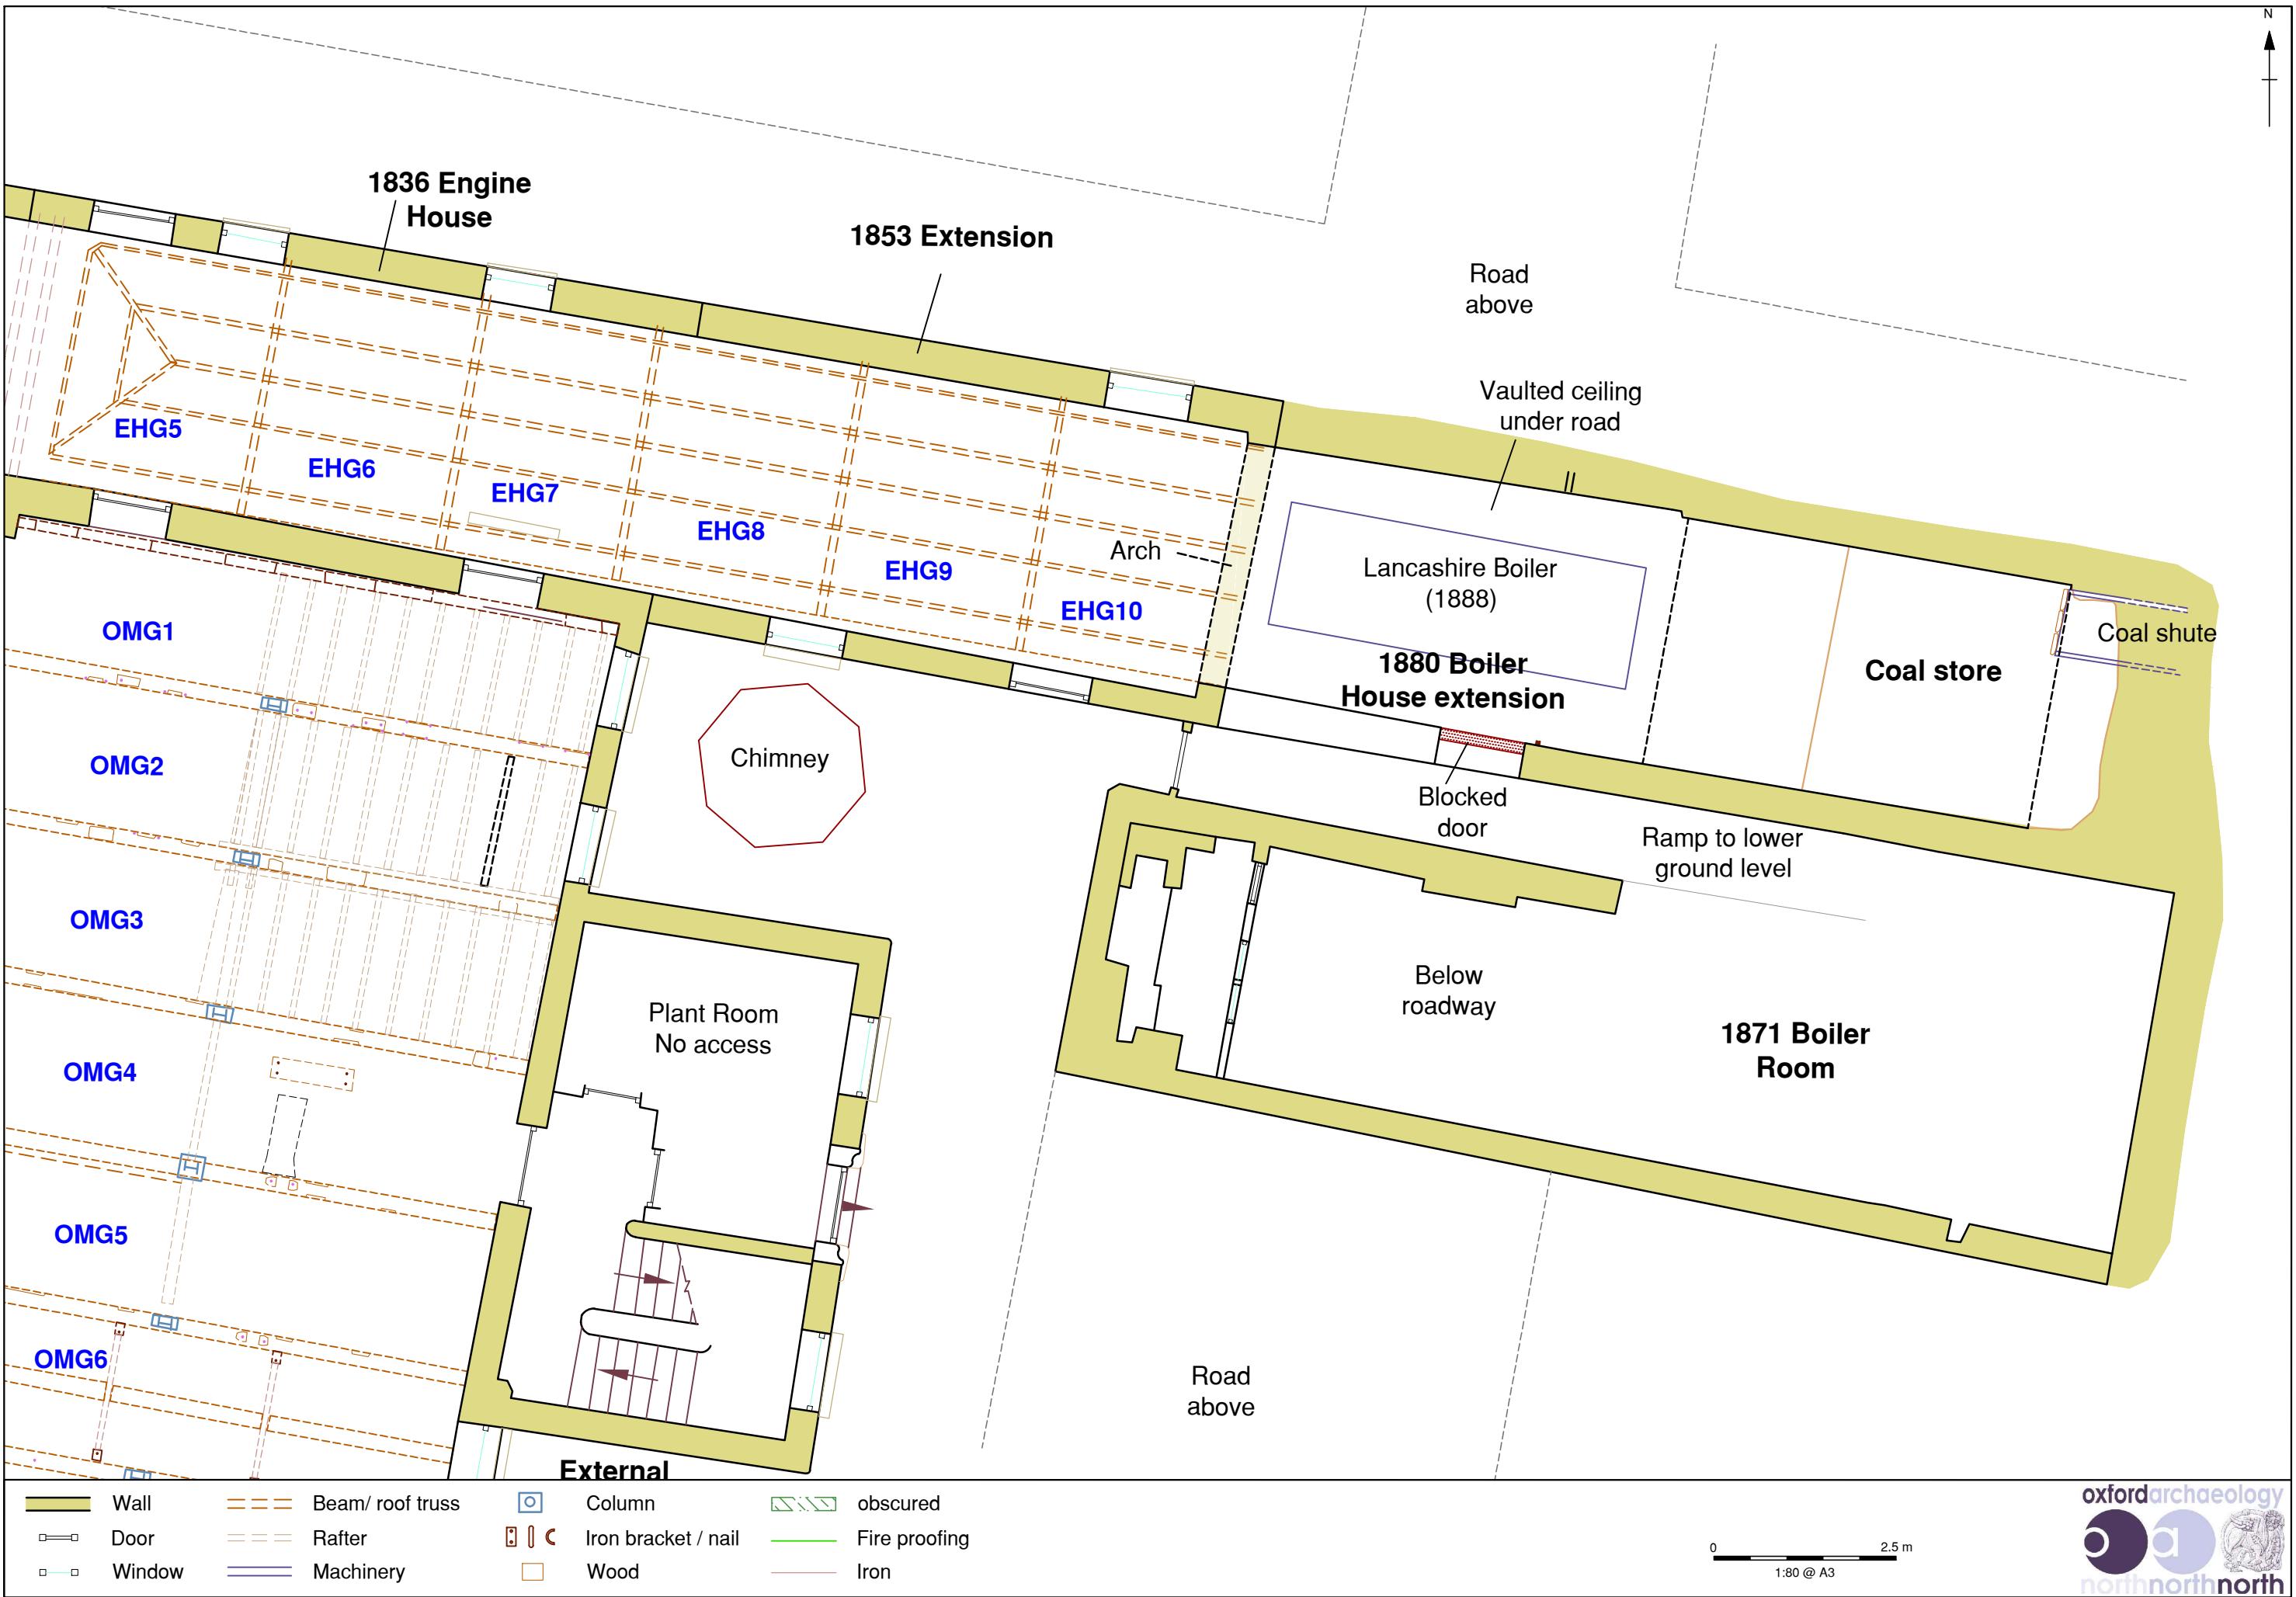


Figure 110: First Floor - Engine and Boiler Houses



Figure 111: Quarry Bank Mill Overall First Floor Plan

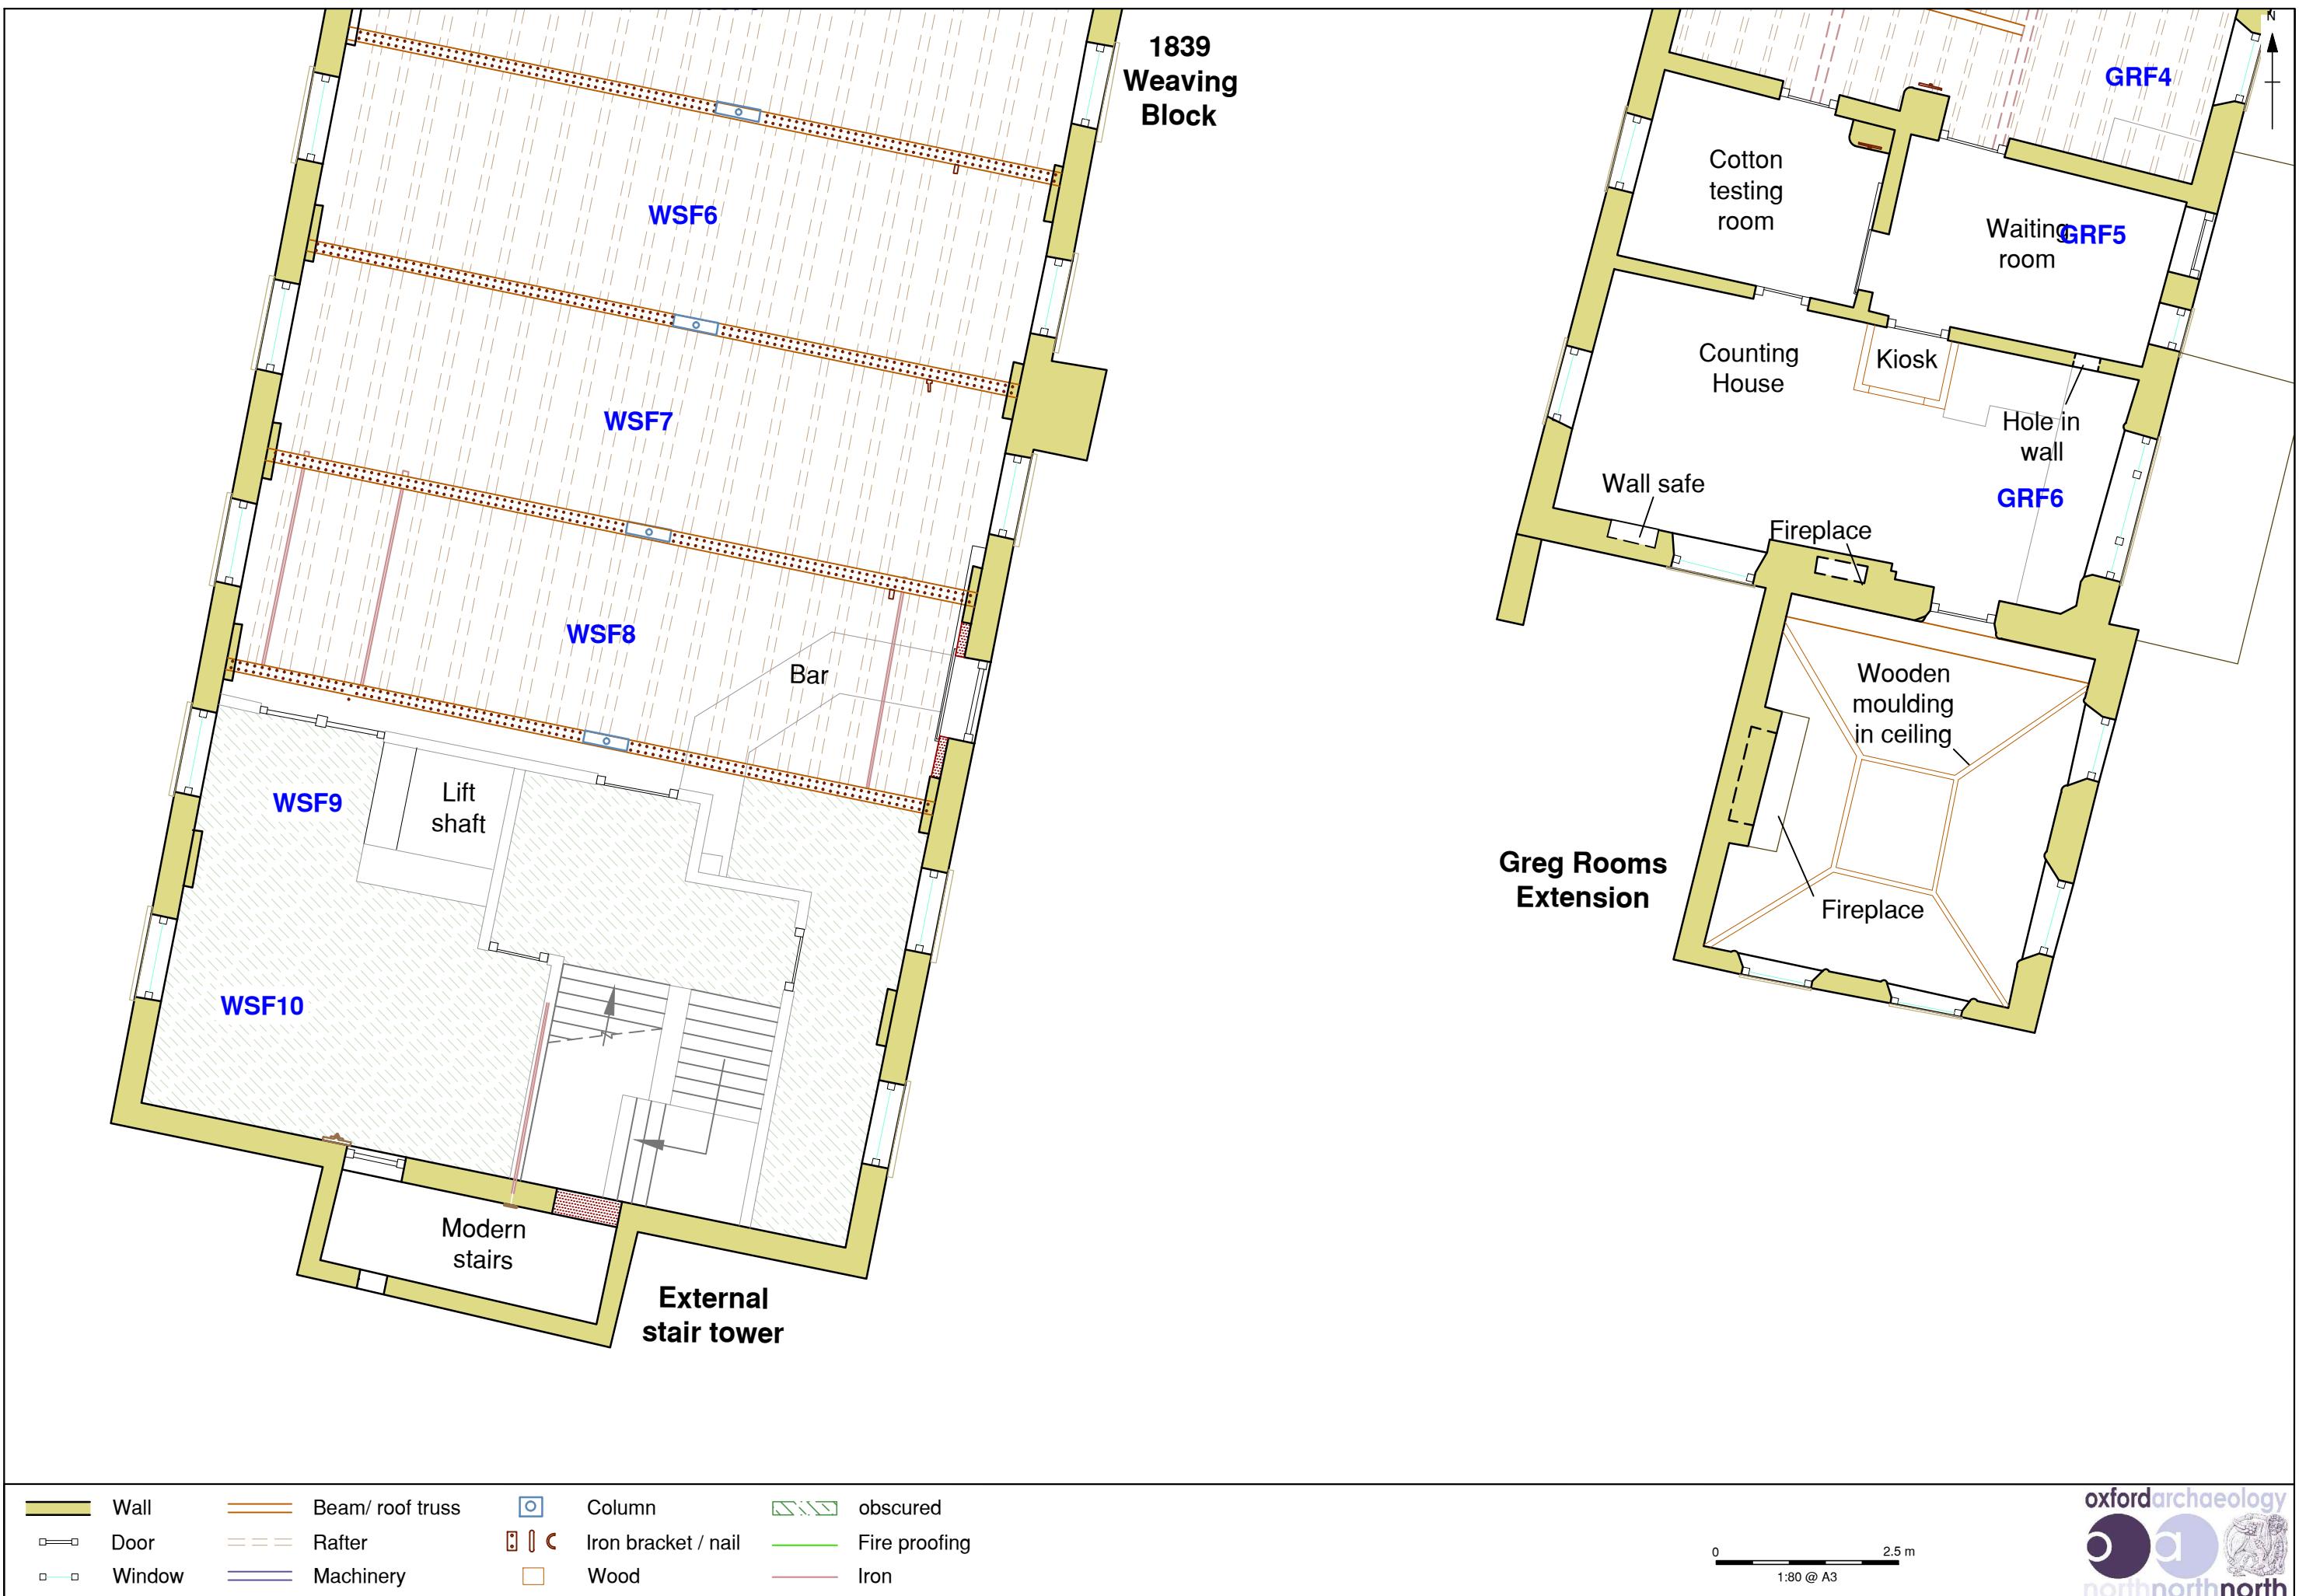




Figure 113: First Floor - 1839 Weaving Block and Greg Rooms (North)

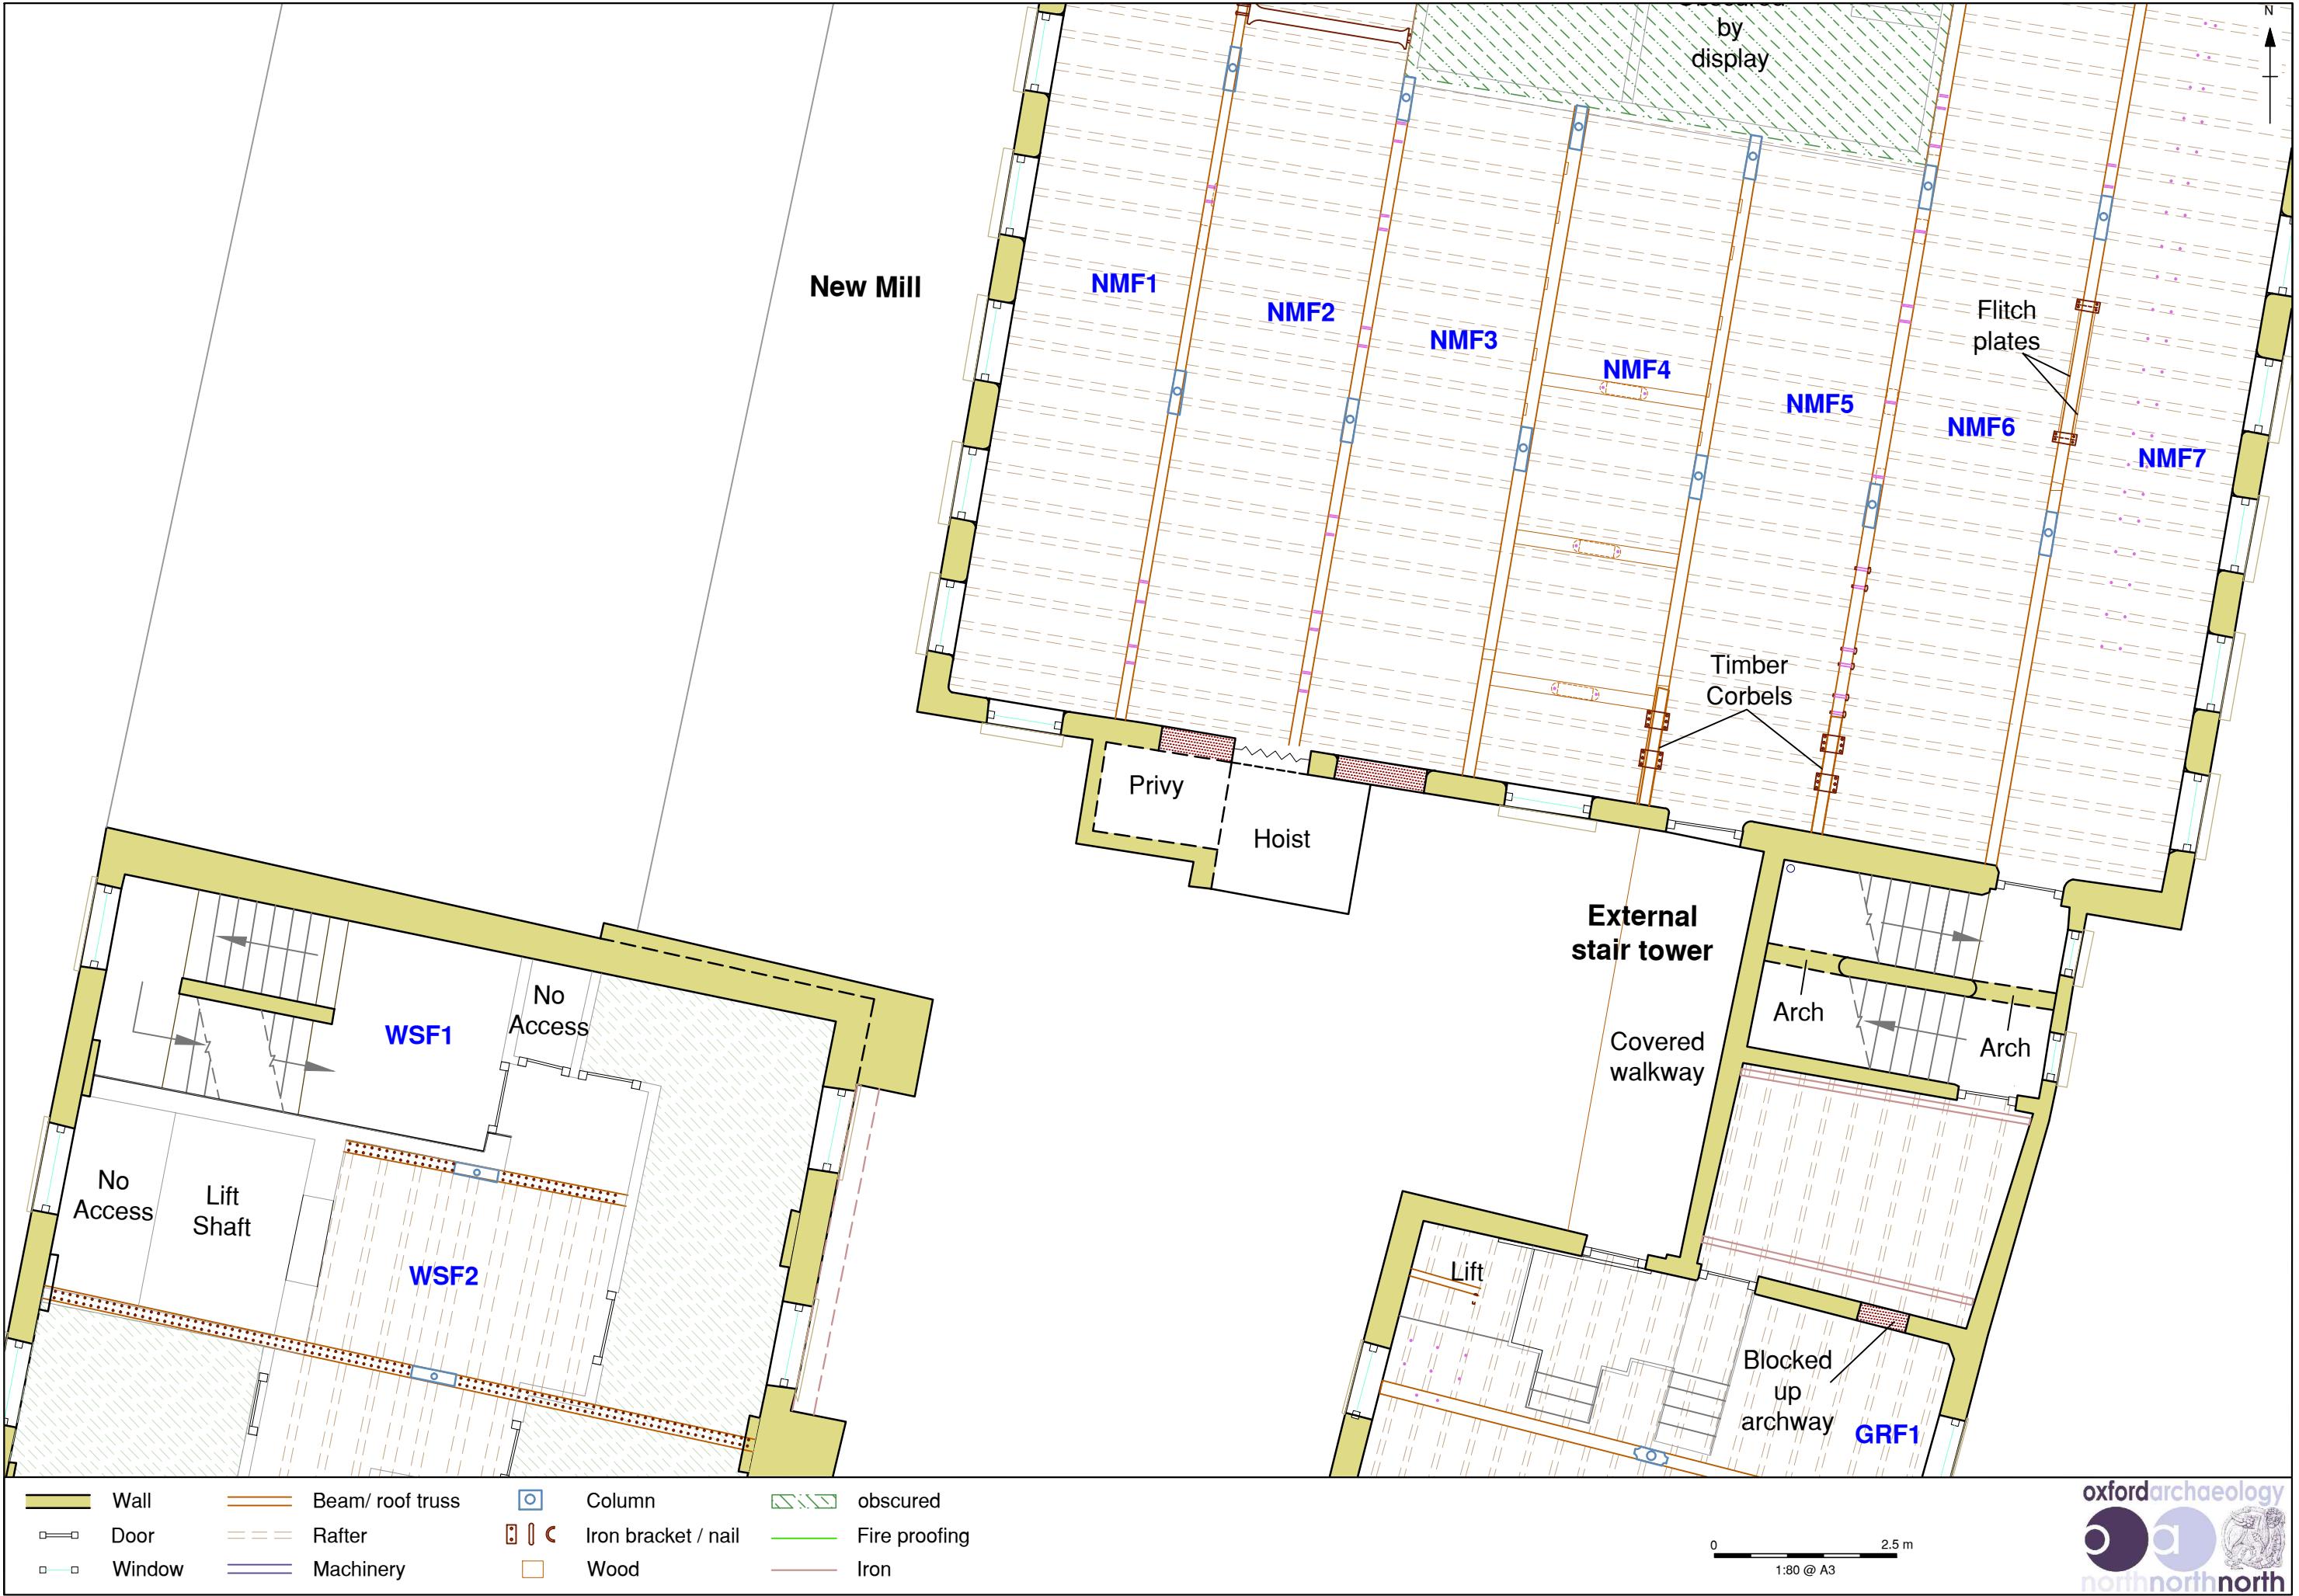


Figure 114: First Floor - New Mill (South)

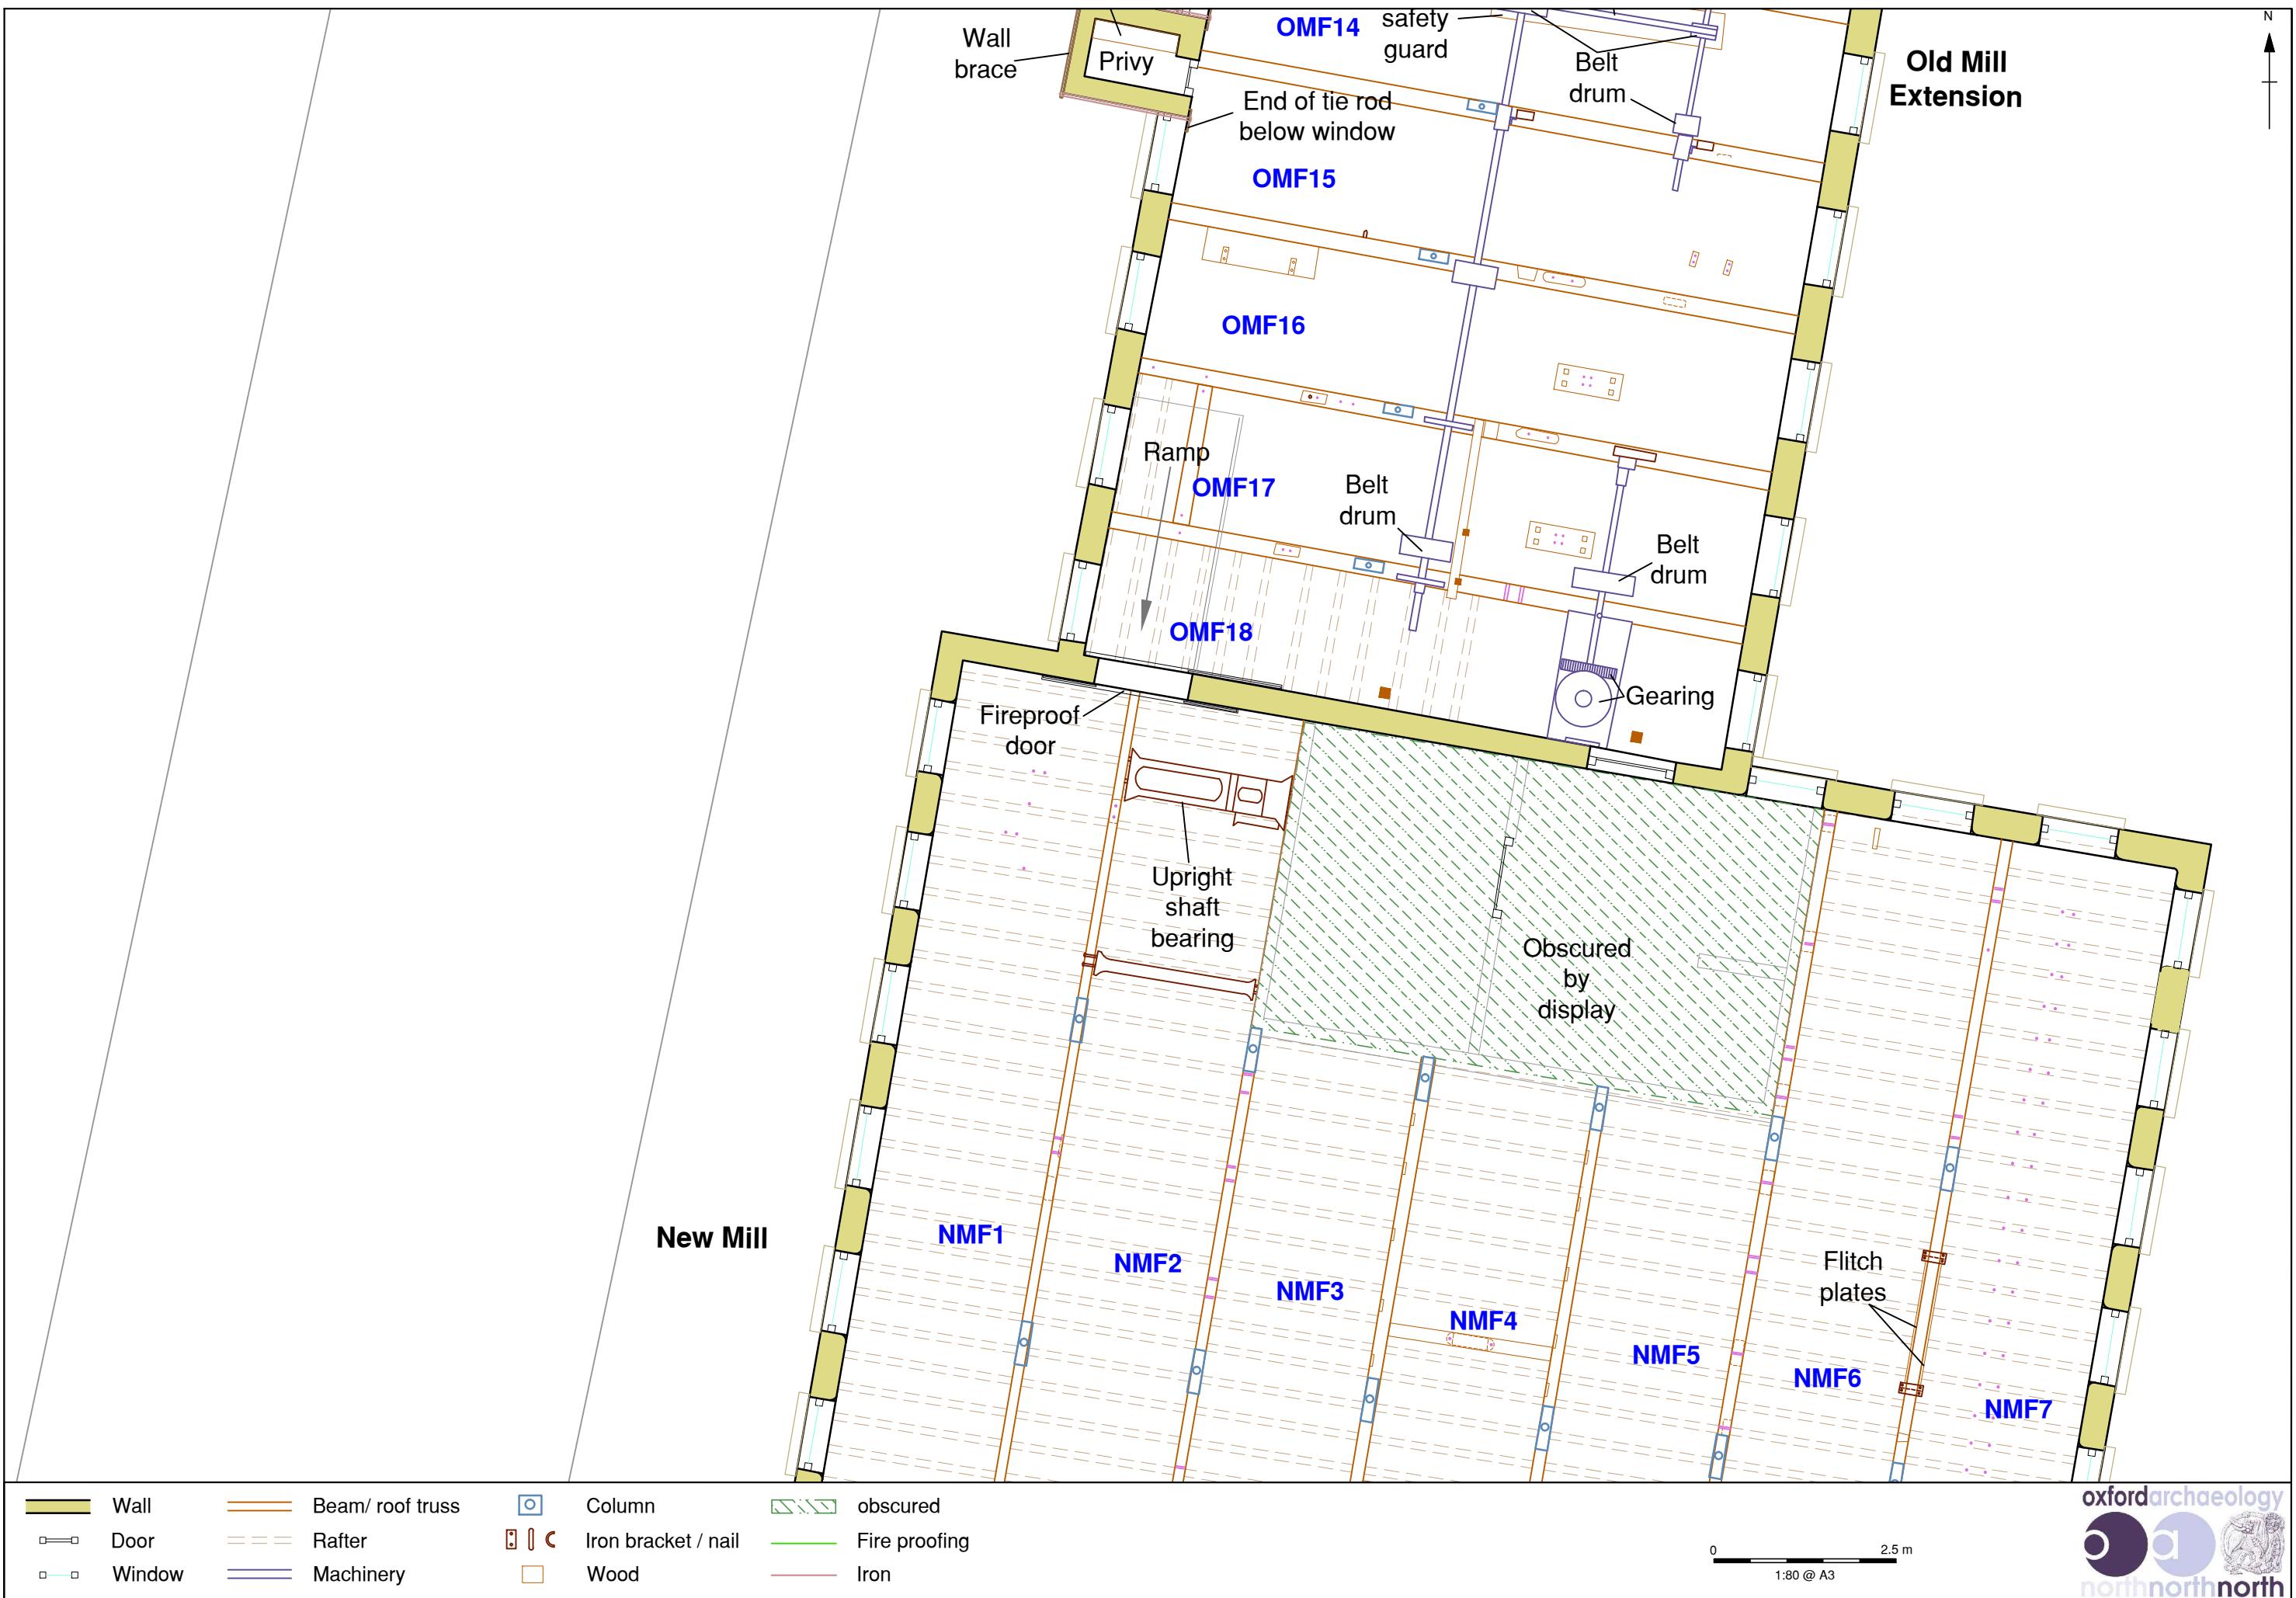


Figure 115: First Floor - New Mill (North)

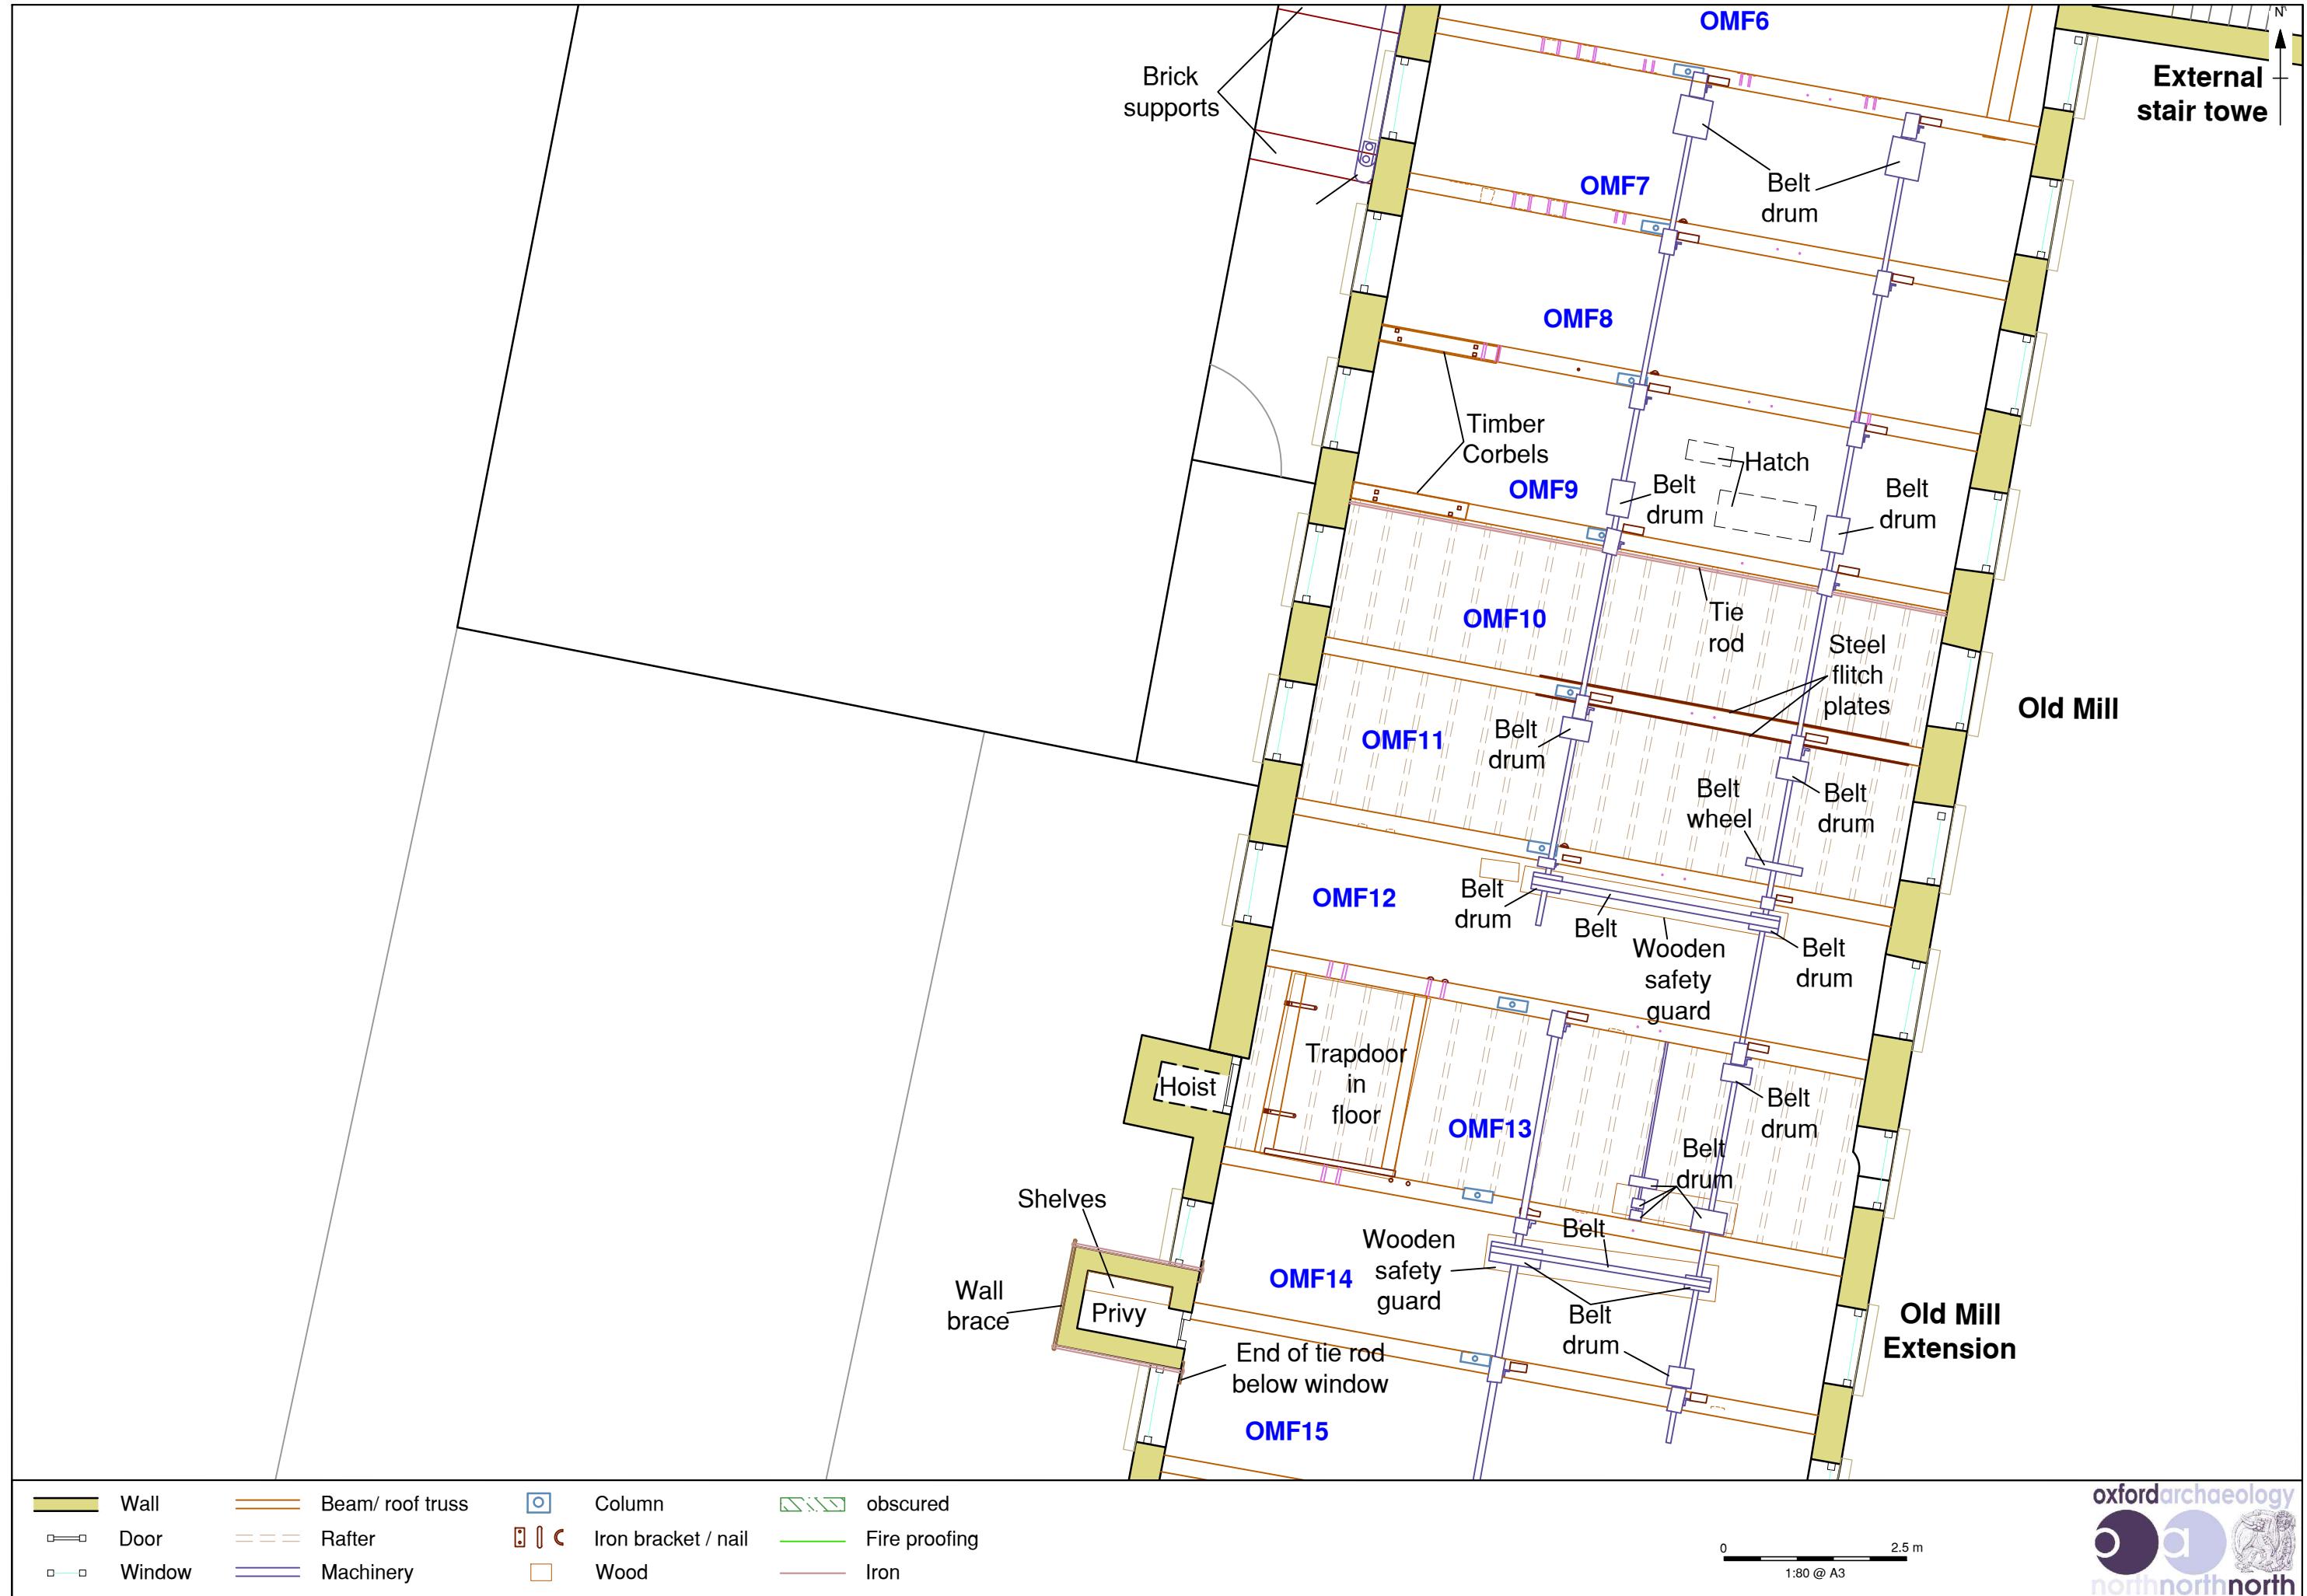


Figure 116: First Floor - Old Mill (South)

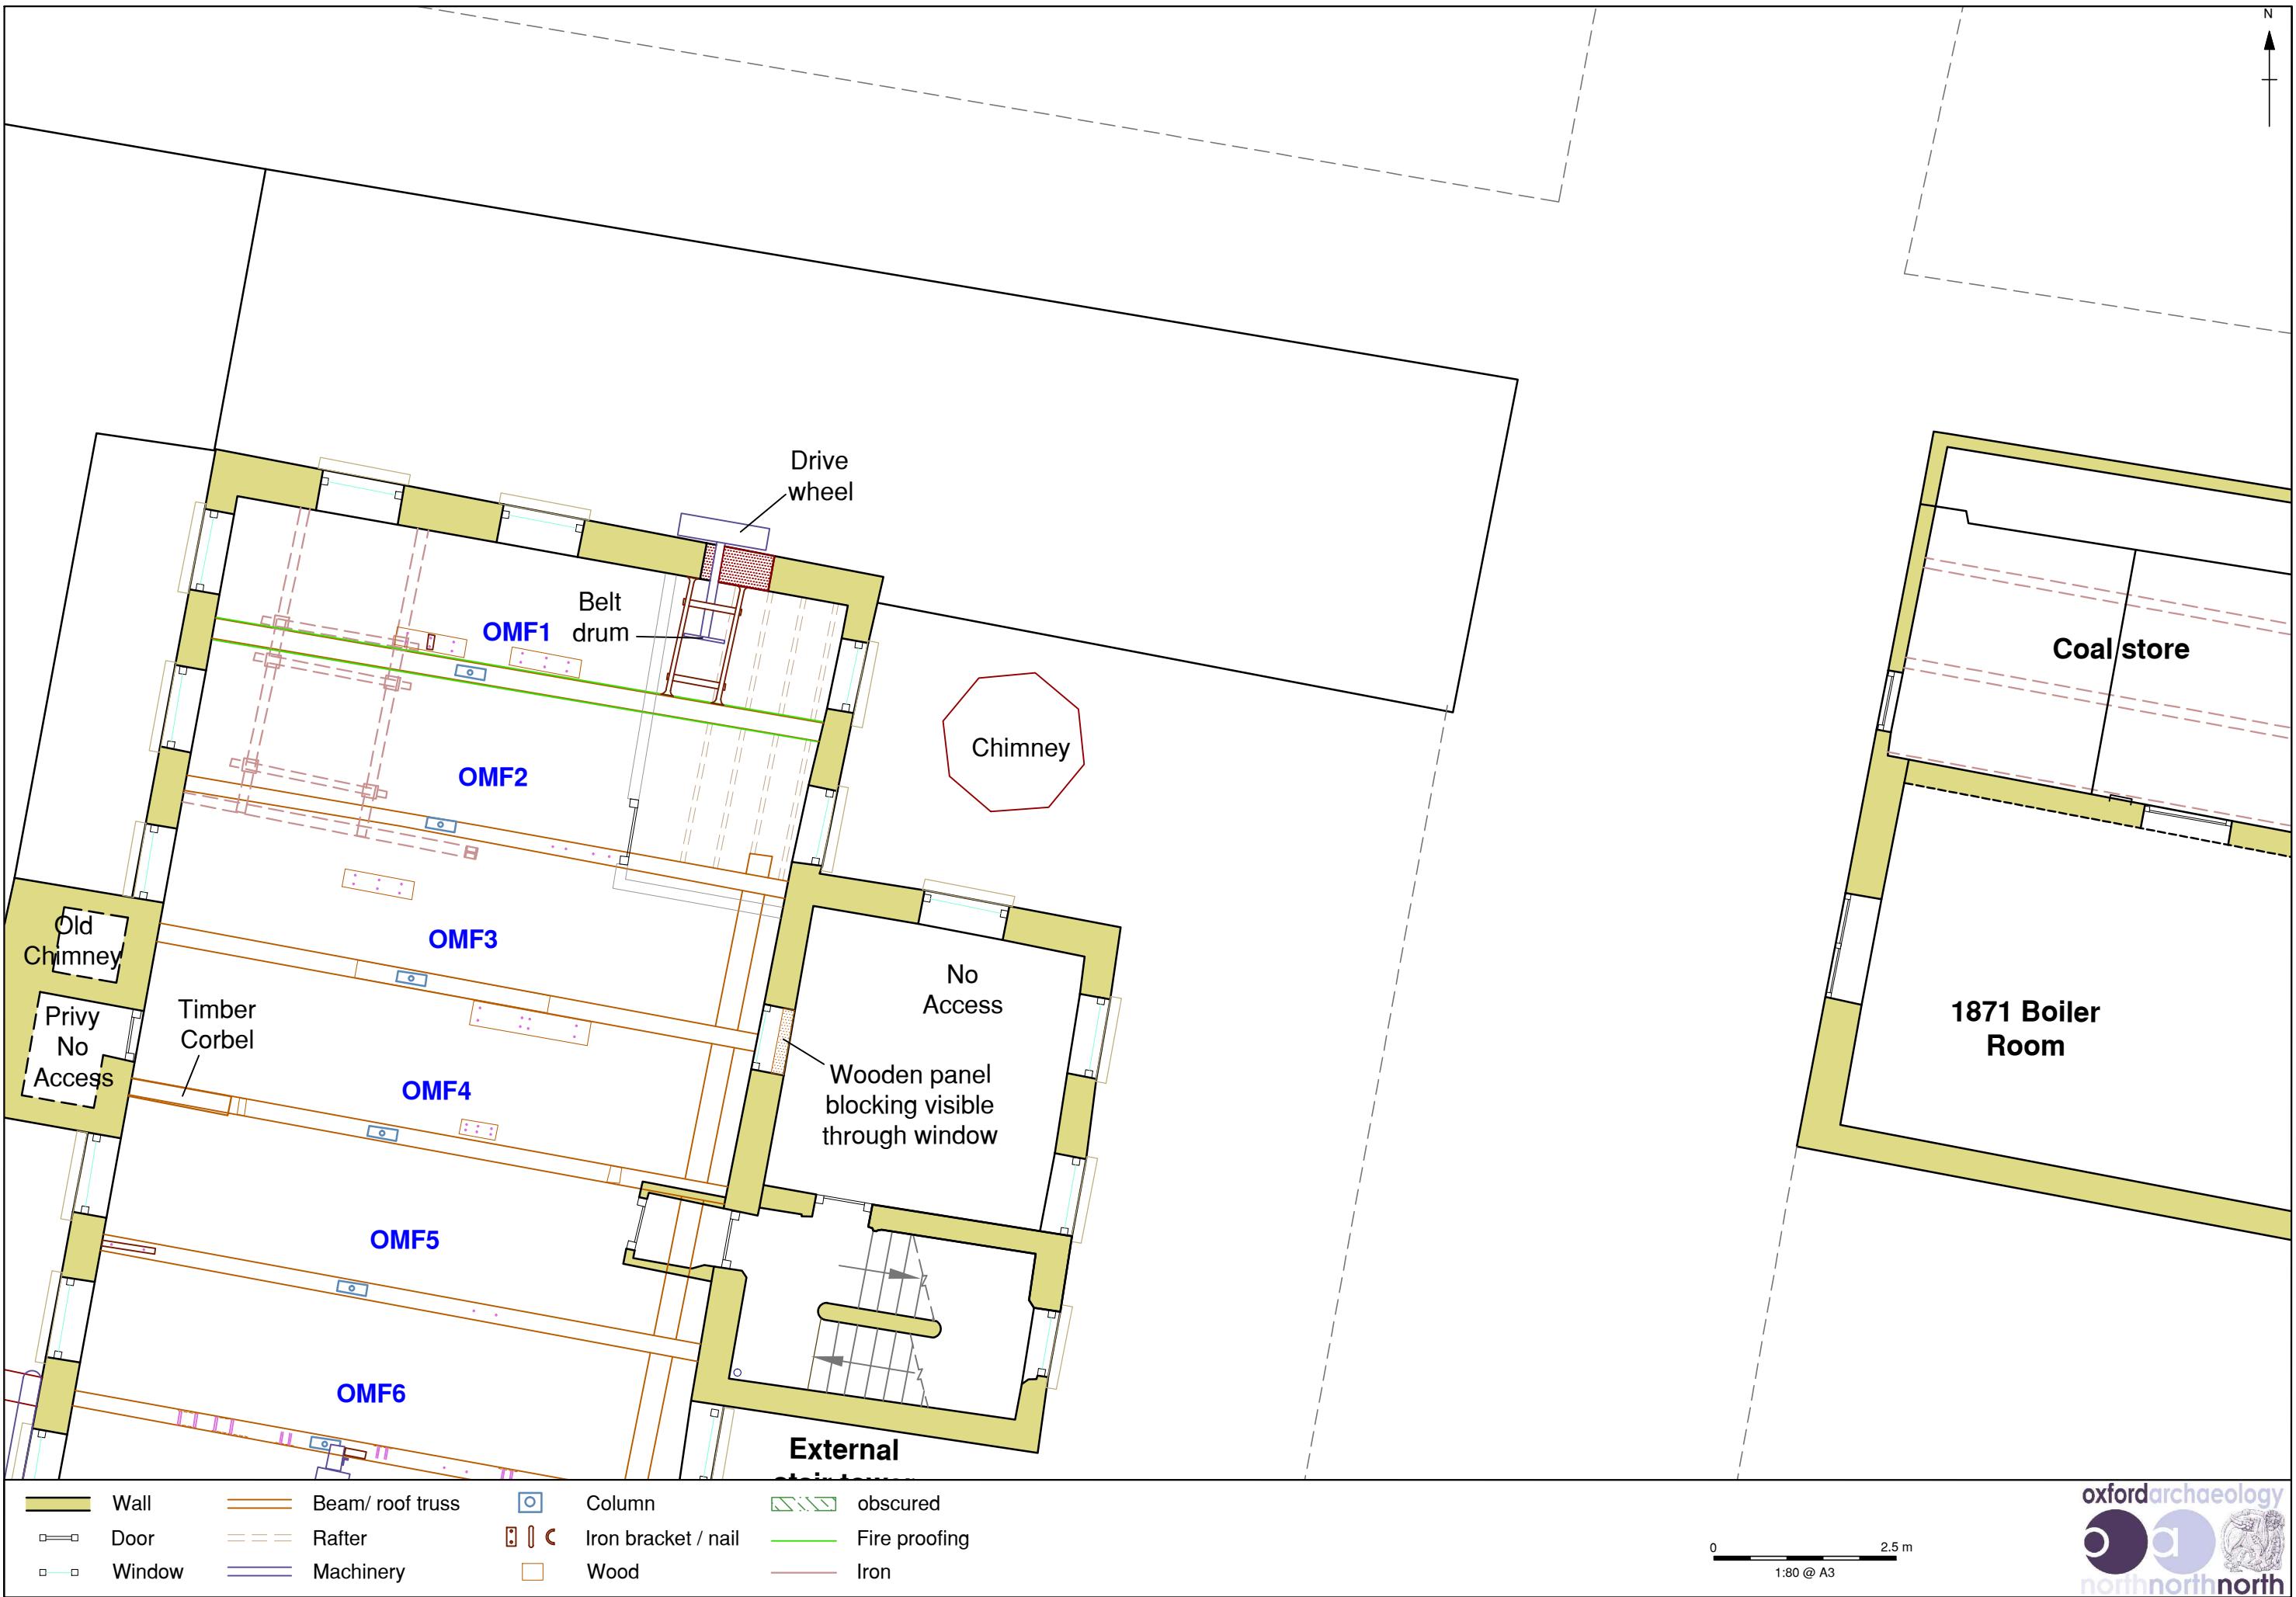



Figure 117: First Floor - Old Mill (North)



■ Wall	— Beam/ roof truss	□ Column	▨ False ceiling
□ Door	— Rafter	■ Iron bracket / nail	— Fire proofing
□ Window	— Machinery	□ Wood	— Iron

0 5 m
1:250 @ A3

Figure 118: Quarry Bank Mill Overall Second Floor Plan

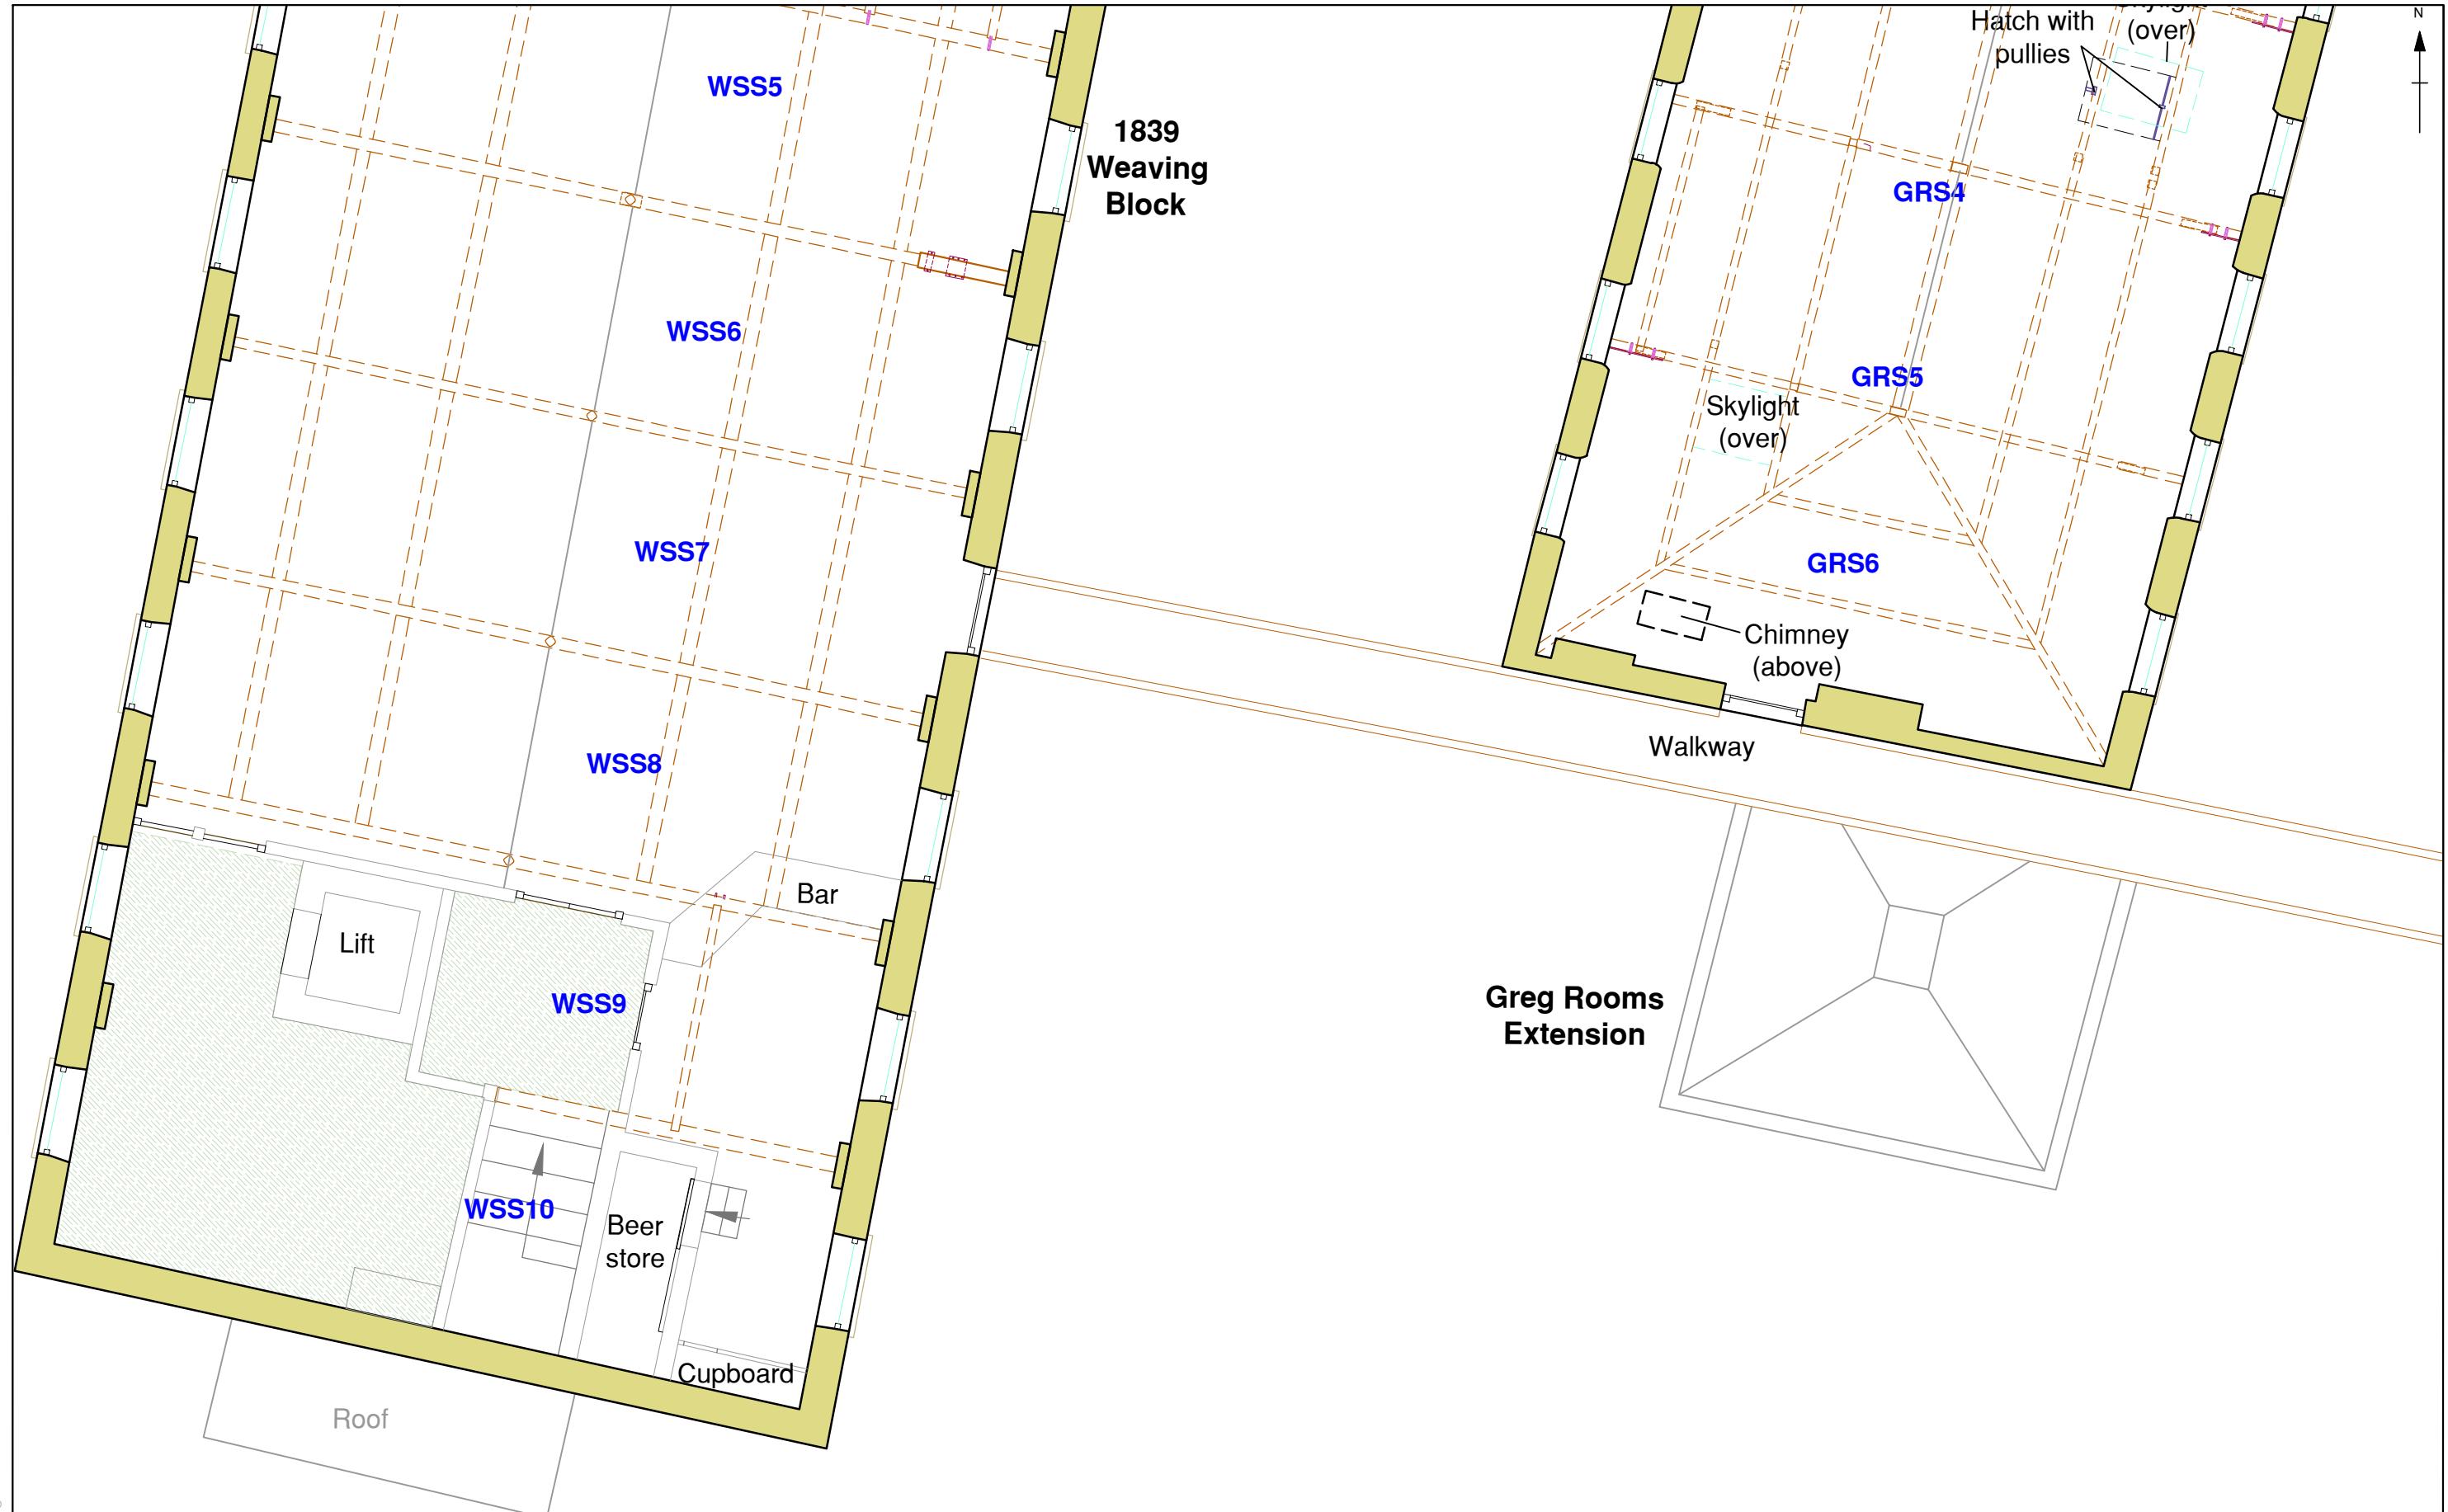

JQ*L10603*AMS*110913

Wall	Beam/ roof truss	Column	False ceiling
Door	Rafter	Iron bracket / nail	Fire proofing
Window	Machinery	Wood	Iron

0
1:80 @ A3
2.5 m

Figure 119: Second Floor - 1839 Weaving Block and Greg Rooms (South)

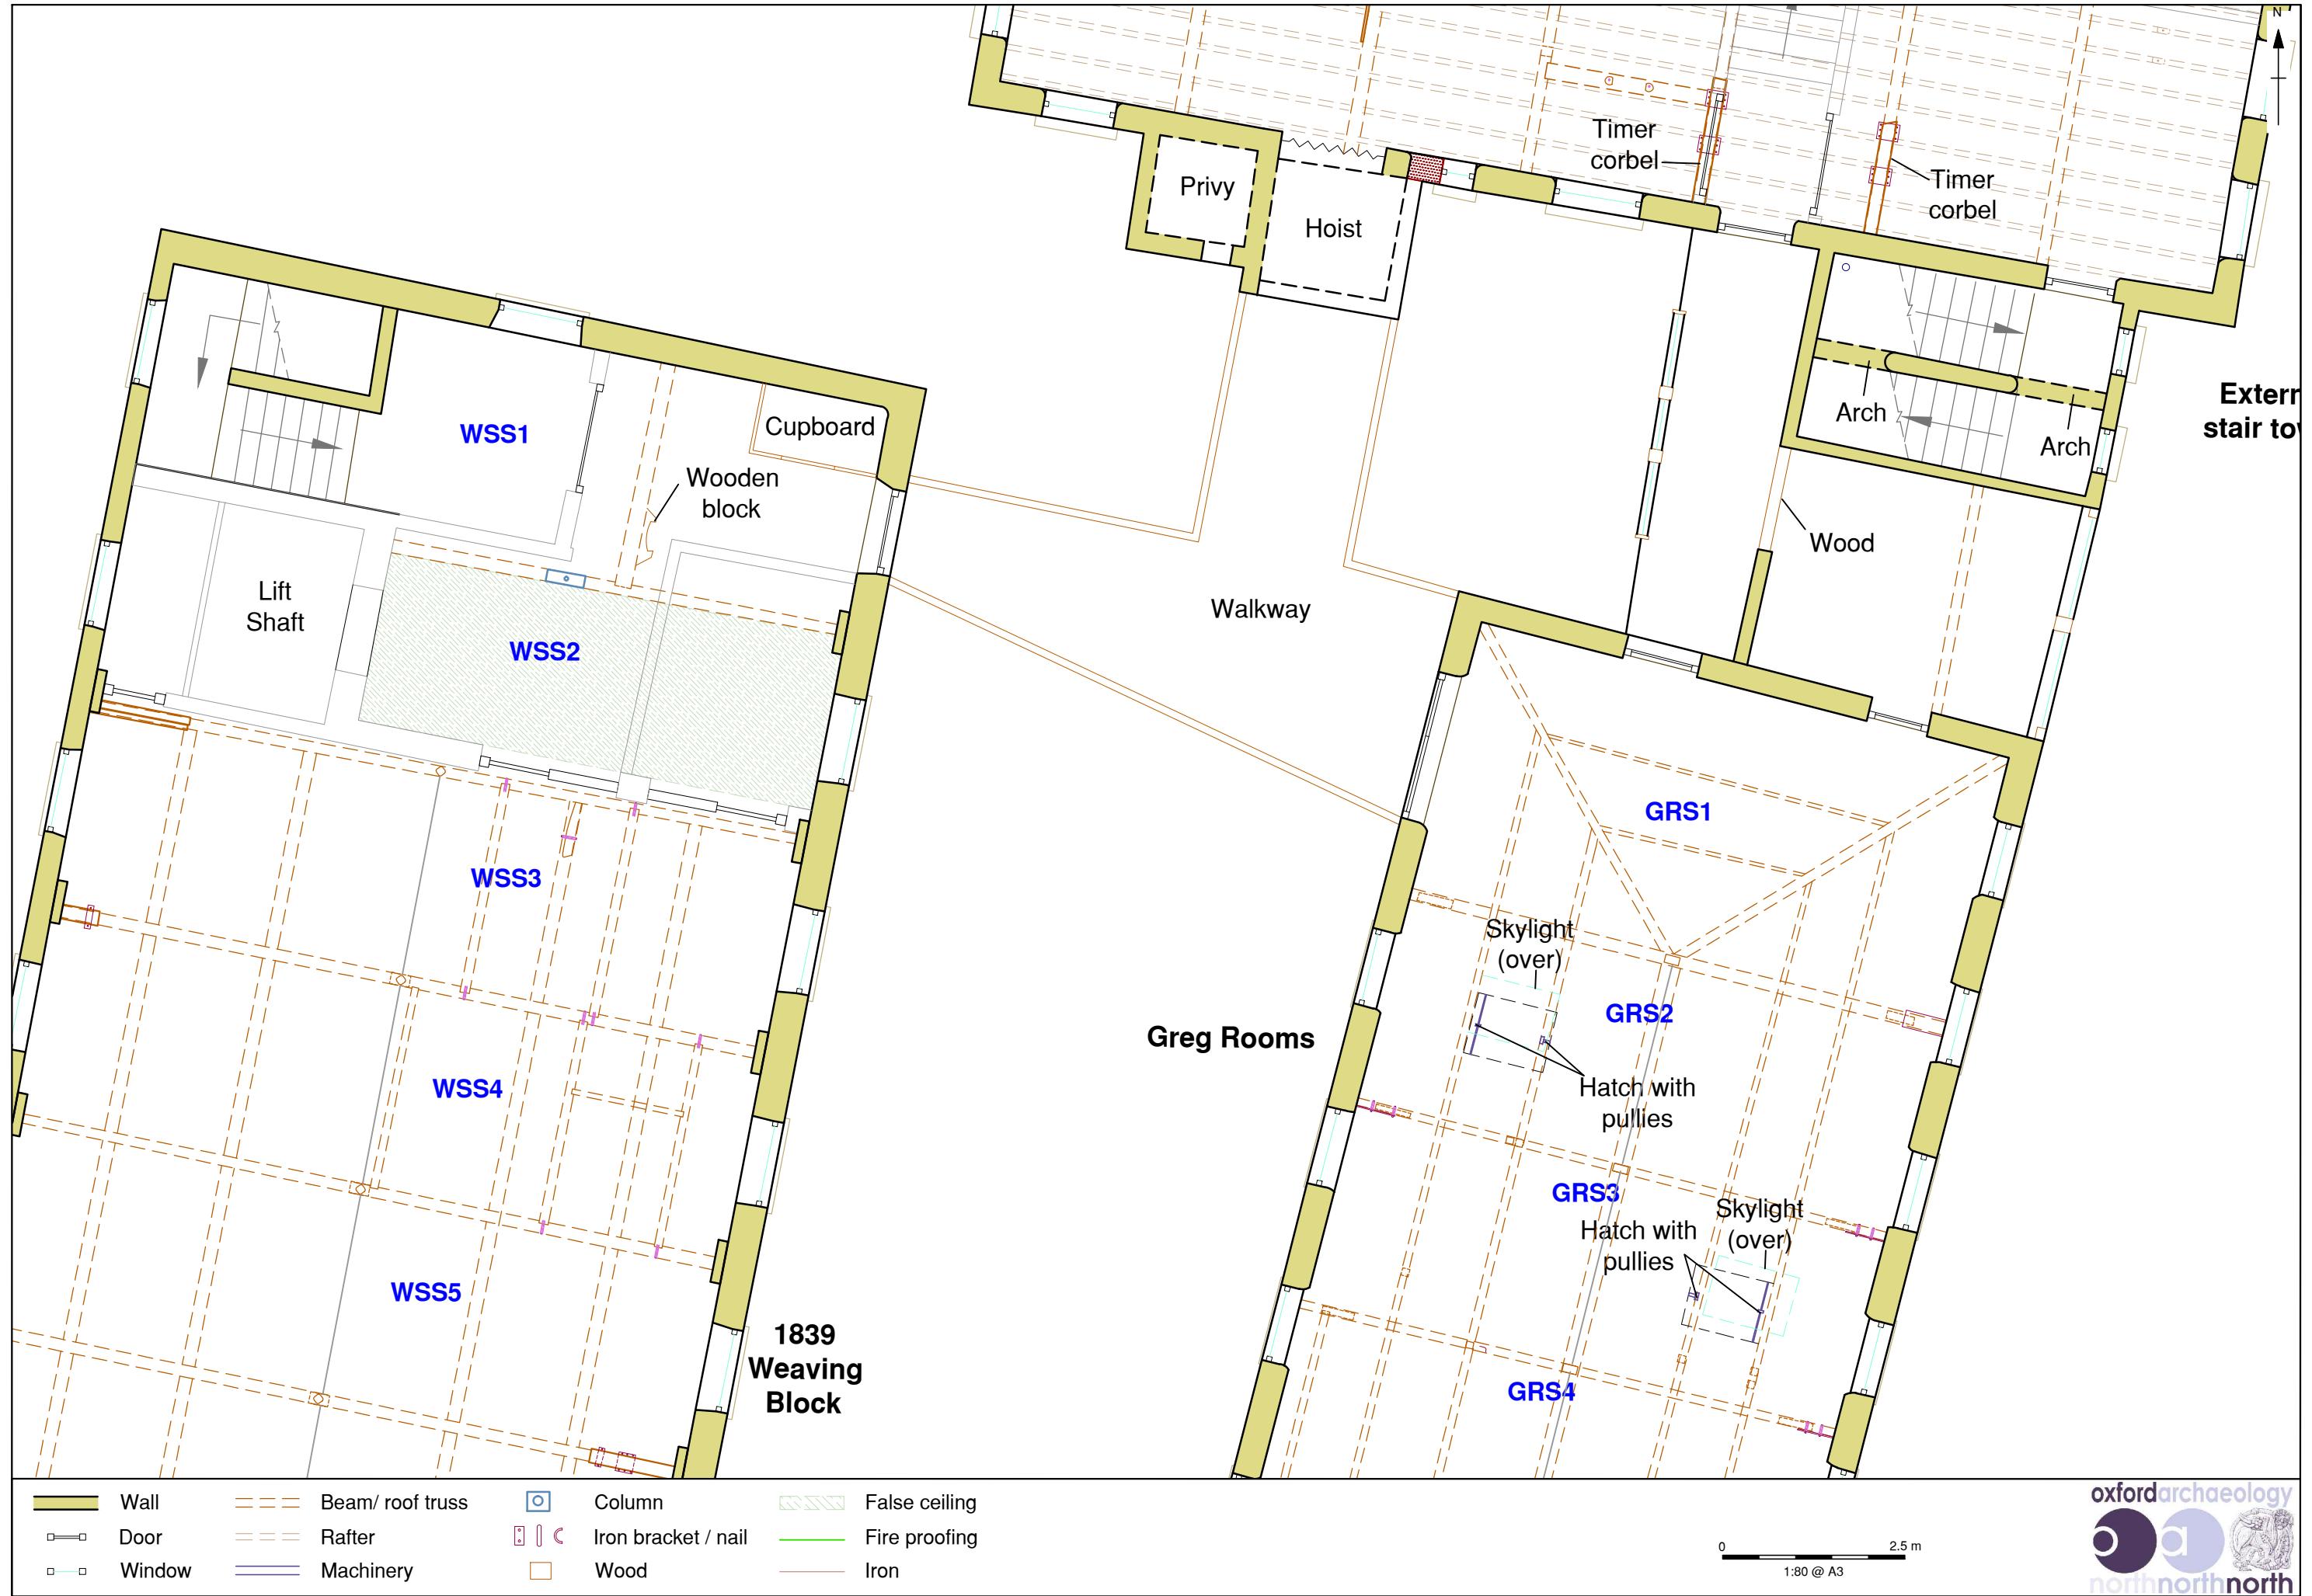


Figure 120: Second Floor - 1839 Weaving Block and Greg Rooms (North)

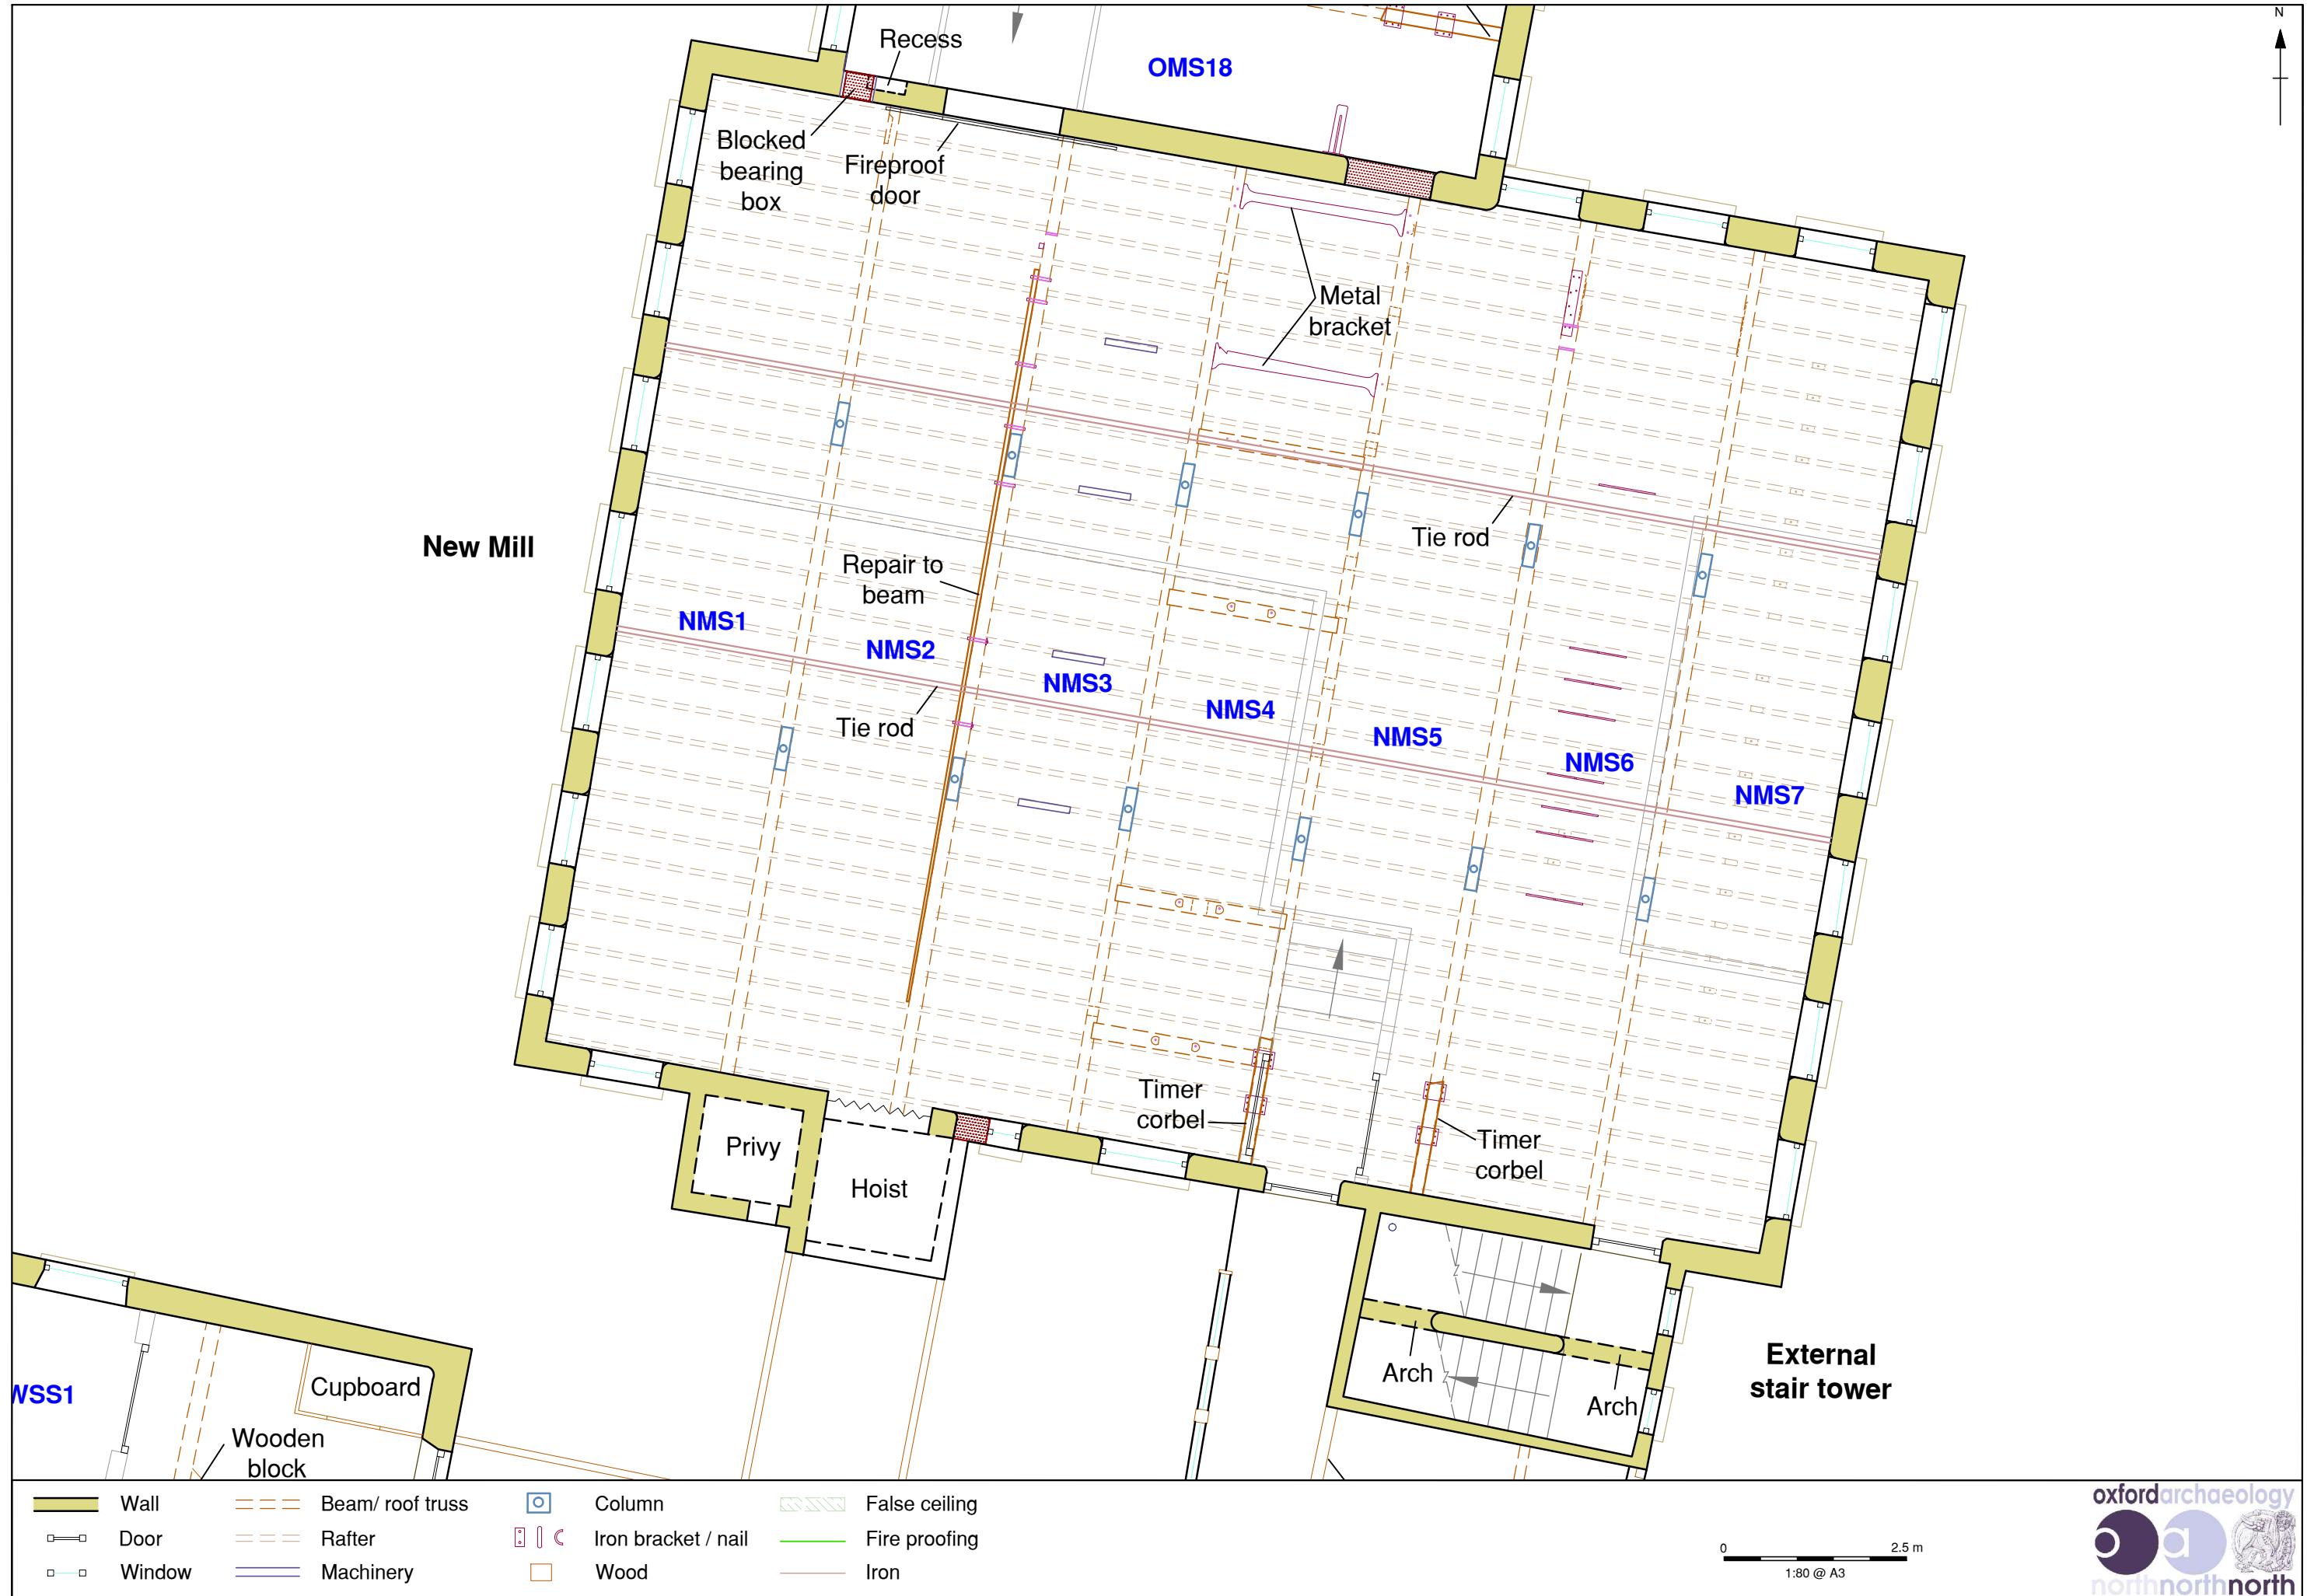


Figure 121: Second Floor - New Mill

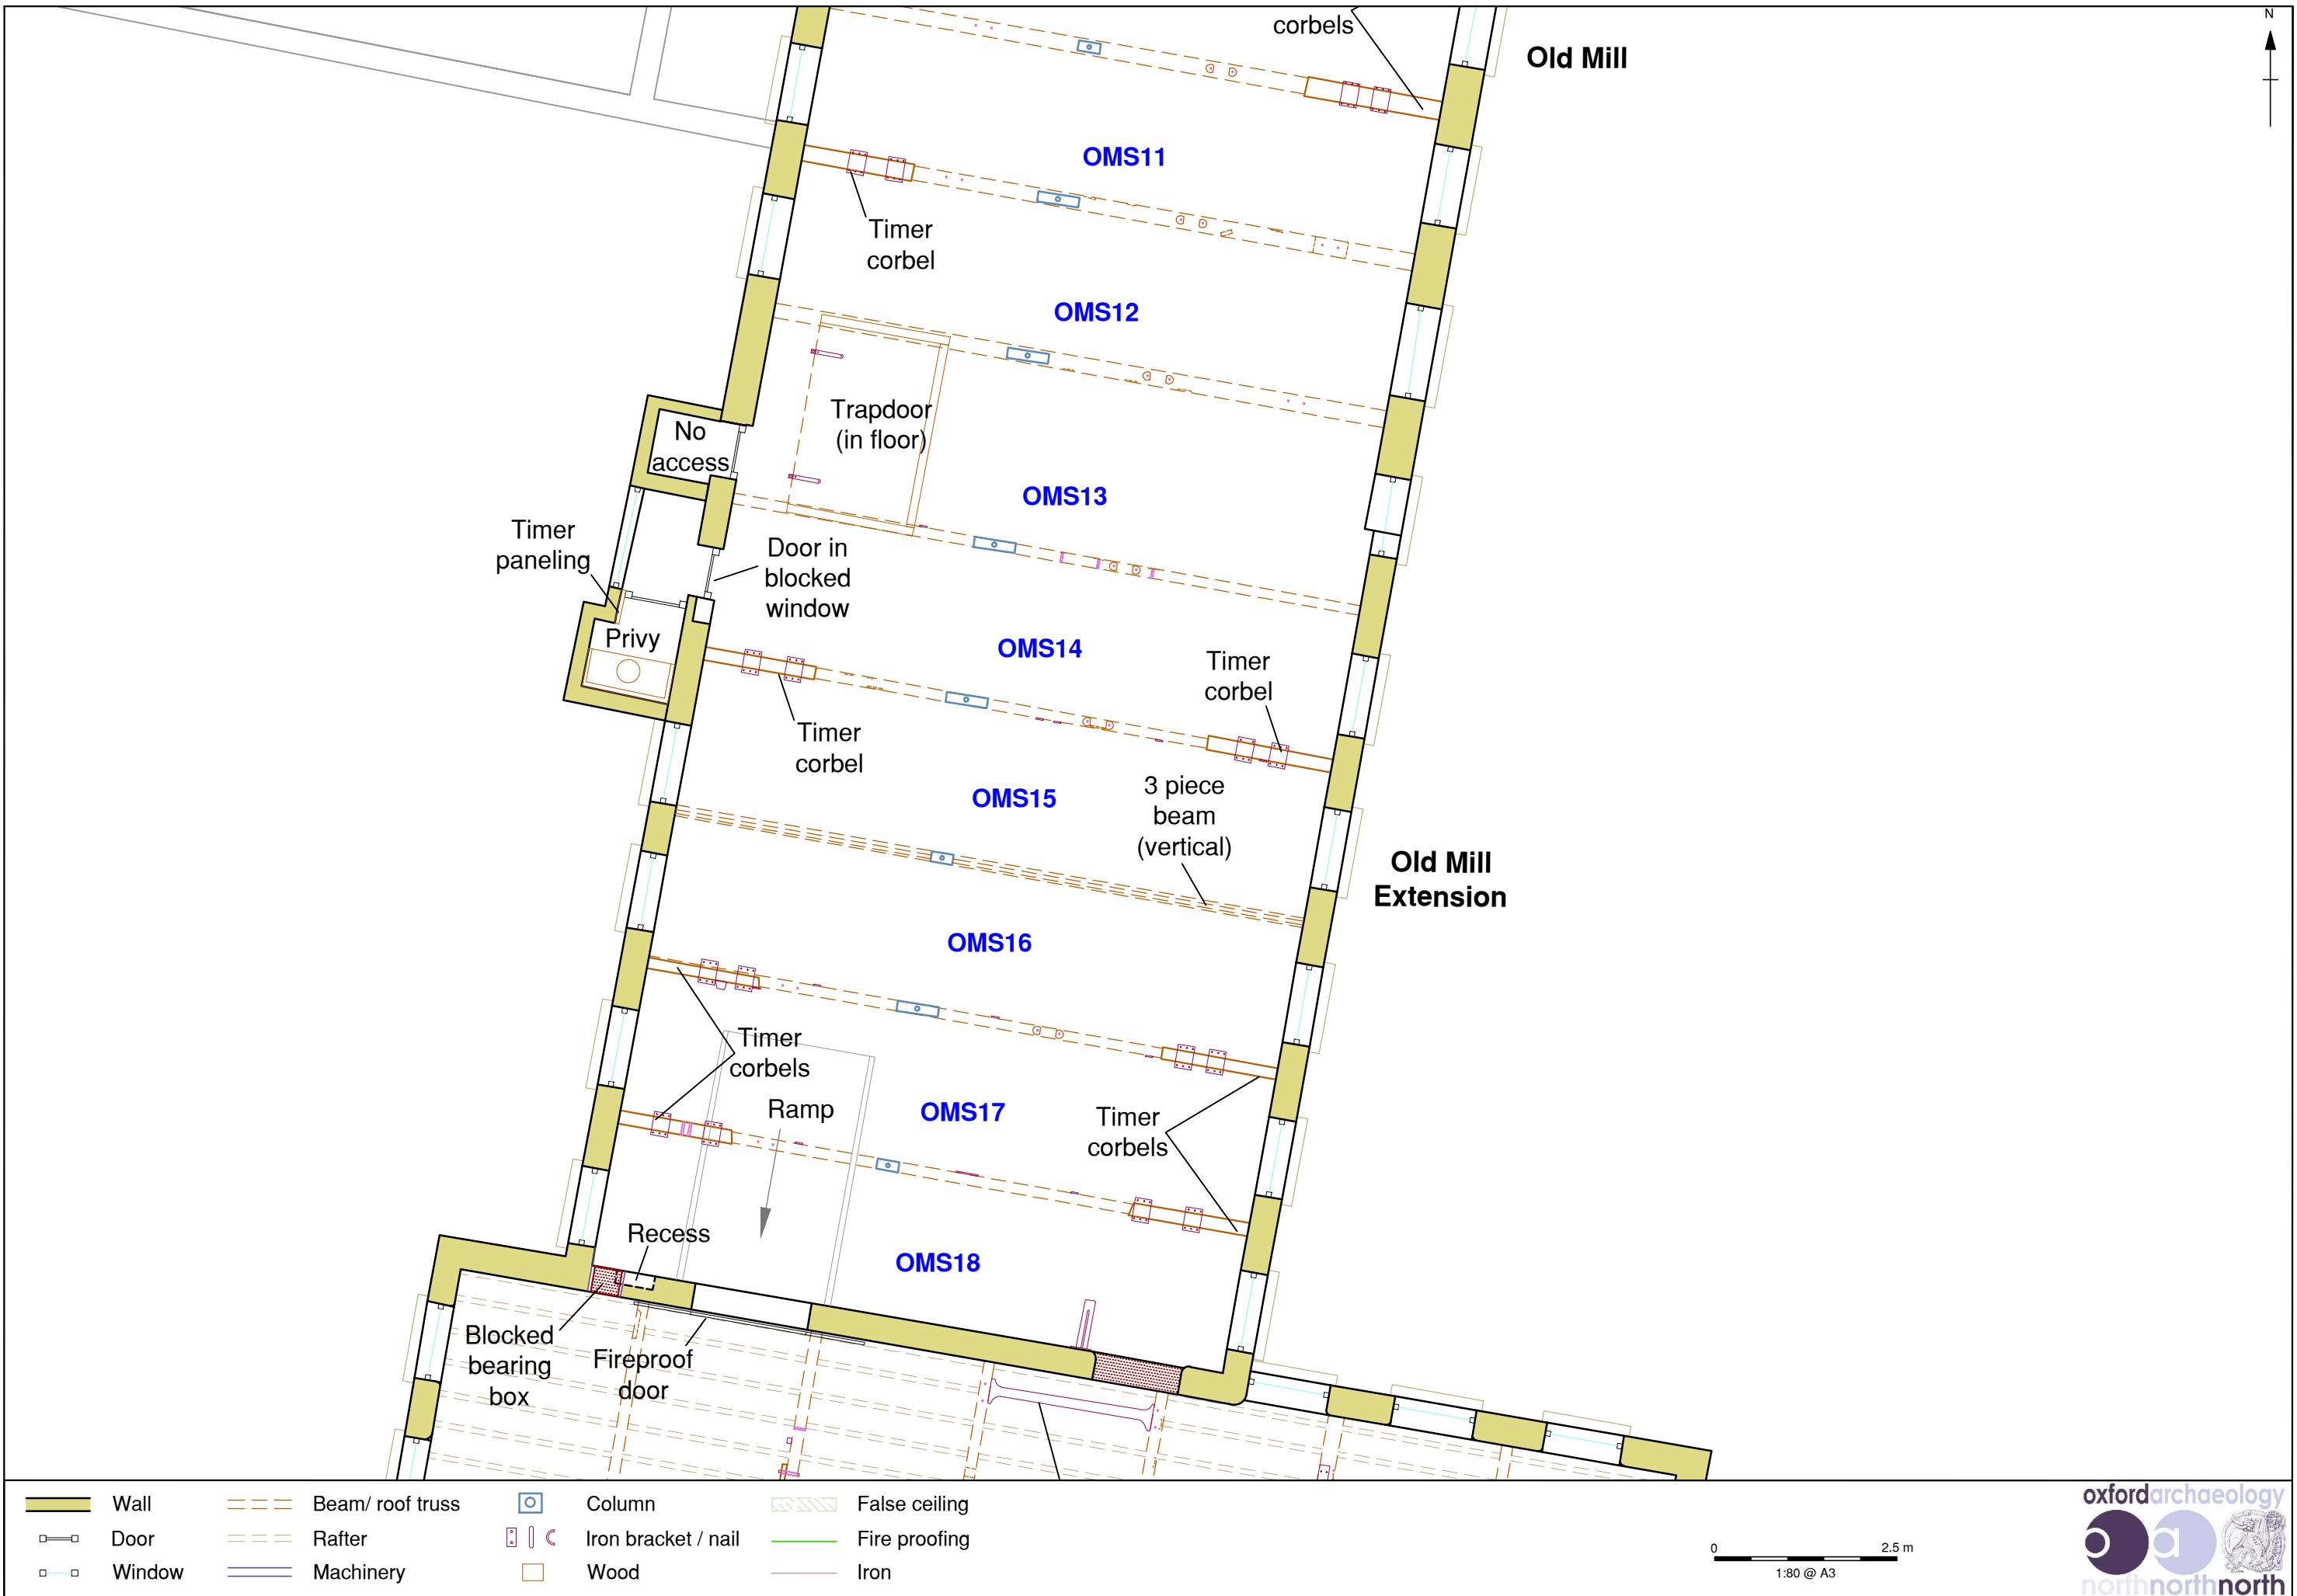


Figure 122: Second Floor - Old Mill Extension

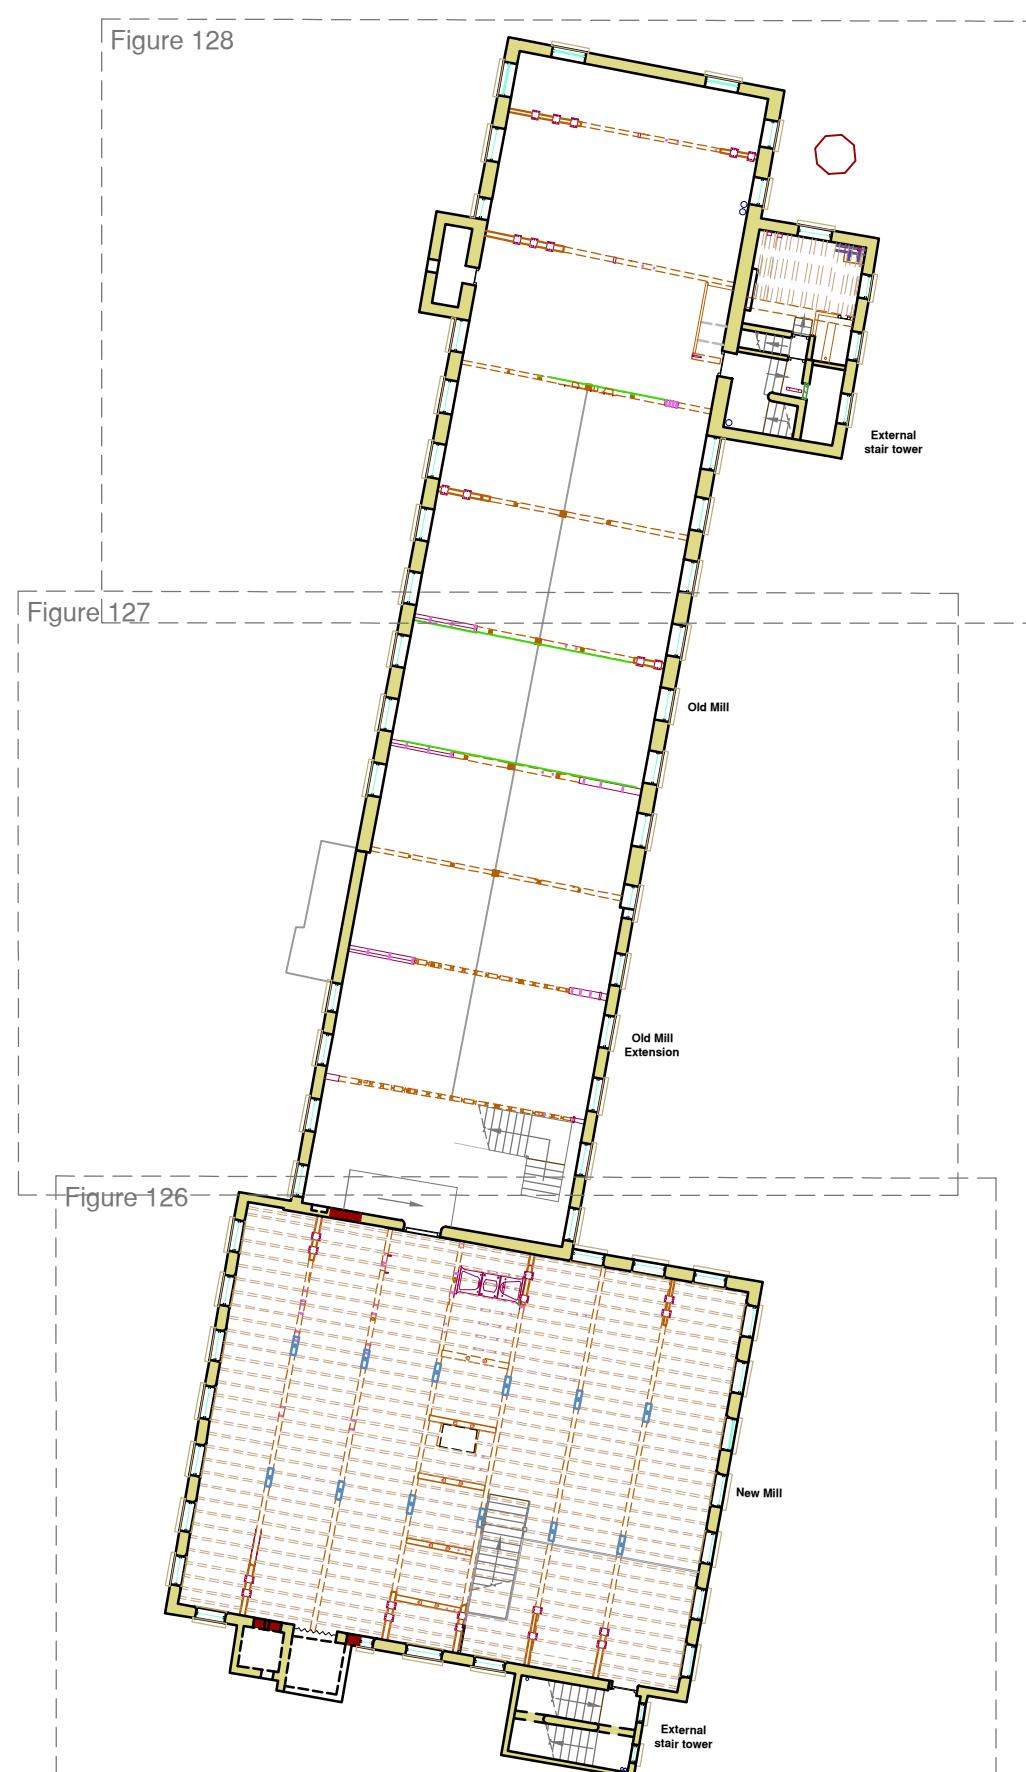


Figure 123: Second Floor - Old Mill




Figure 124: Second Floor - Old Mill North


N



0 5 m
1:250 @ A3

Figure 125: Quarry Bank Mill Overall Third Floor Plan

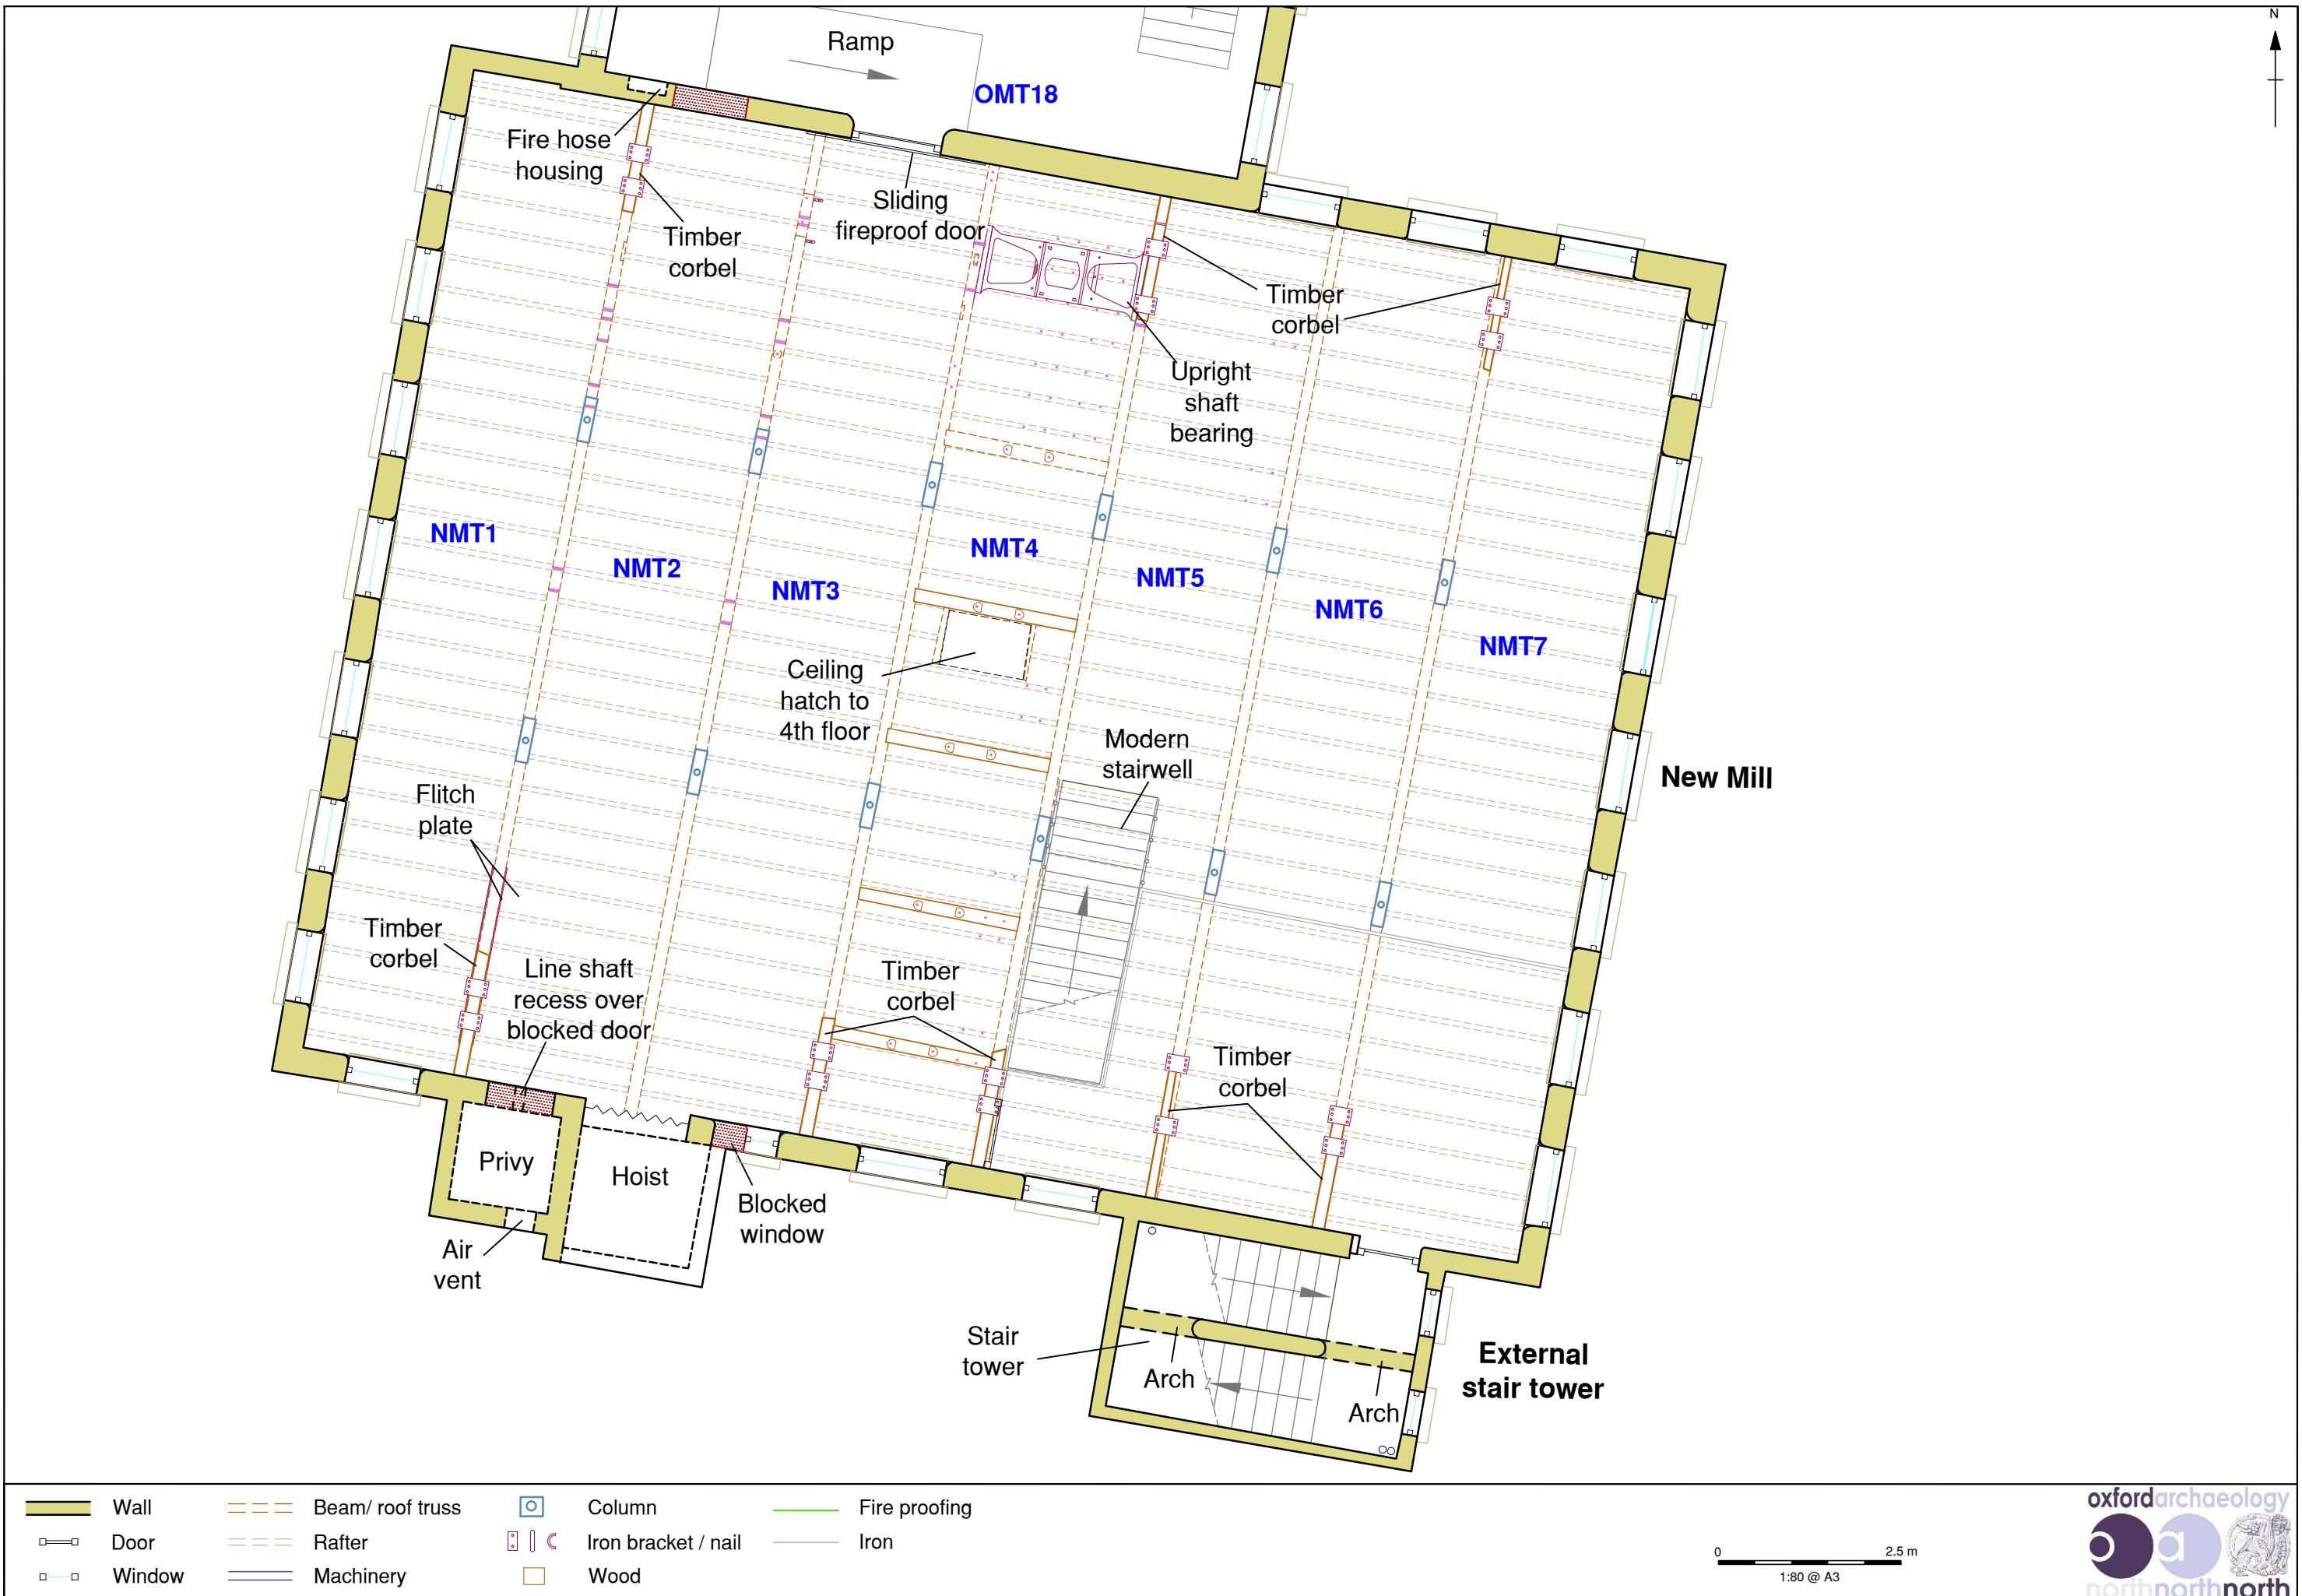

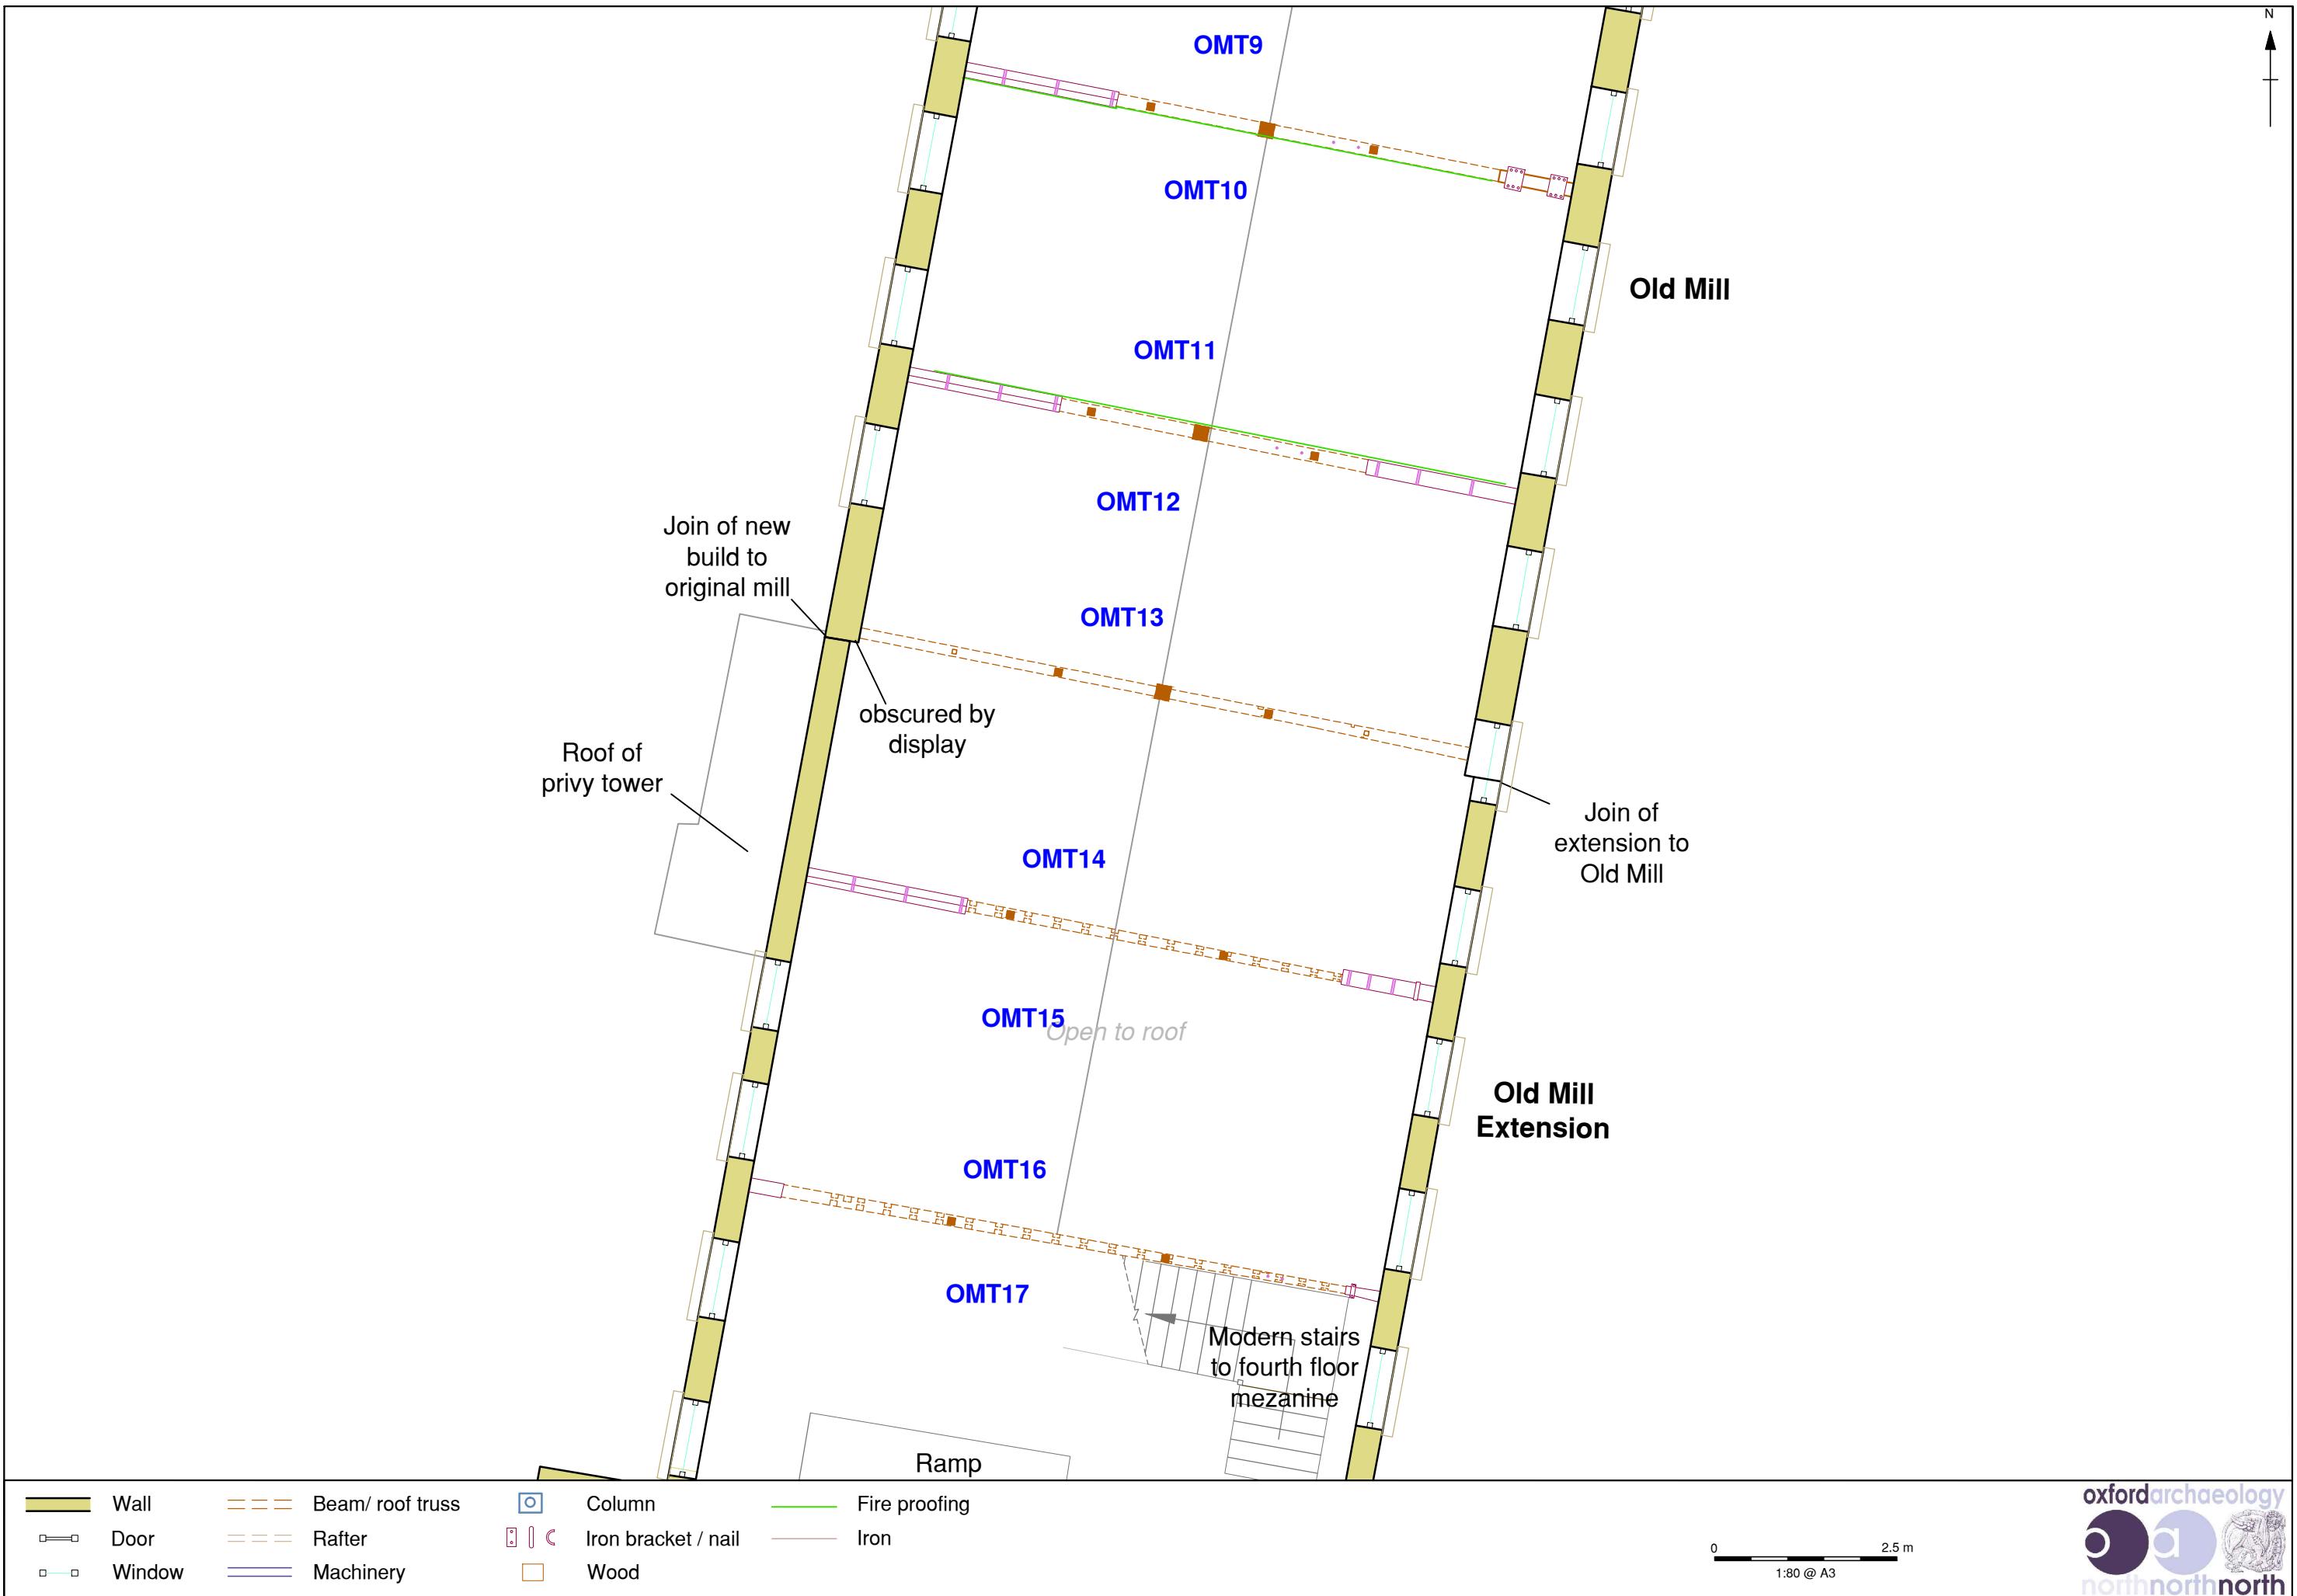


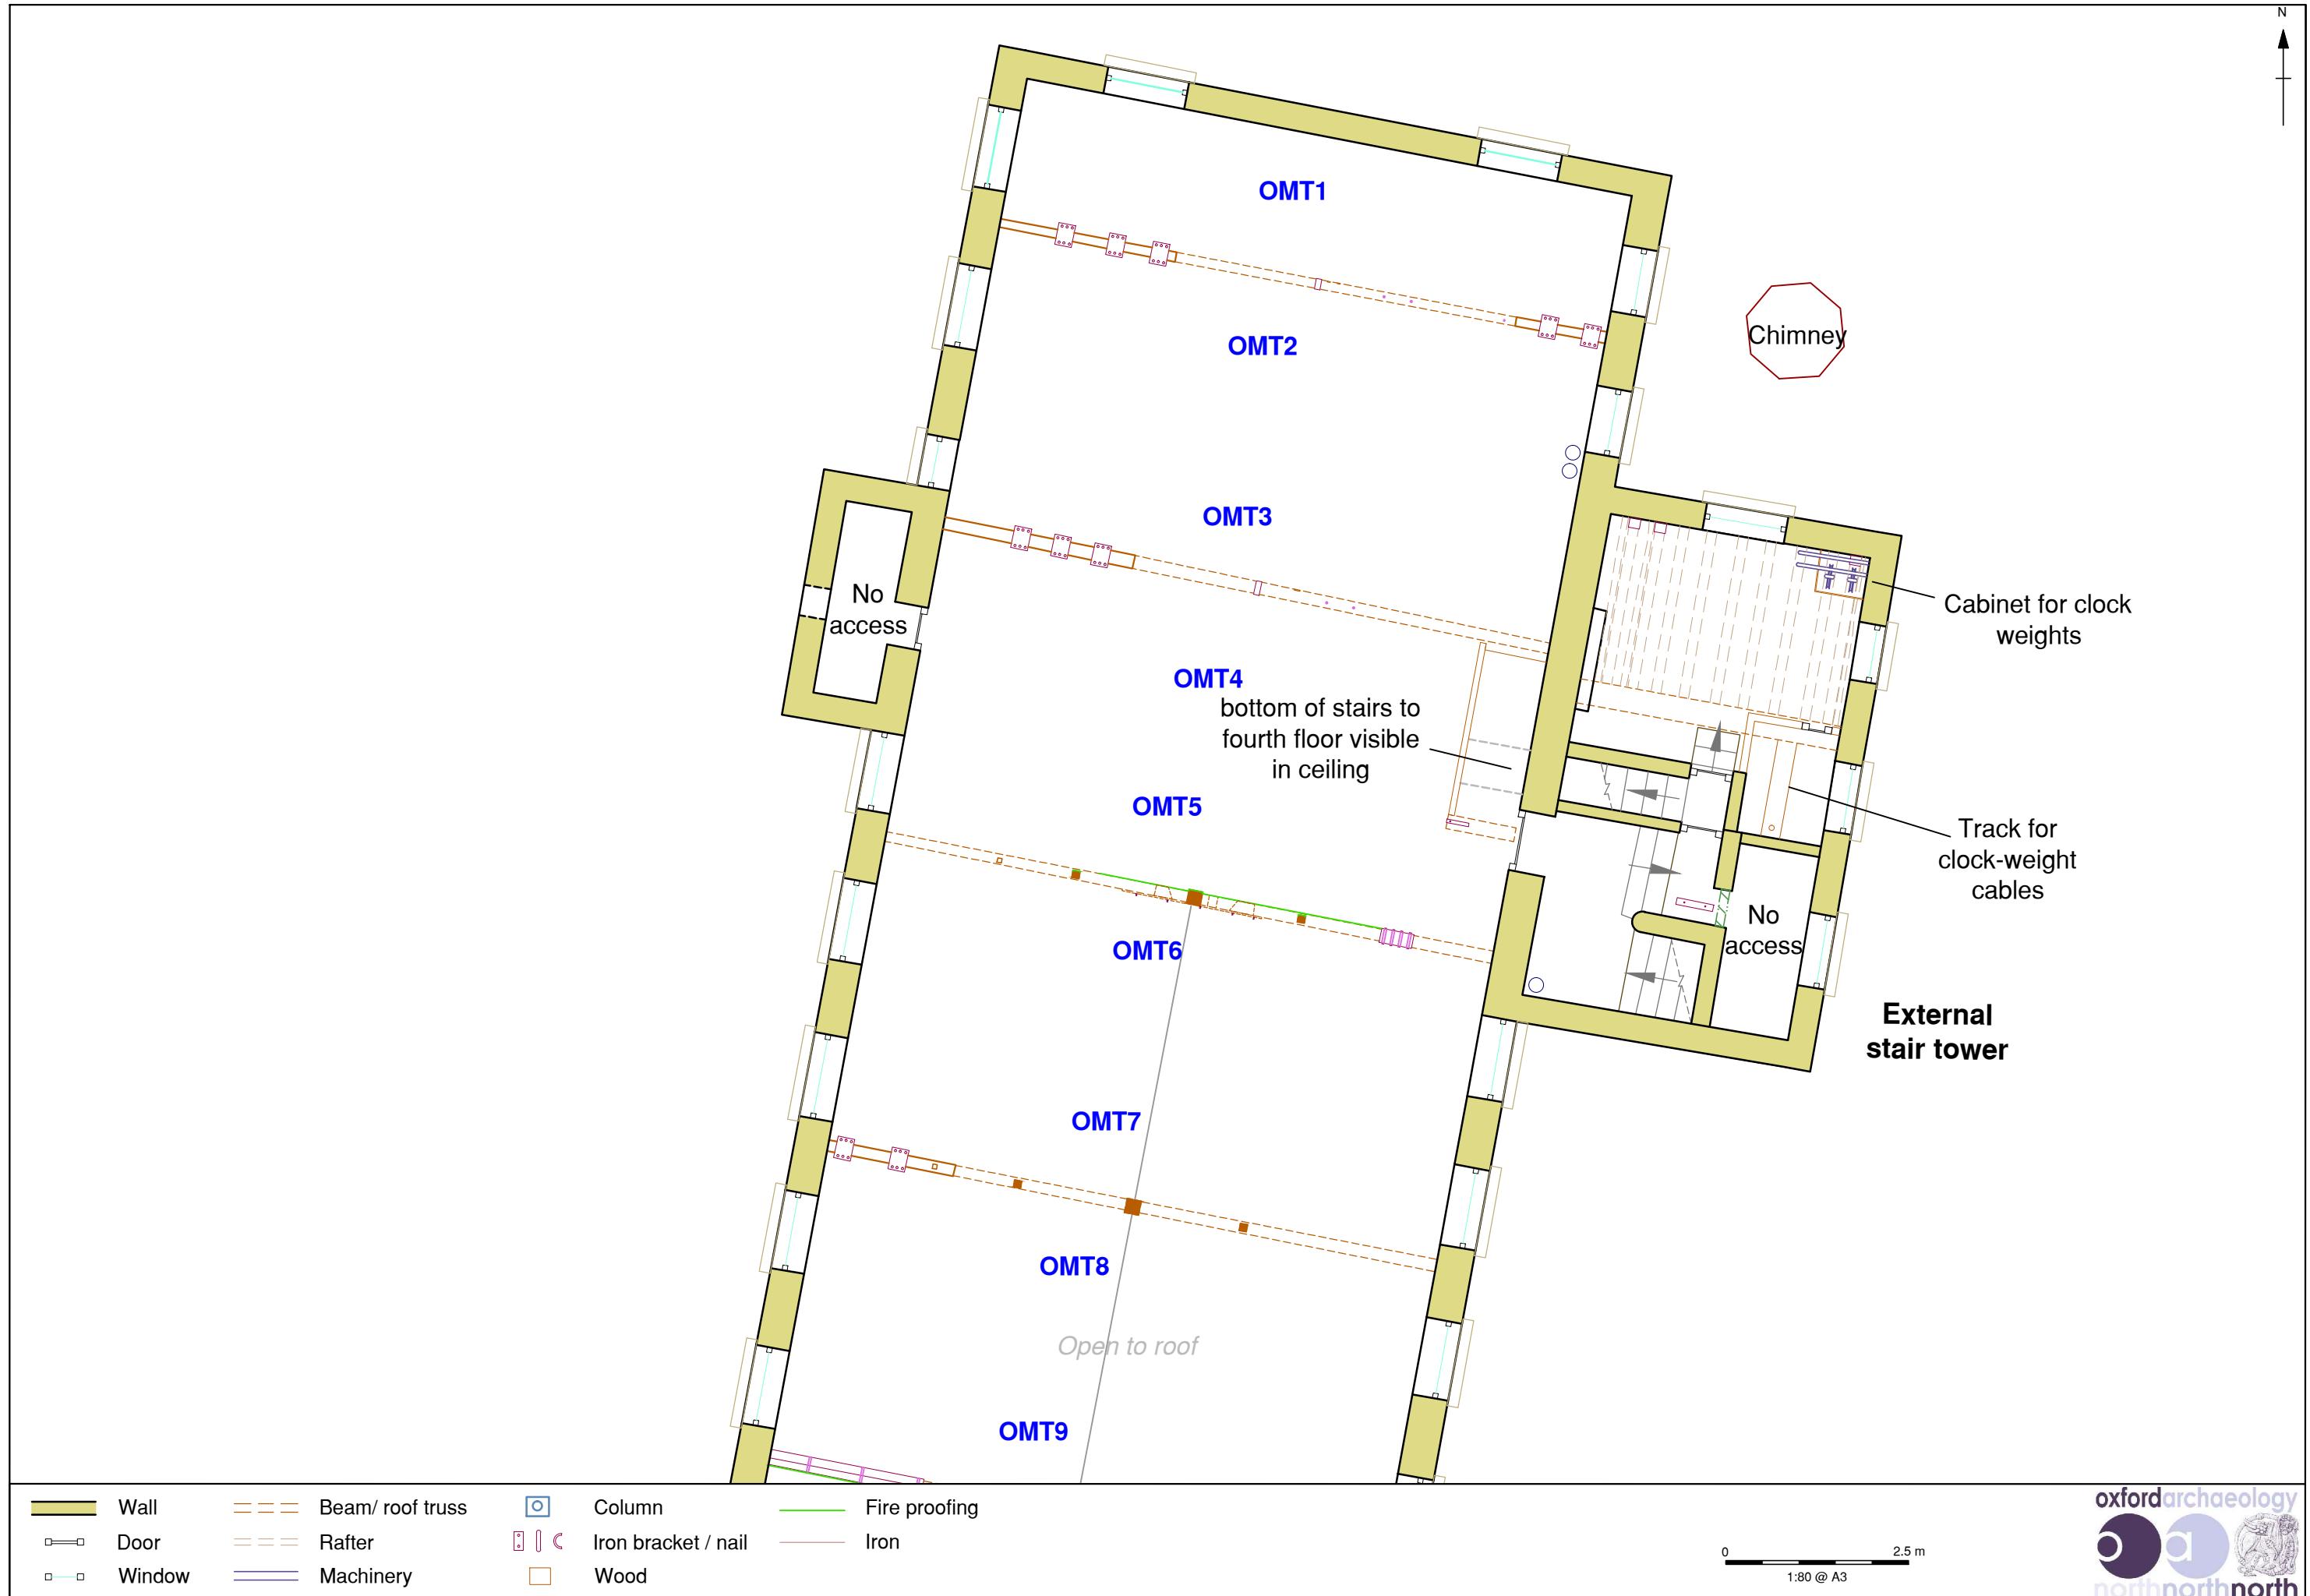


Fig 128: Third Floor - Old Mill North

N

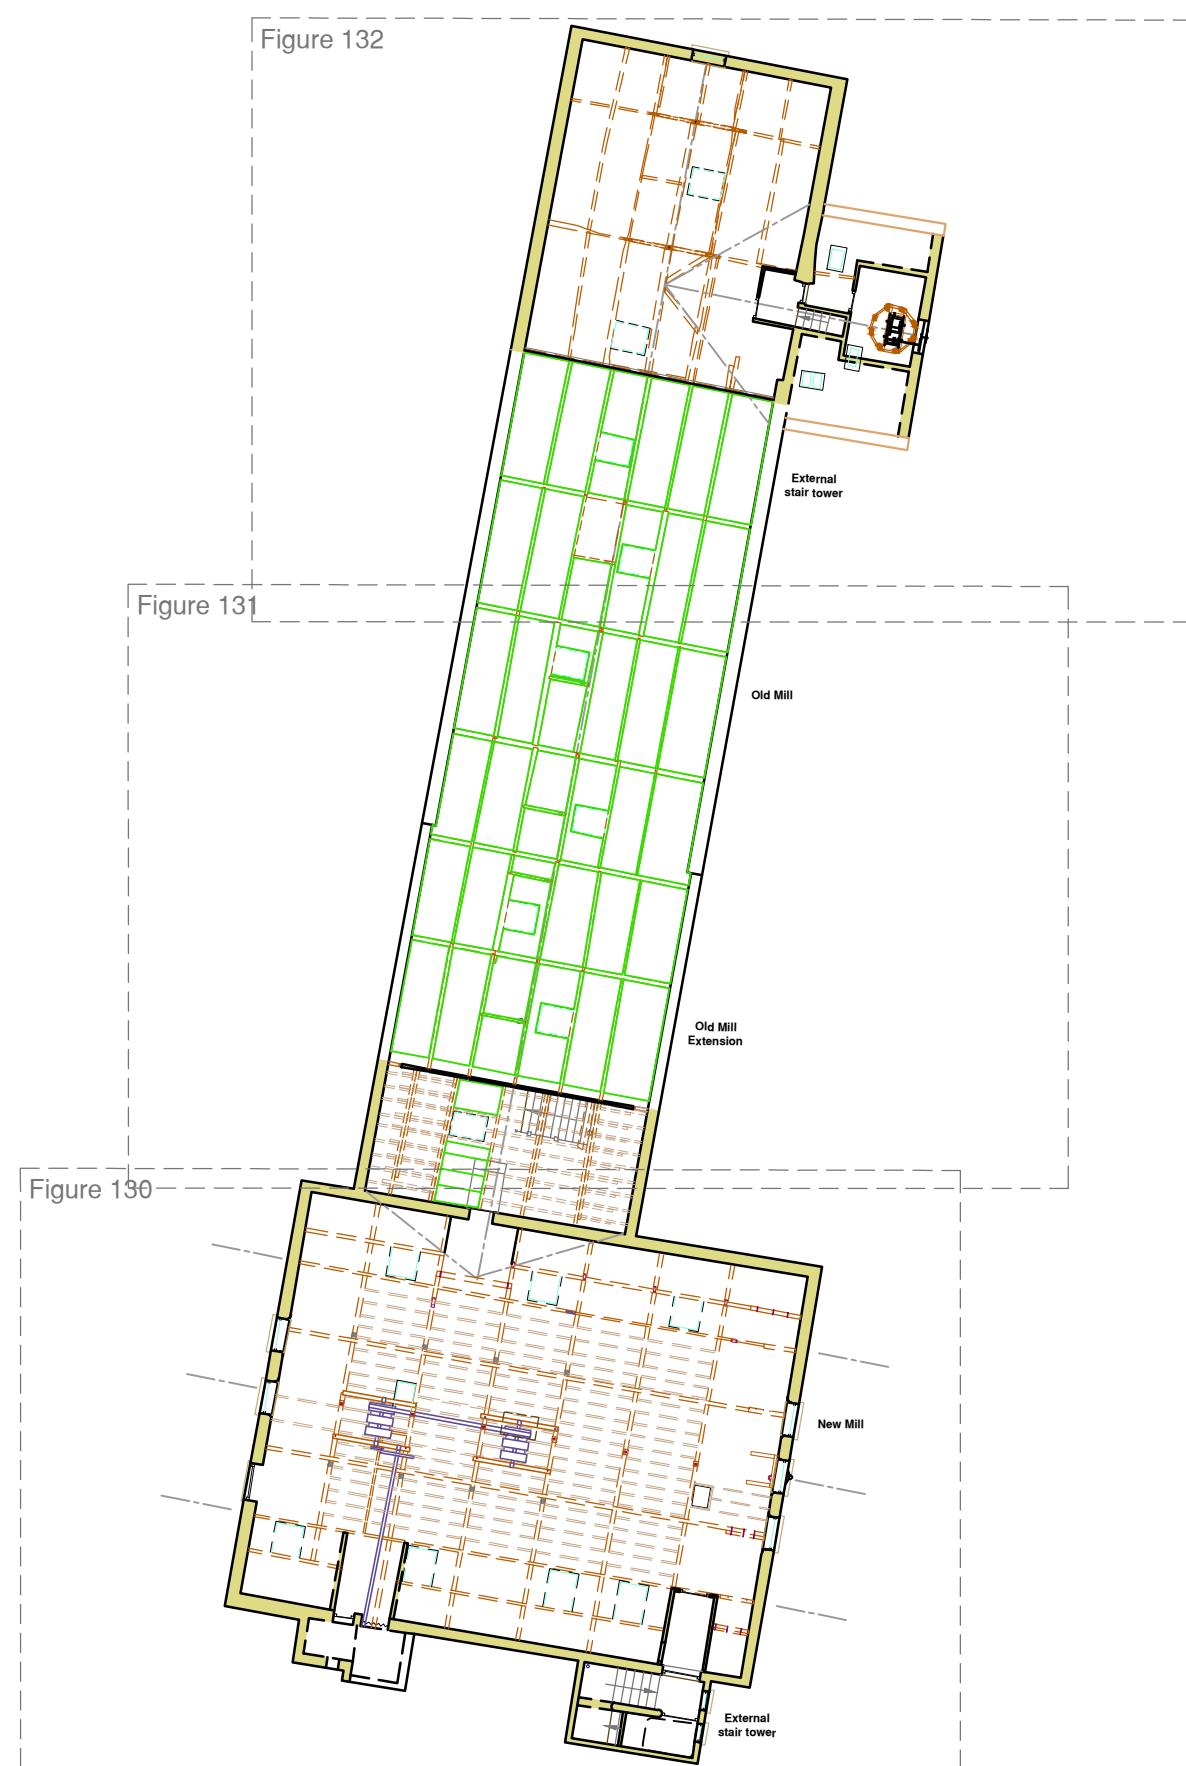

Wall	Beam/ roof truss	Column	Fire proofing
Door	Rafter	Iron bracket / nail	Iron
Window	Machinery	Wood	

0 5 m
1:250 @ A3

Figure 129: Quarry Bank Mill Overall Fourth Floor Plan

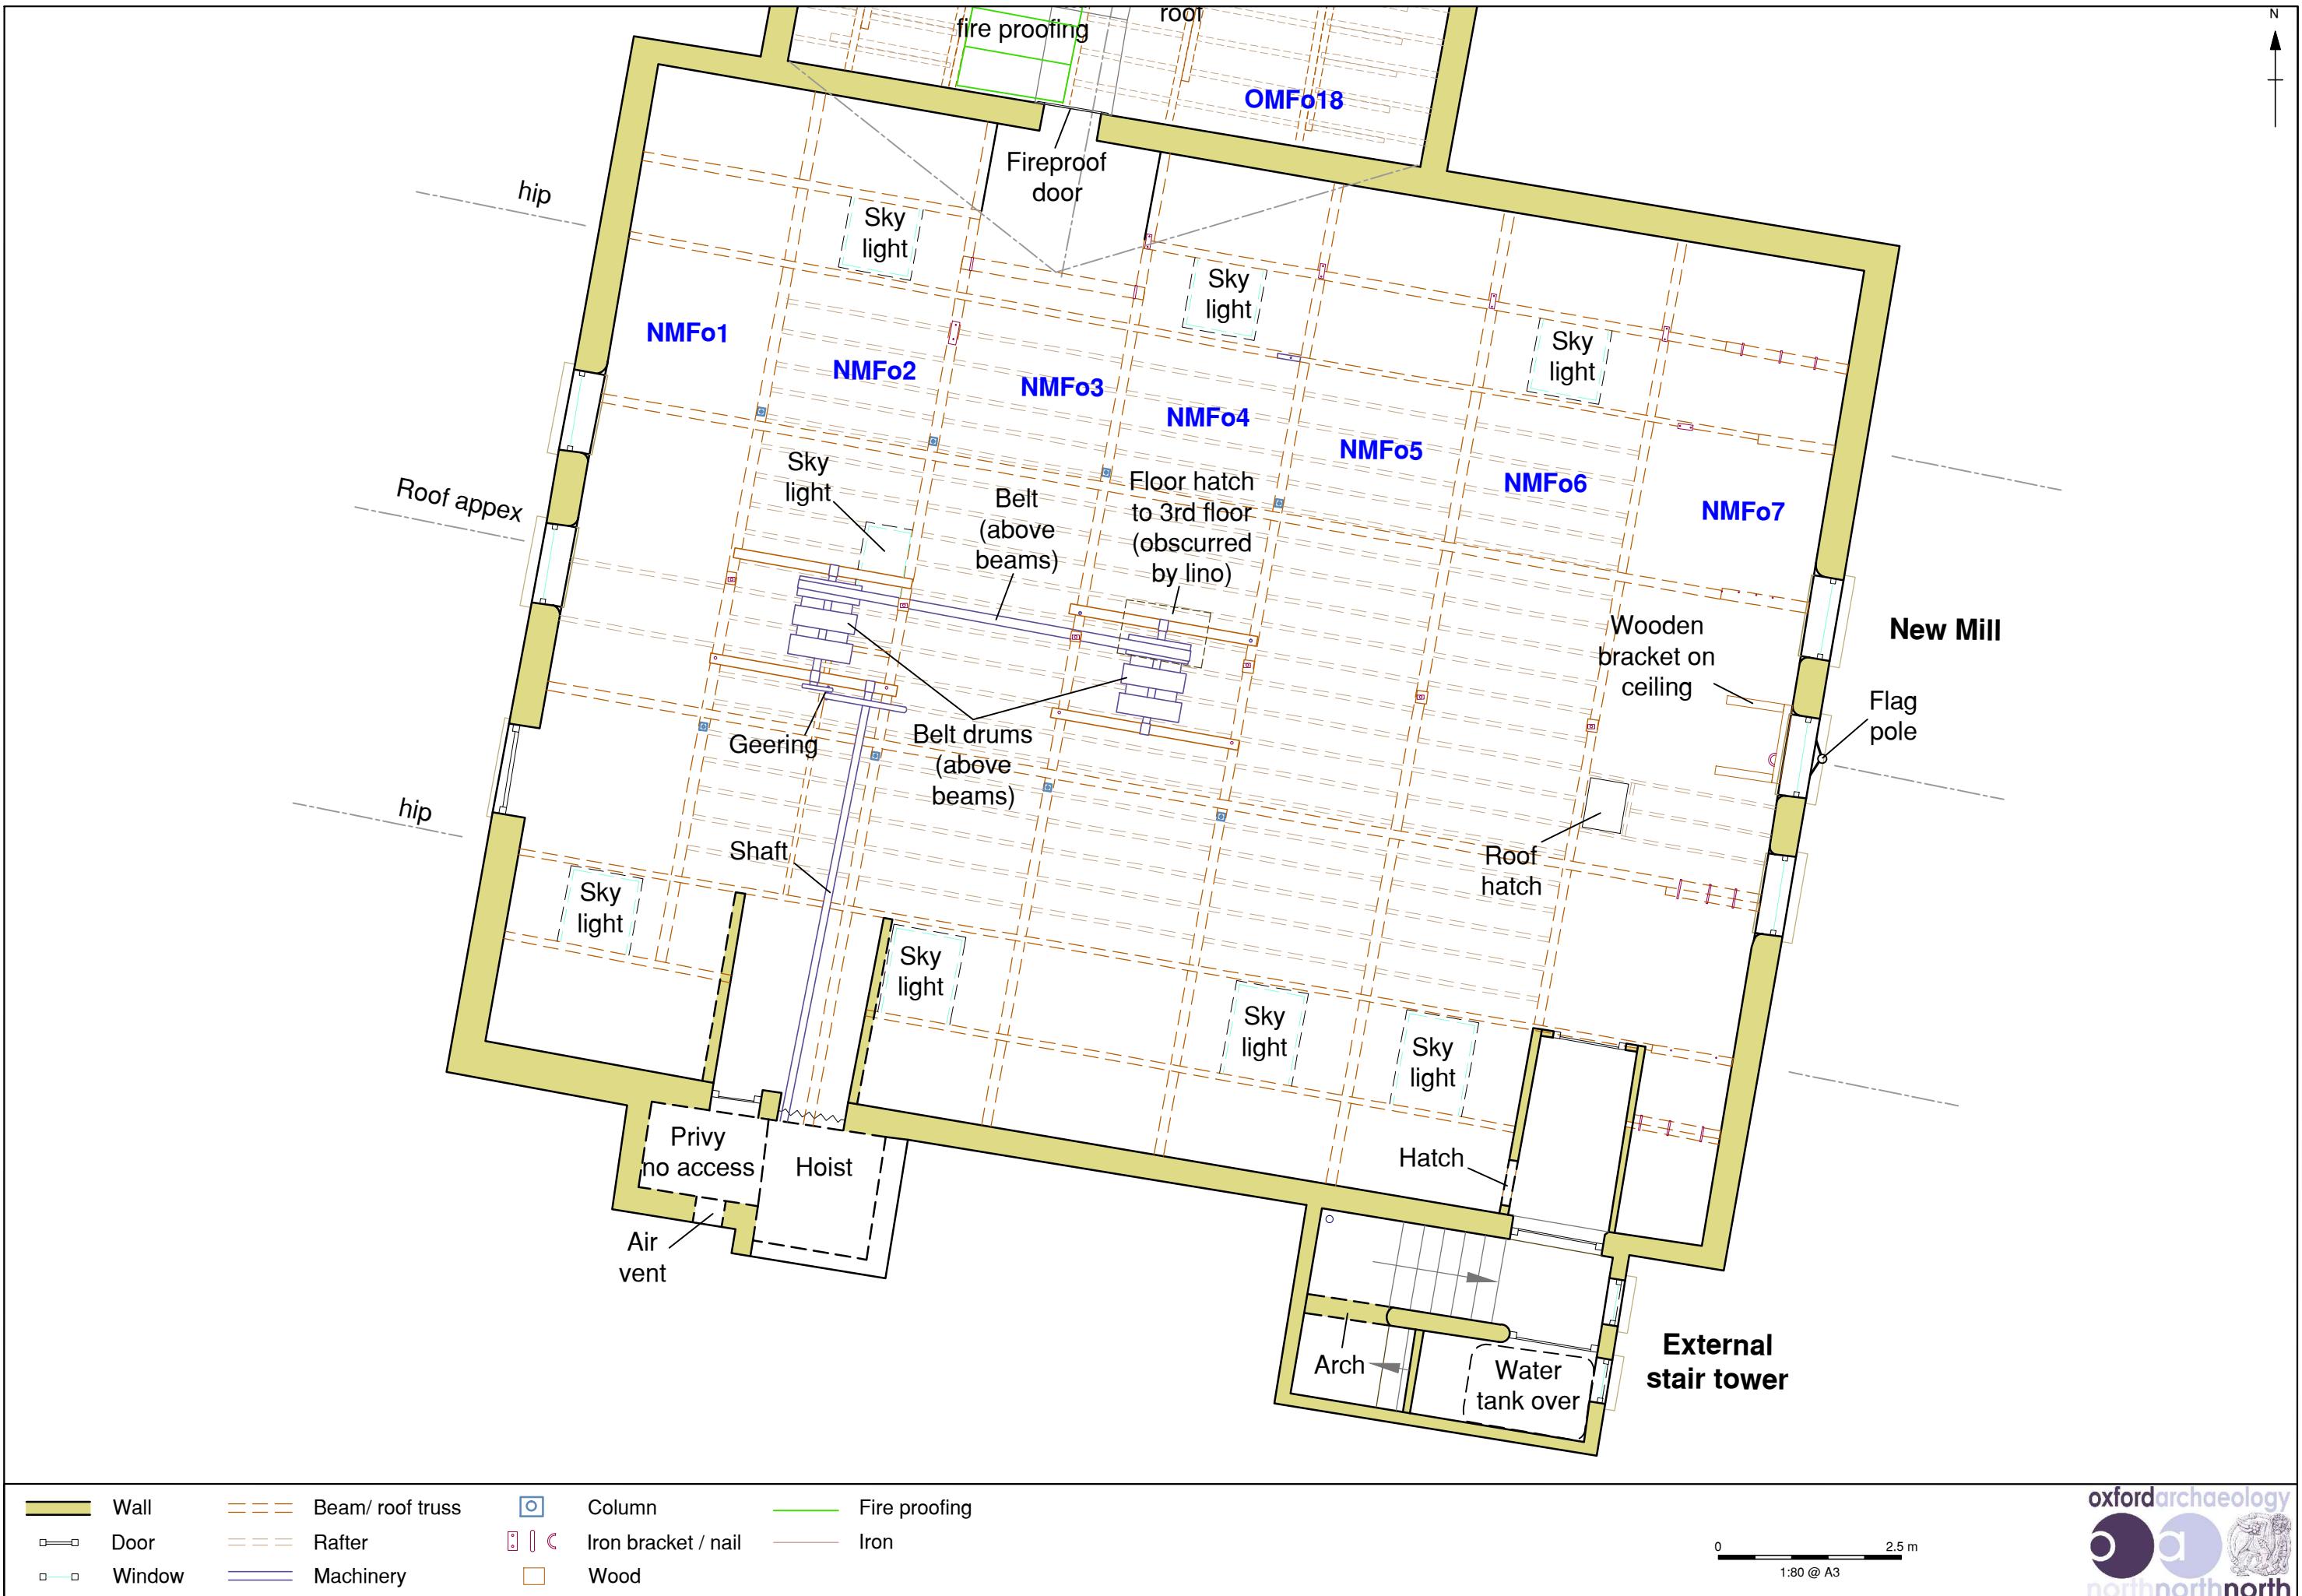


Figure 130: Fourth Floor - New Mill

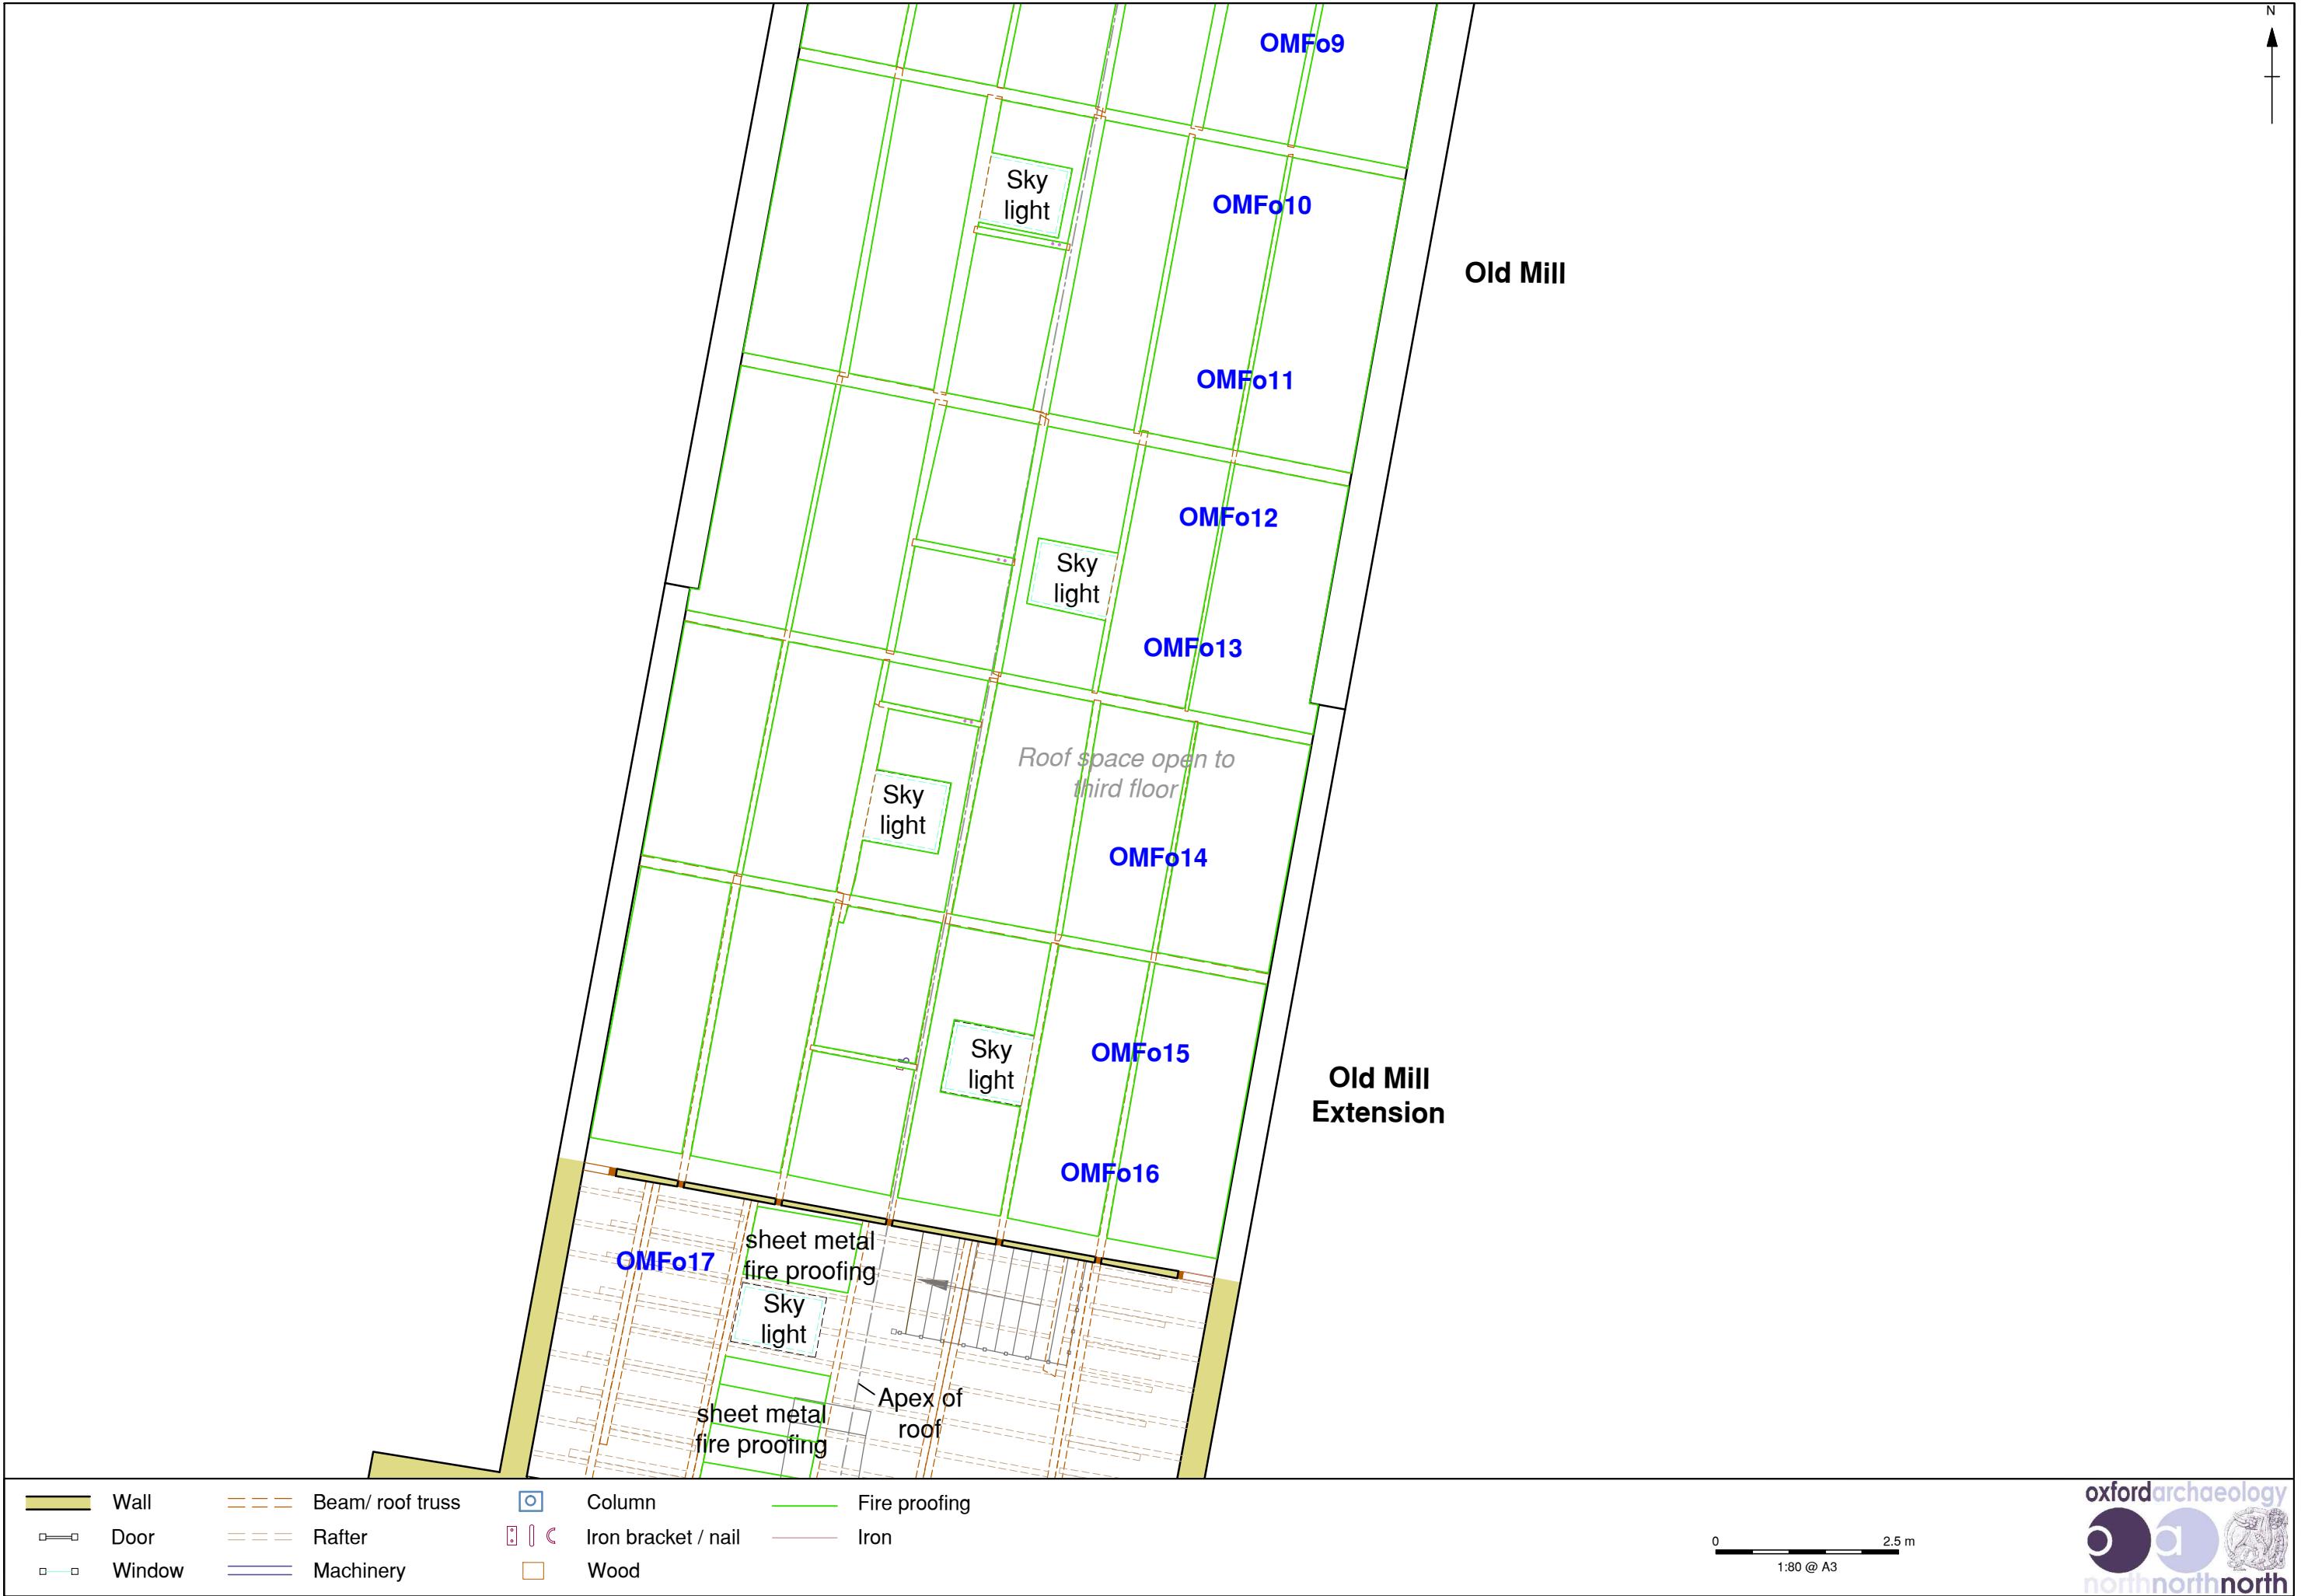


Figure 131: Fourth Floor - Old Mill Extension

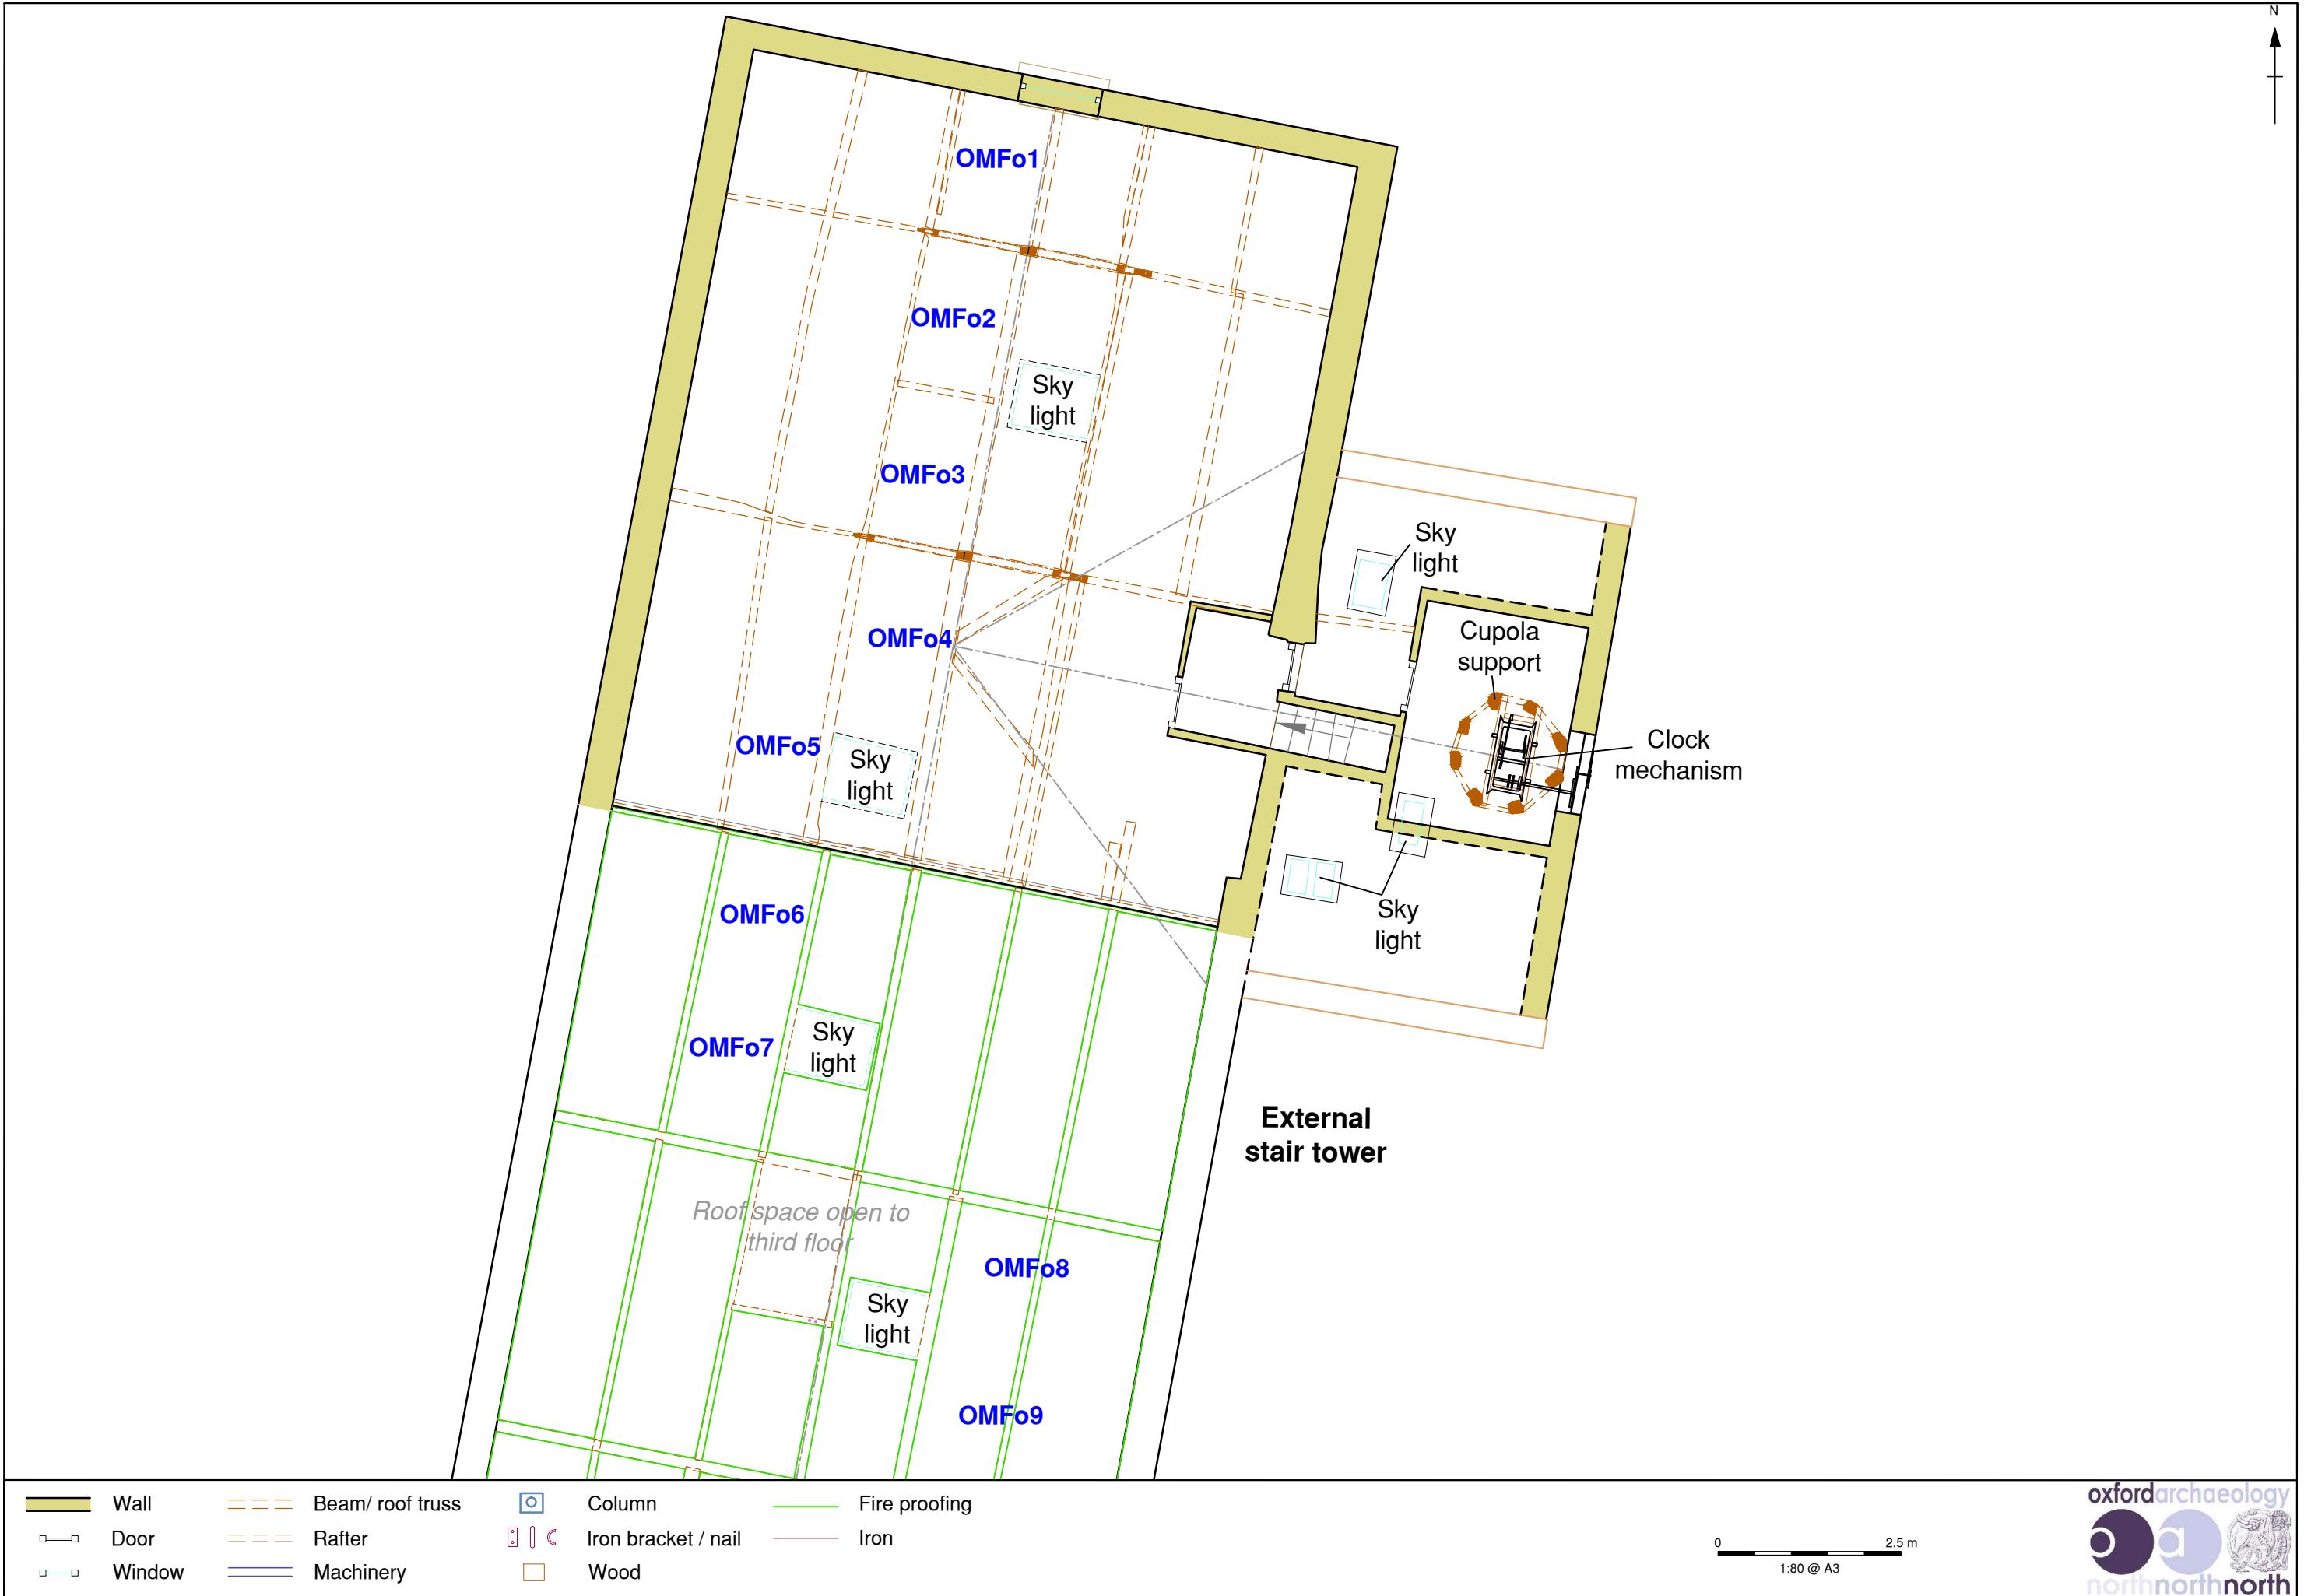


Figure 132: Fourth Floor - Old Mill (North)

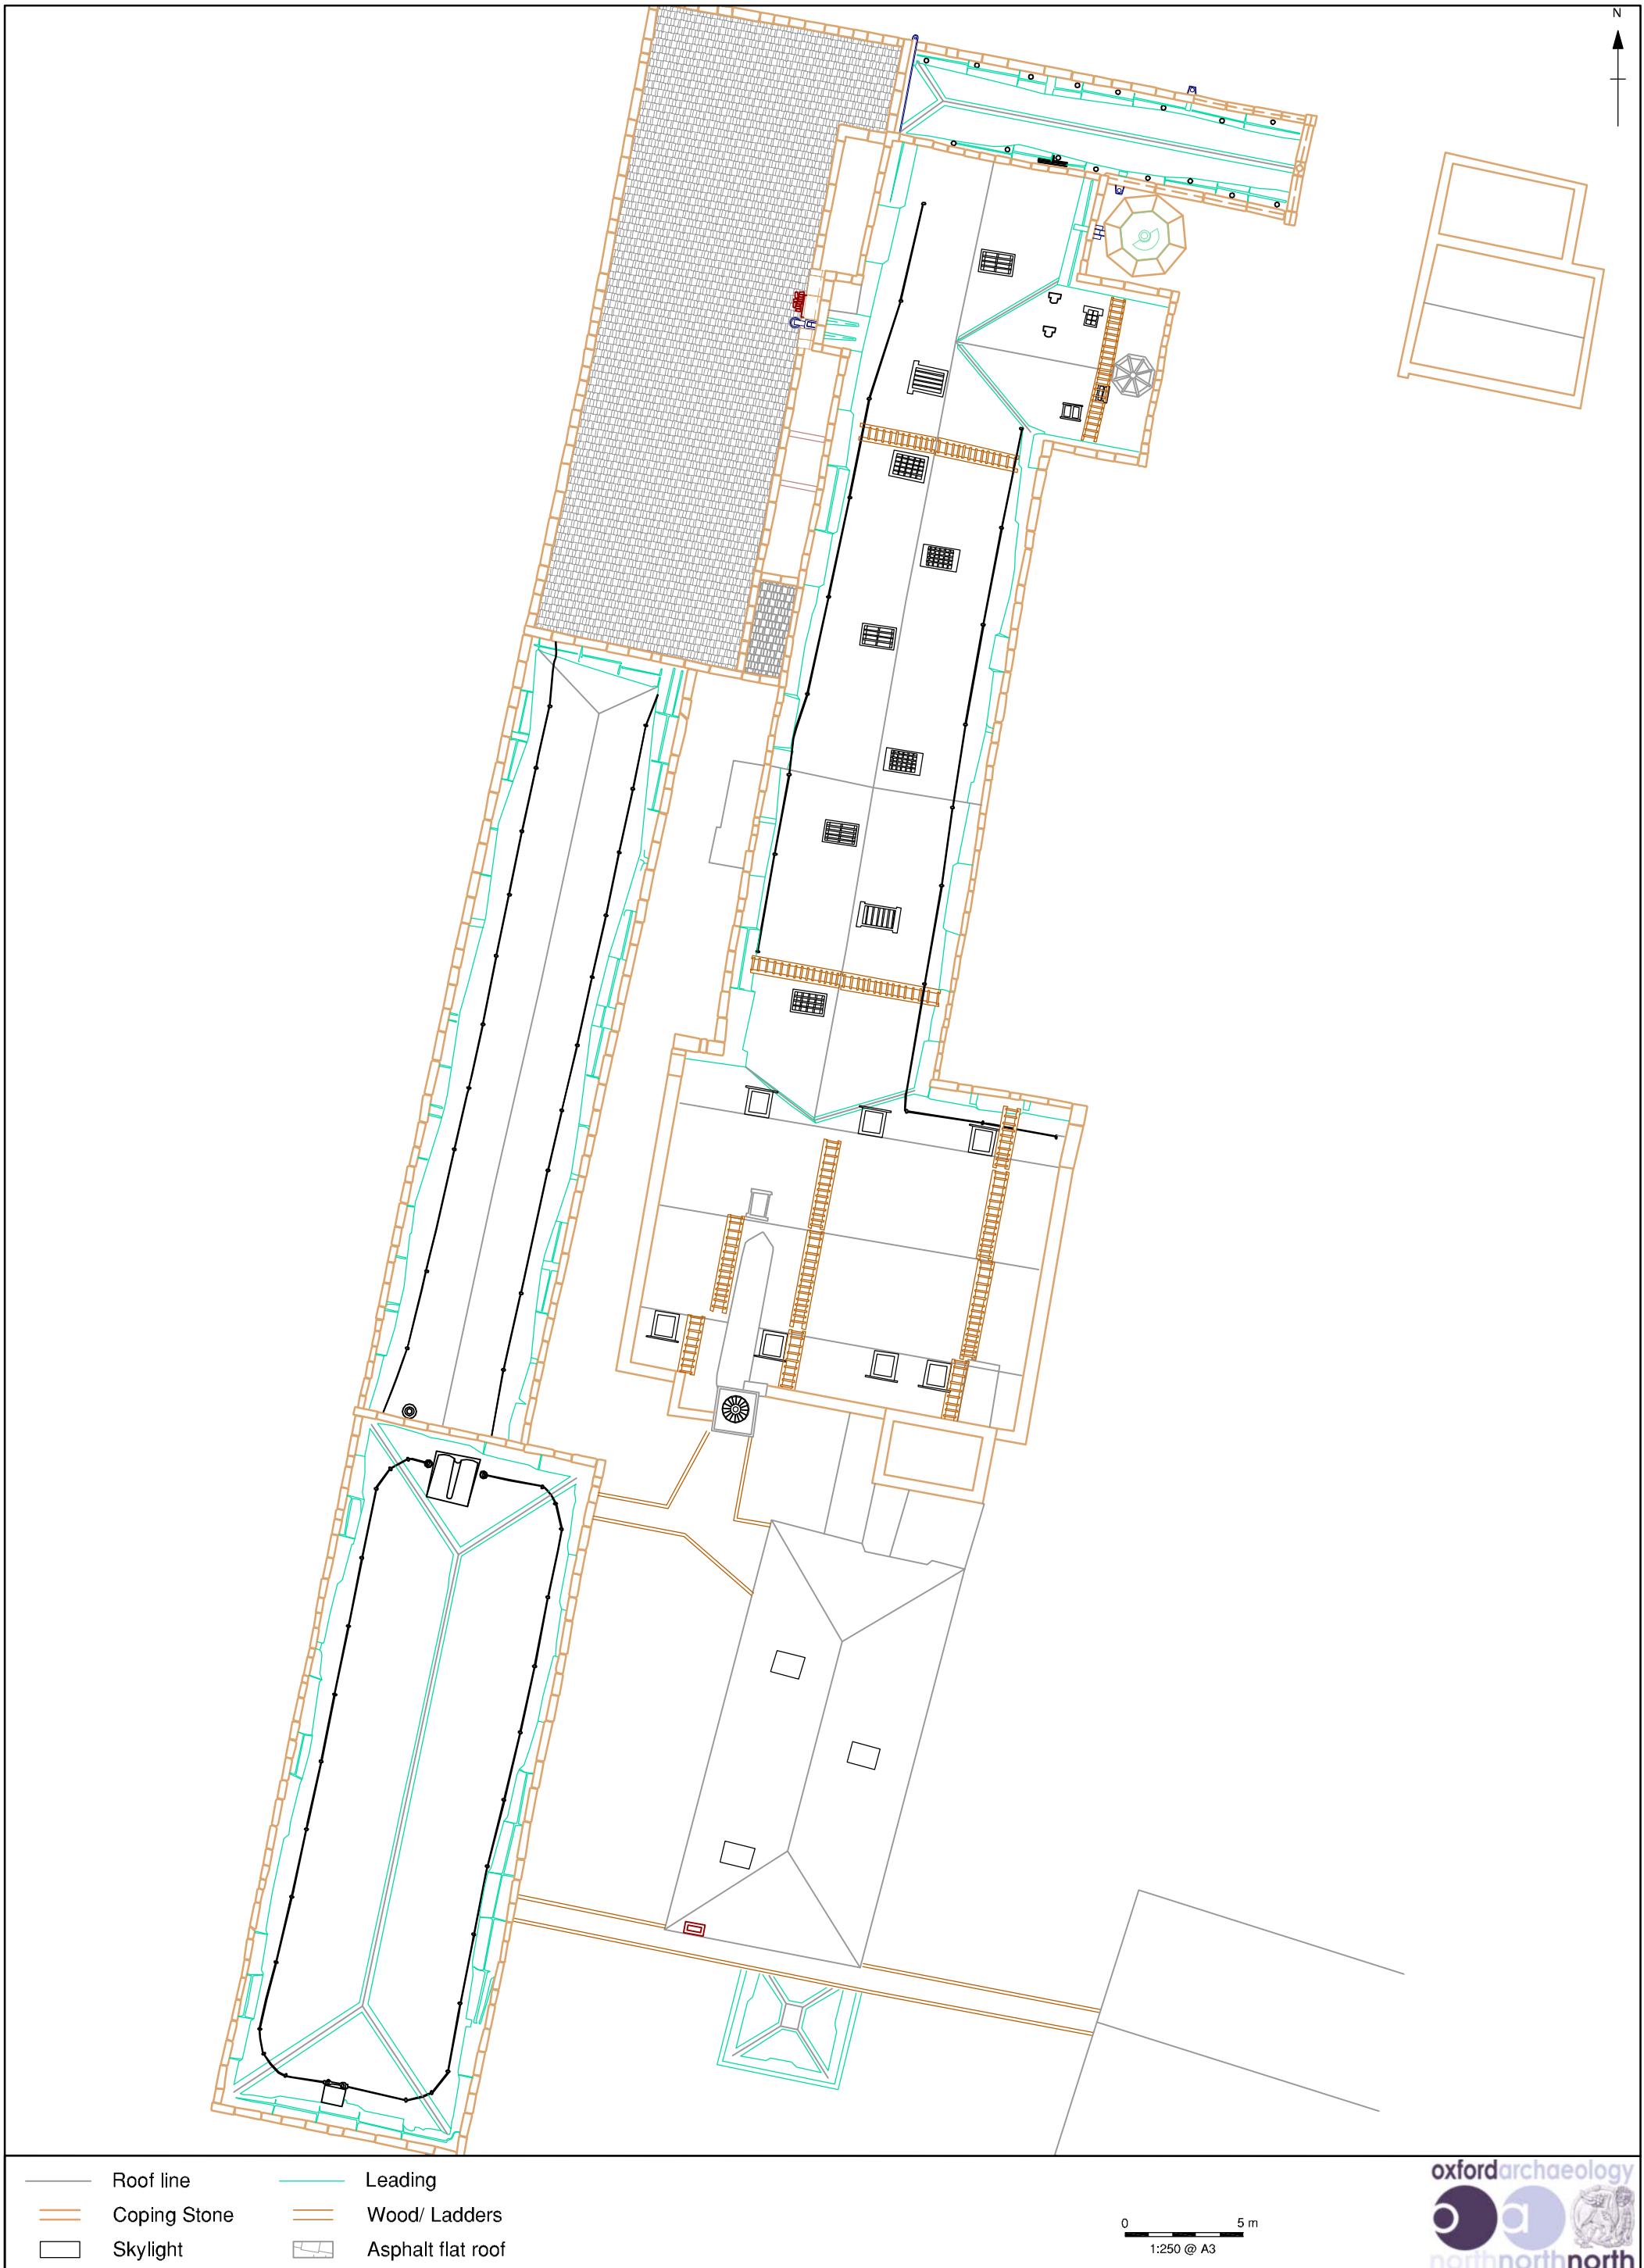


Figure 133: Roof plan of Quarry Bank Mill



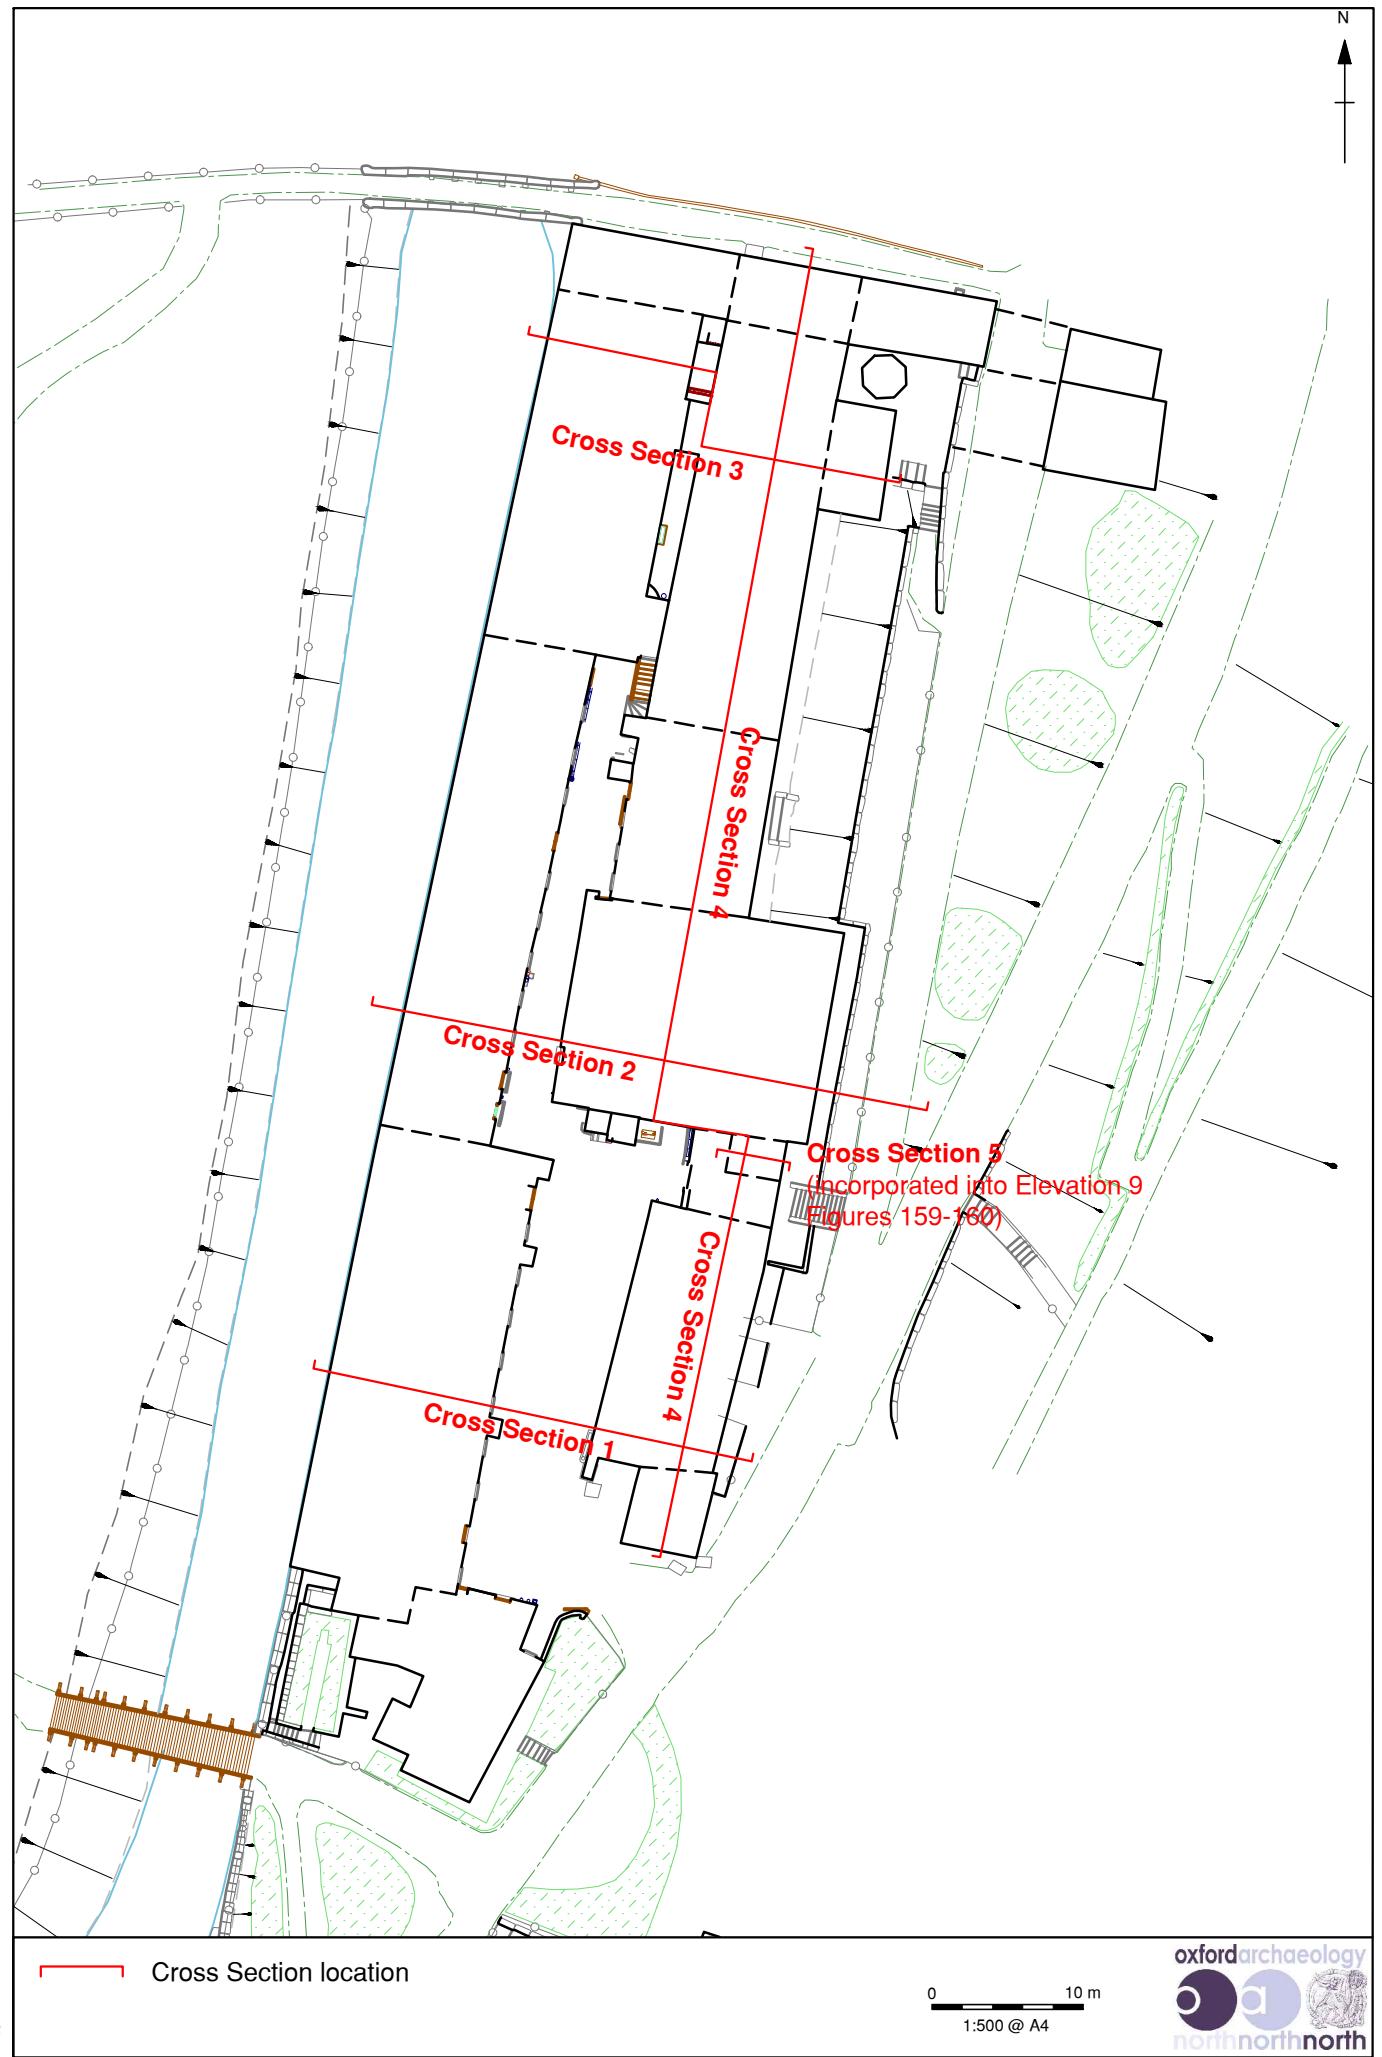


Figure 165: Location of Cross Sections

North South



water line


JQ*L10603*AKH*231013

- | | | | | | |
|---|-------------|-----|------------|-----|----------|
| — | Ground line | — | Wood | ☒☒☒ | Obscured |
| — | Brick | ◎ X | Wall brace | | |
| — | Stone | — | Roof line | | |

0 5 m
1:250 @ A3

Figure 135: Elevation 1 including Laser Scan data

North South

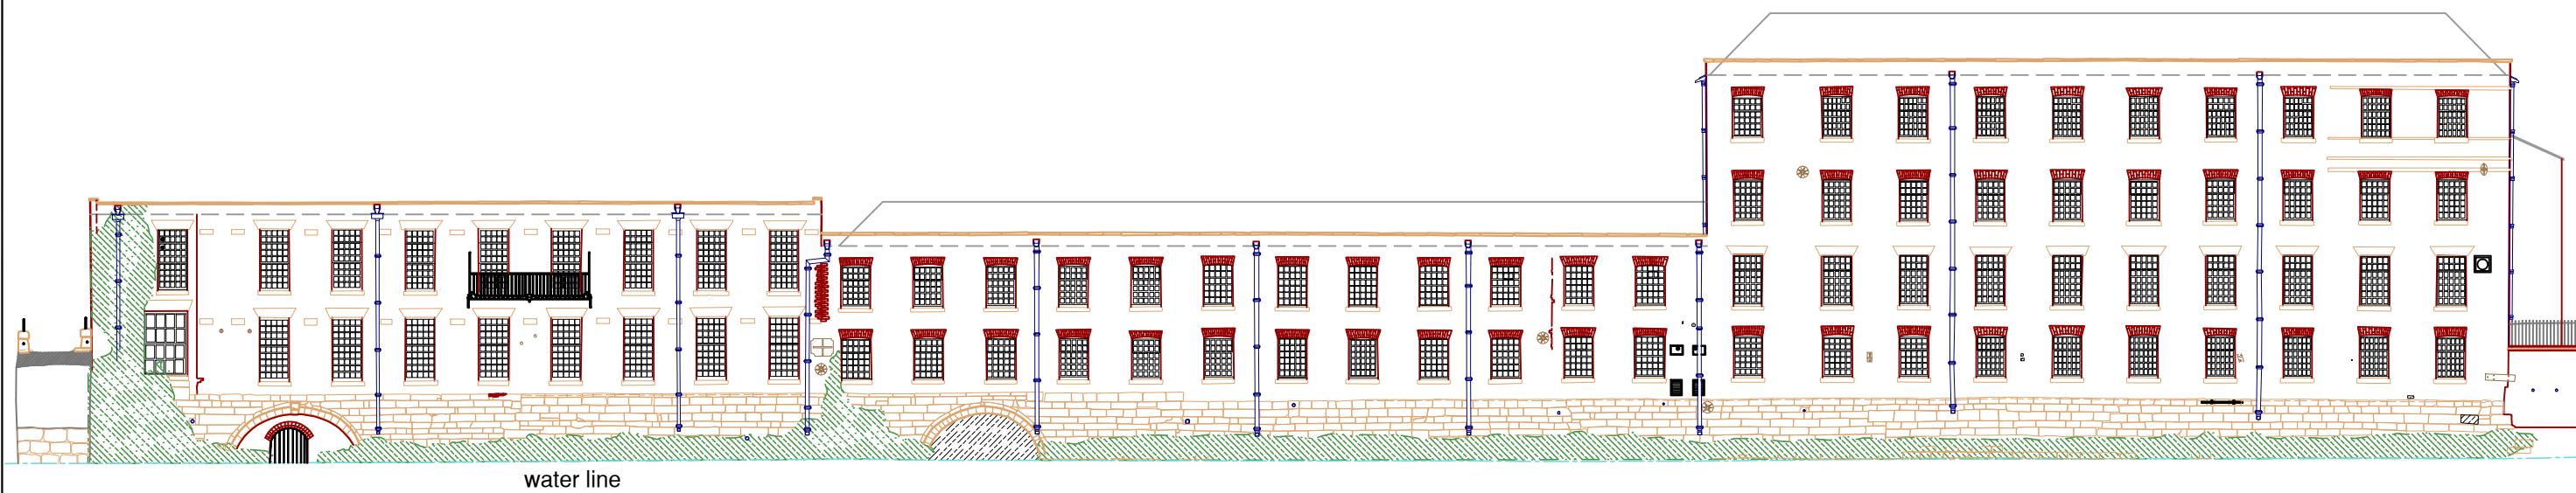



JQ*L10603*AKH*231013

Ground line	Wood	Obscured
Brick	○ X	Wall brace
Stone	—	Roof line

0 5 m
1:250 @ A3


Figure 136: Elevation 1 - The West Range

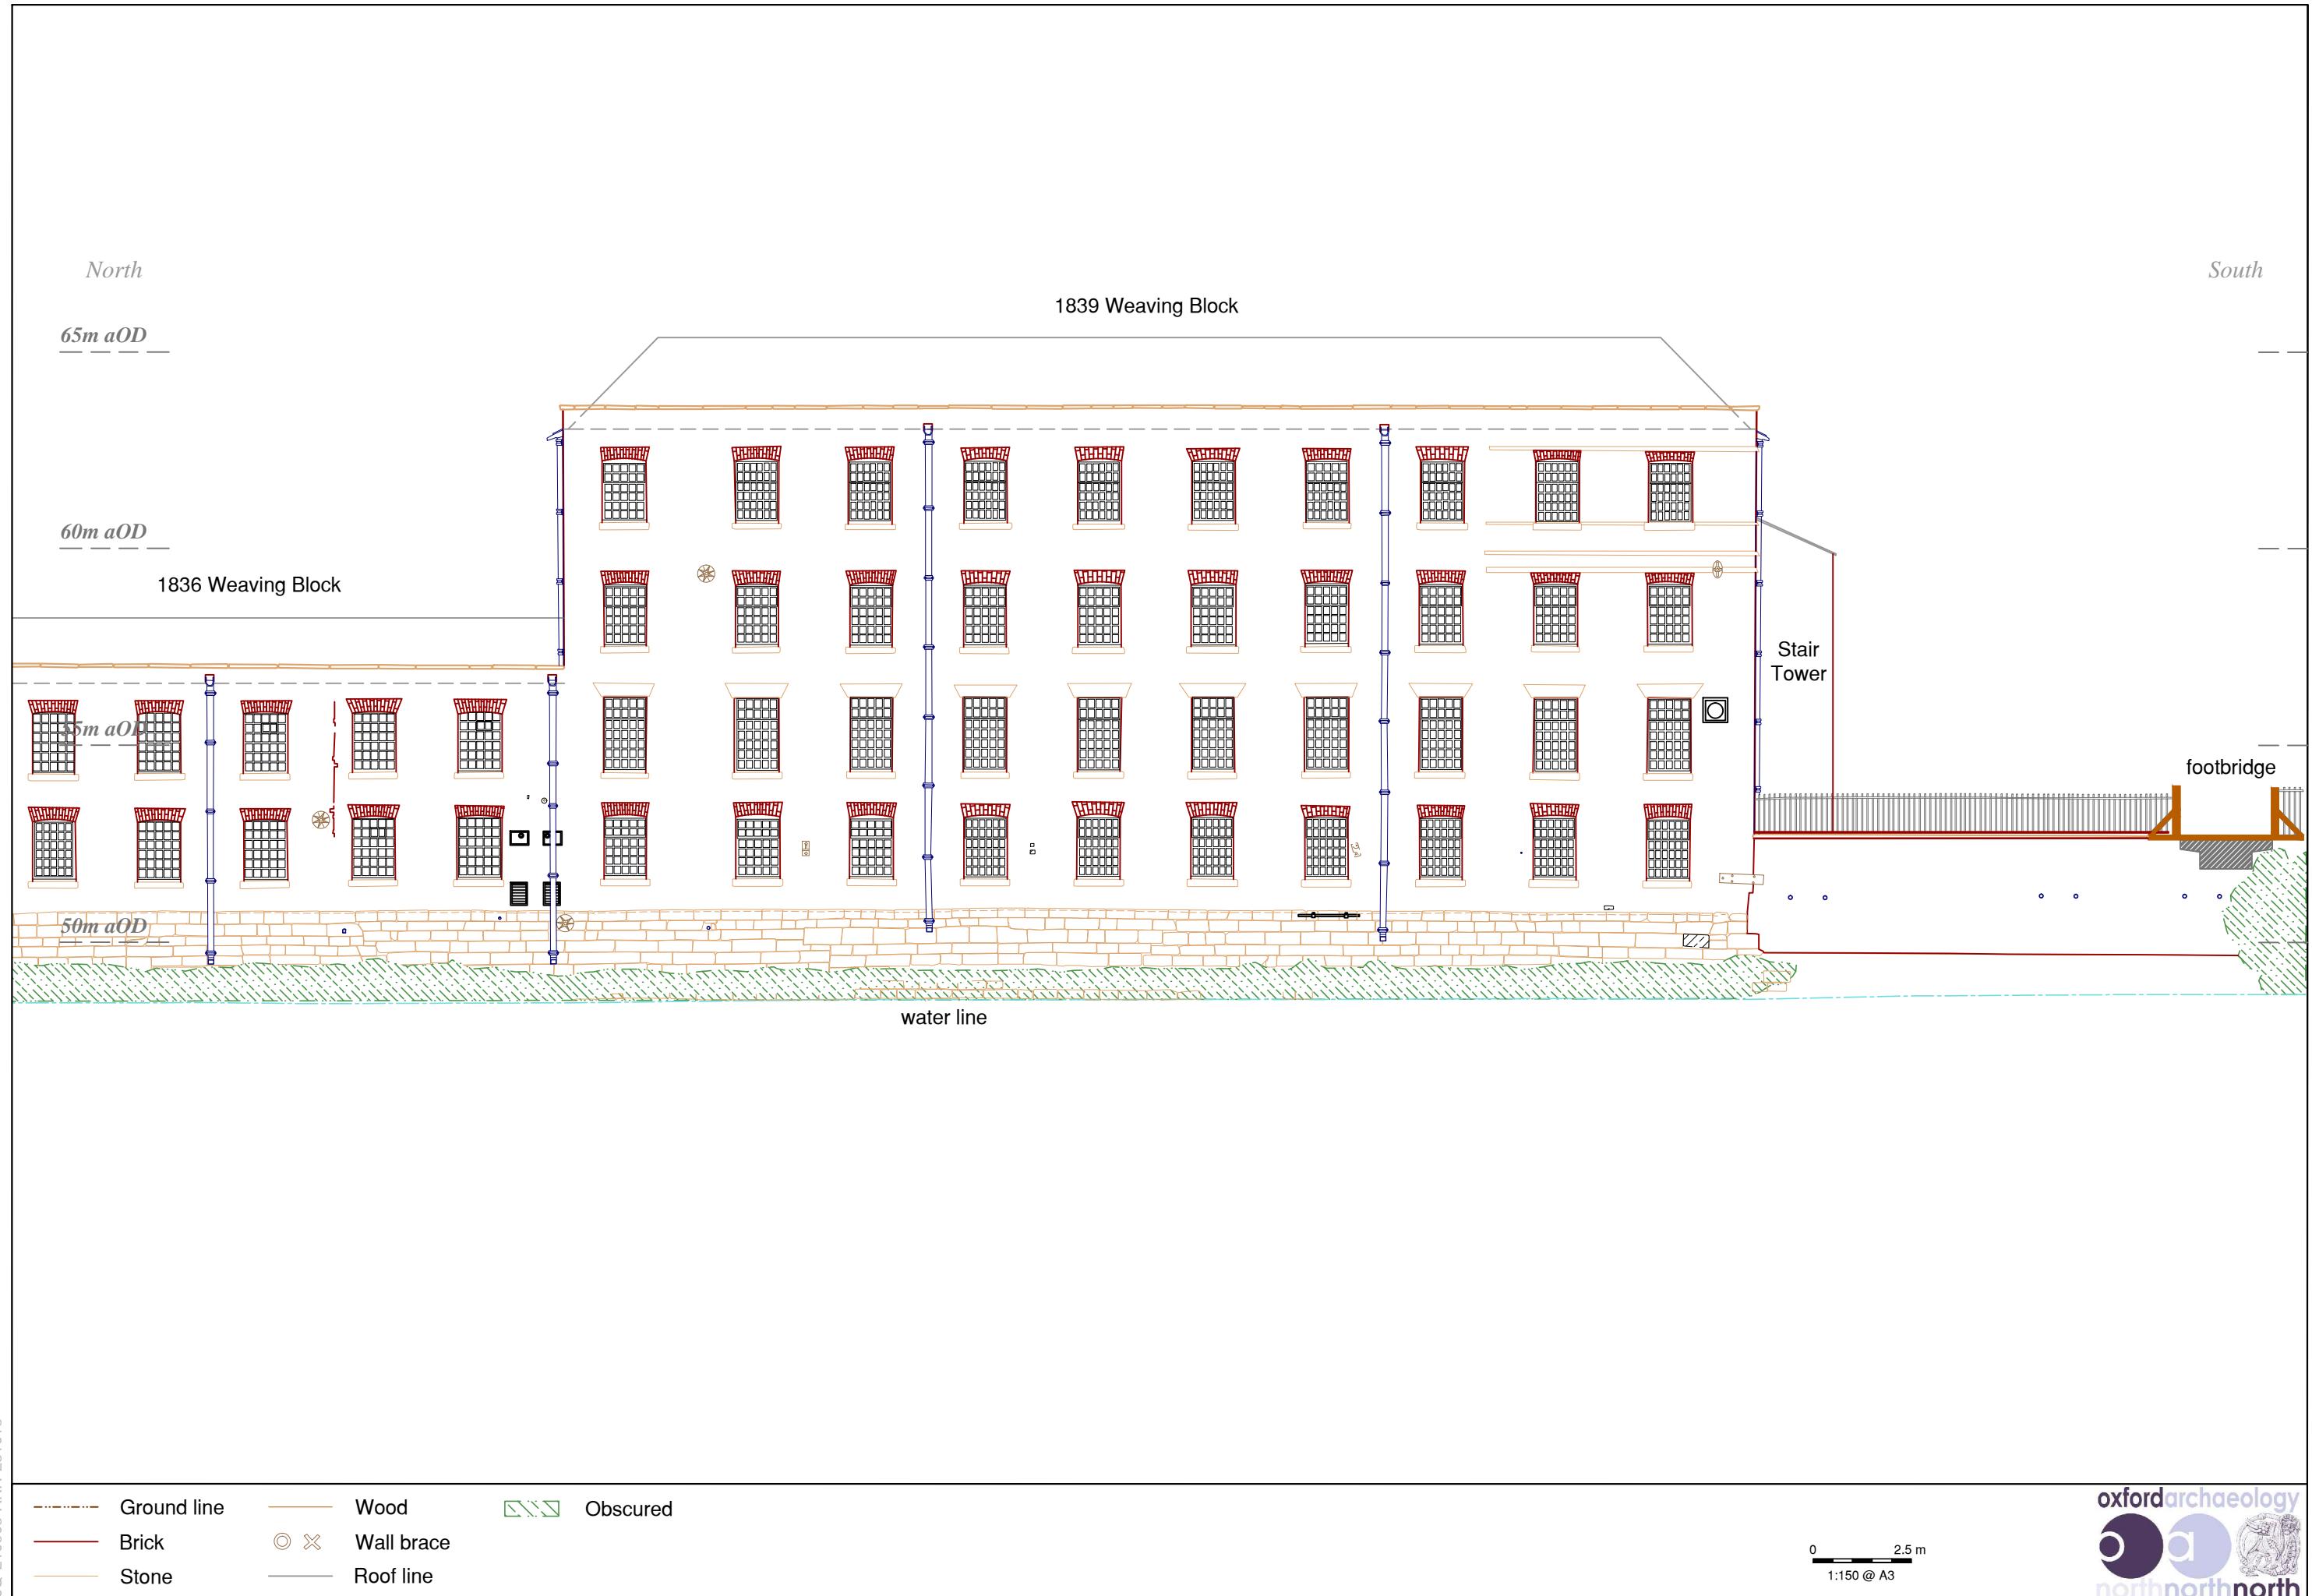

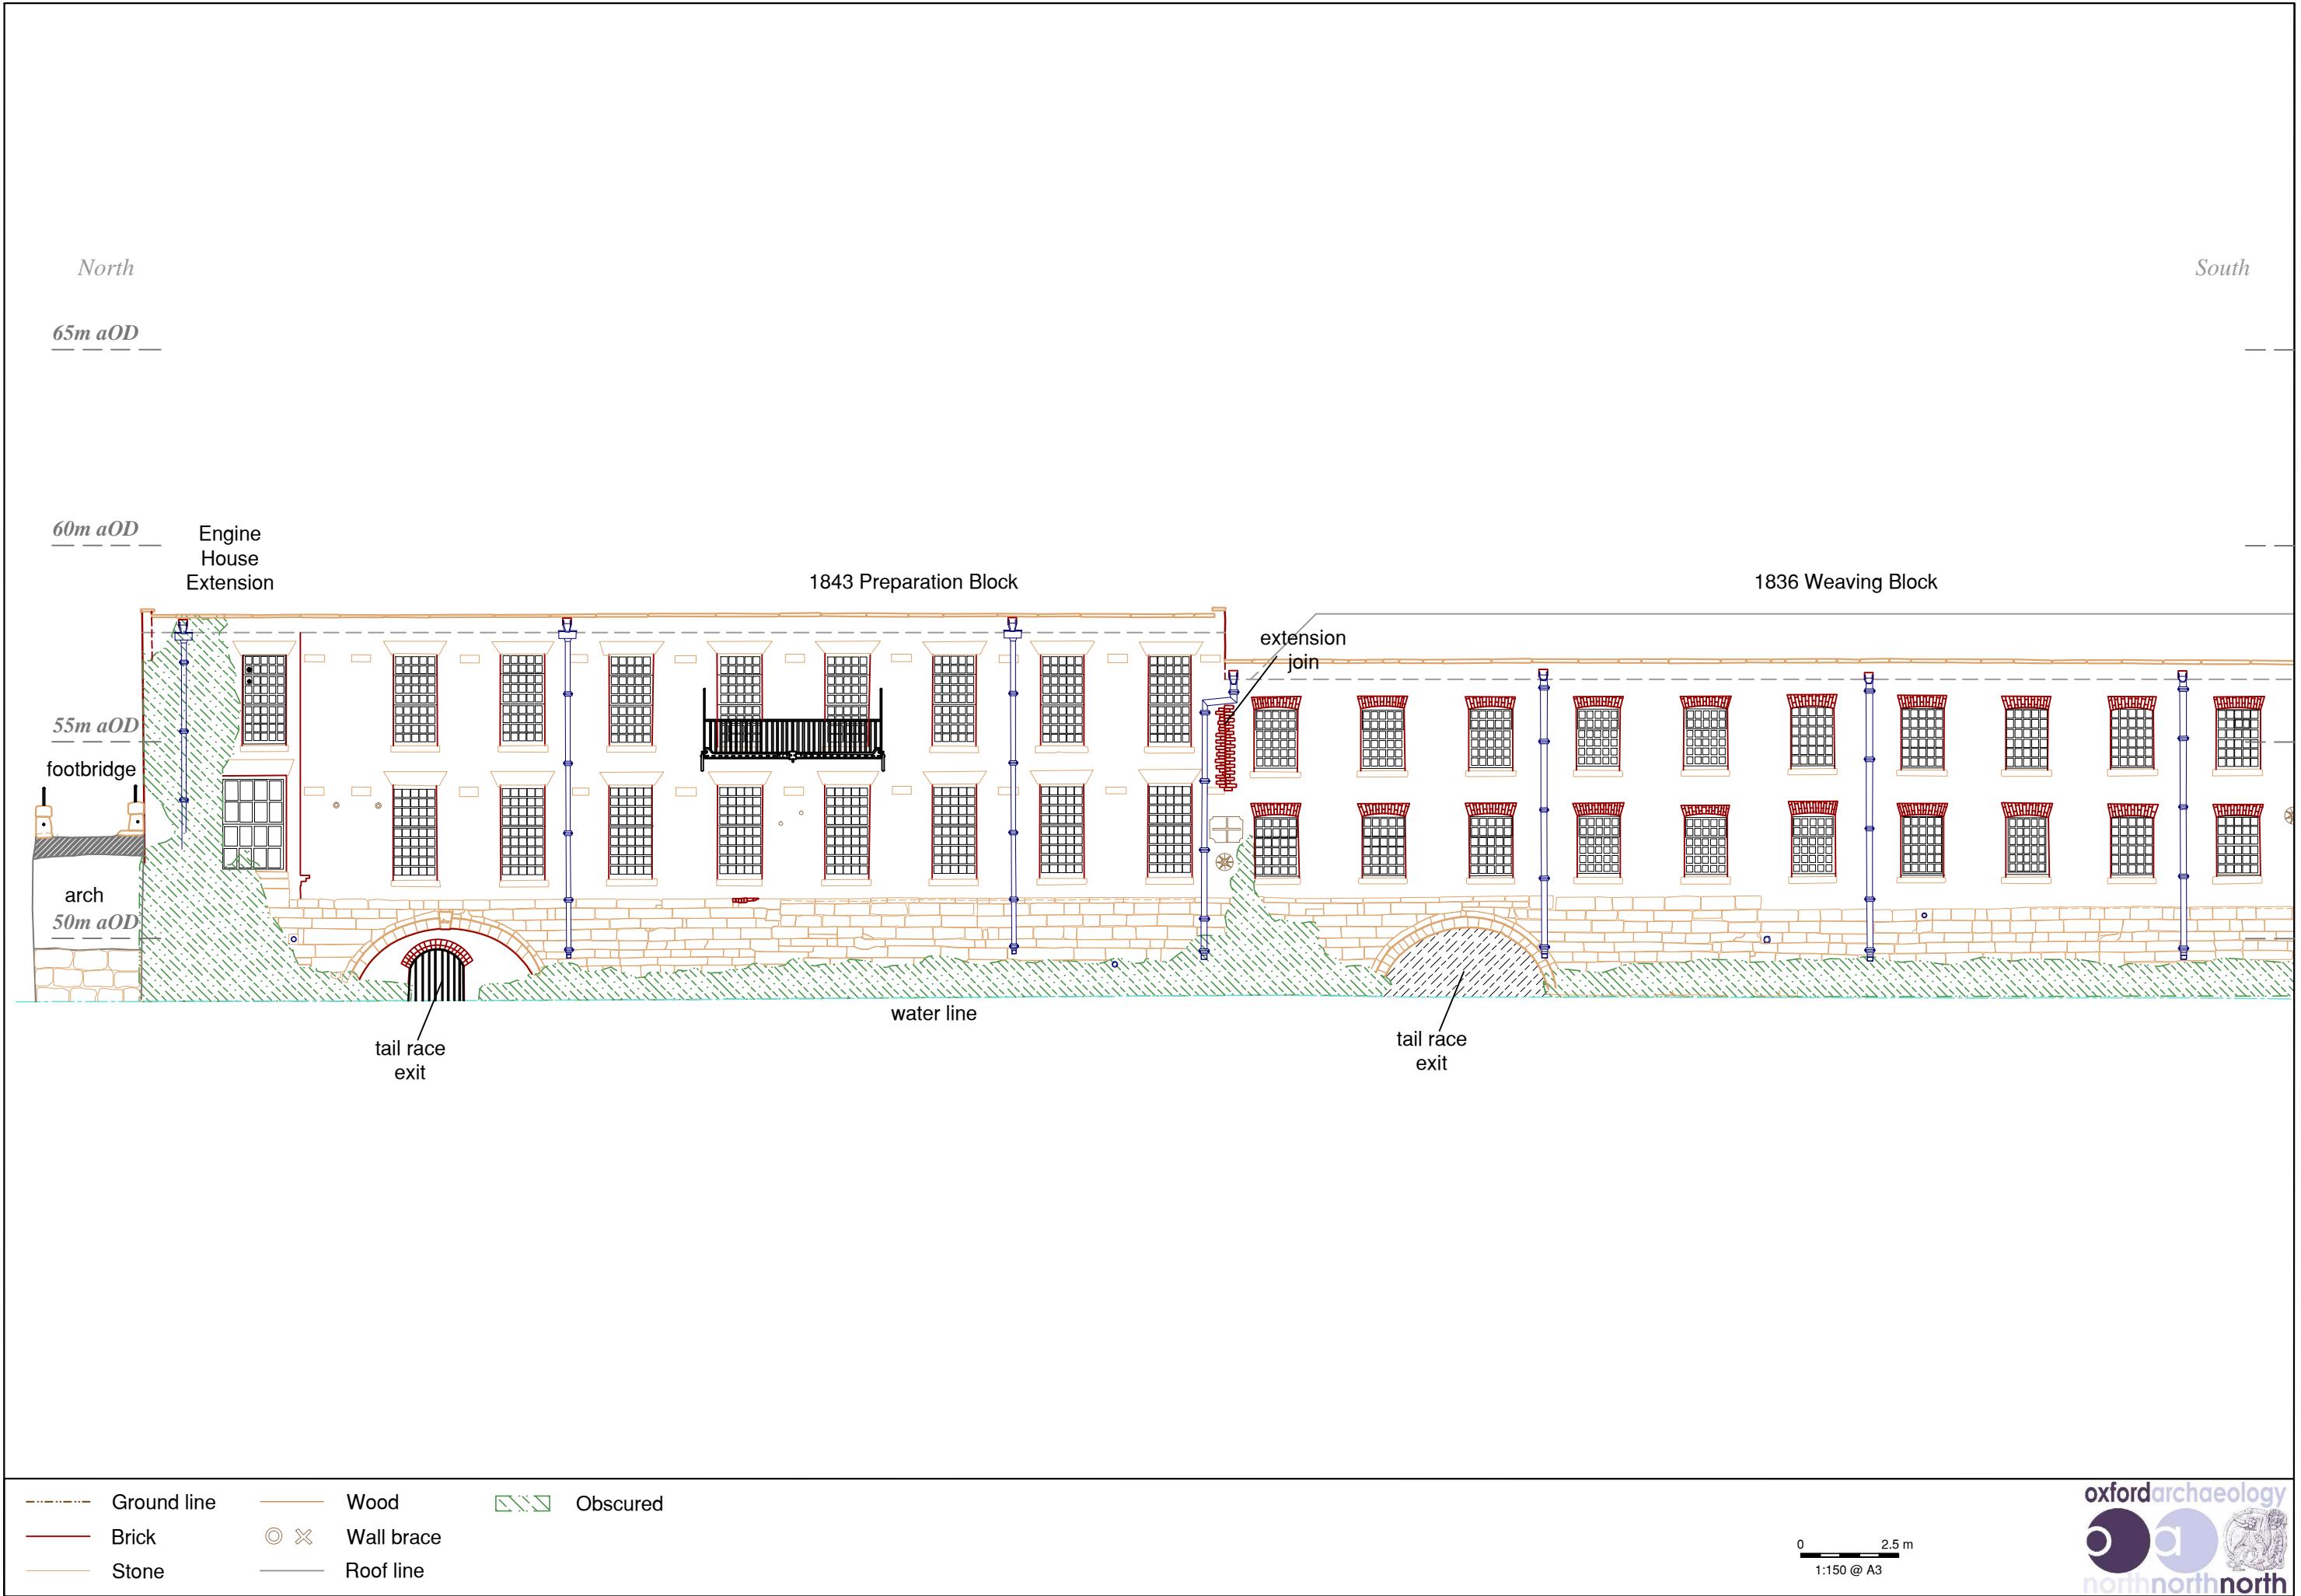

East

West

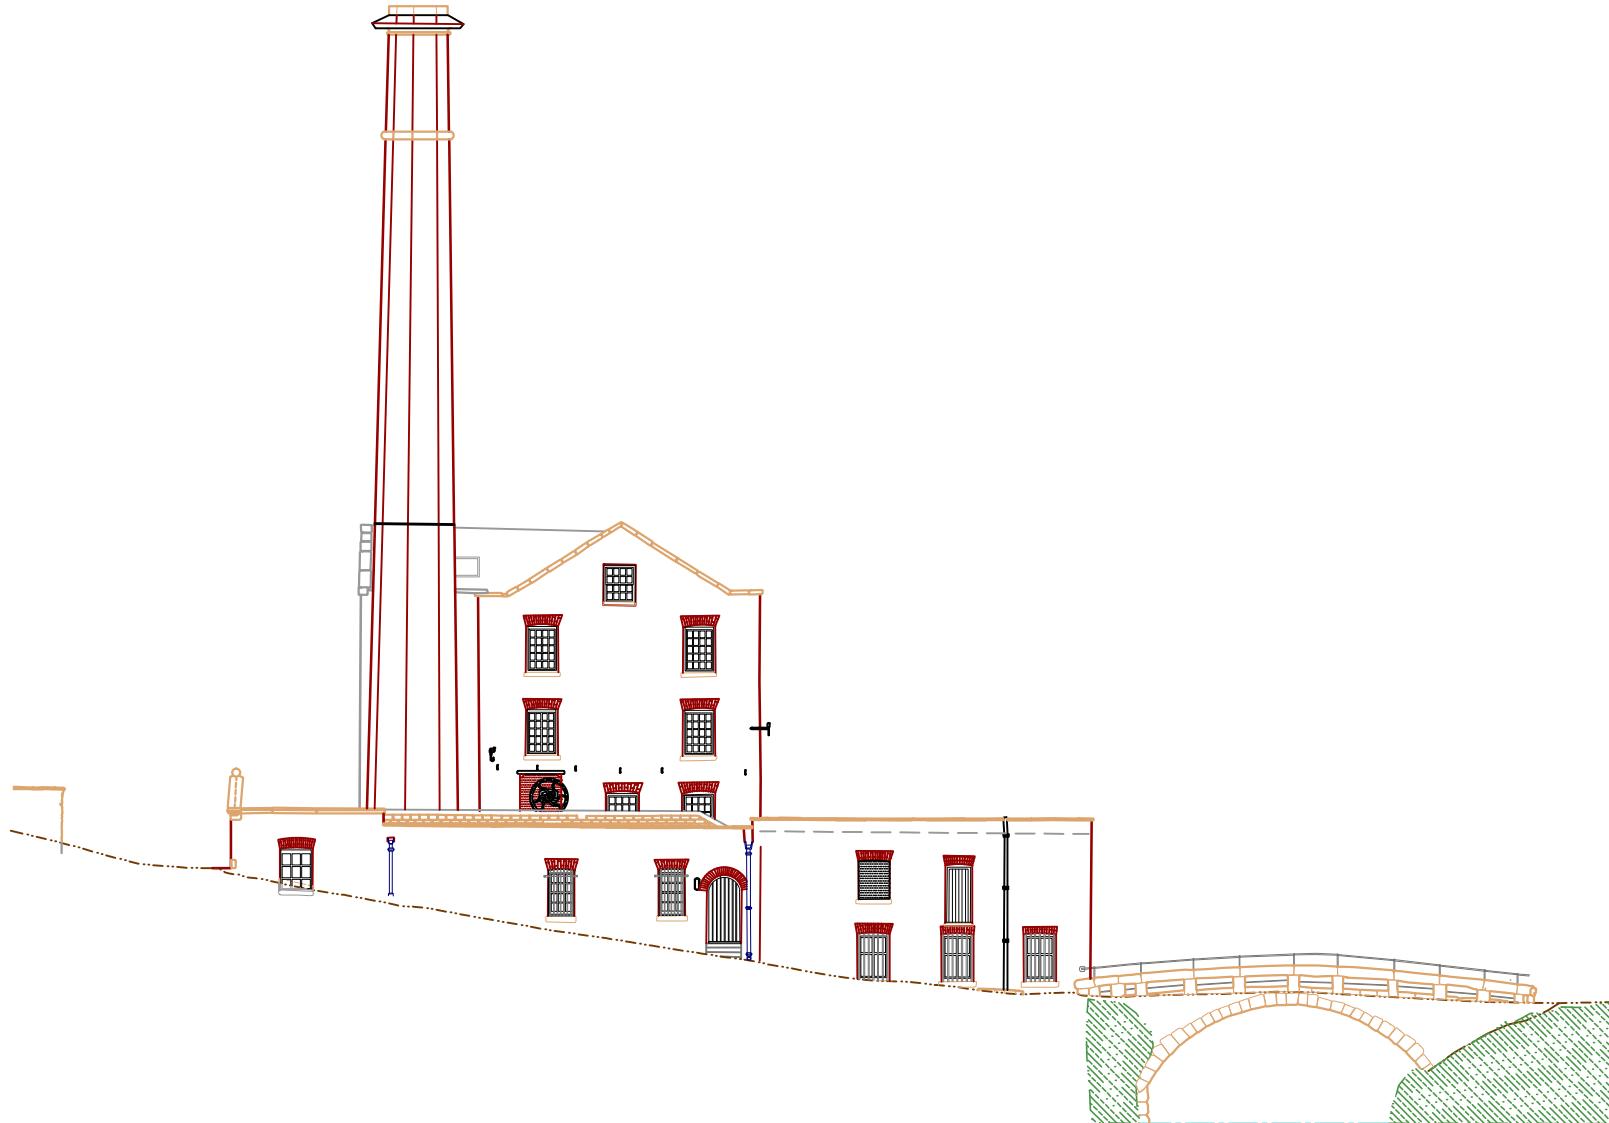

Ground line	Stone	Wall brace	Obscured
Brick	Wood	Roof line	

0 5 m
1:250 @ A4

Figure 139: Elevation 2 - The Engine House and Old Mill Gable



Figure 140: Elevation 2 - The Engine House and Old Mill Gable including Laser Scan data

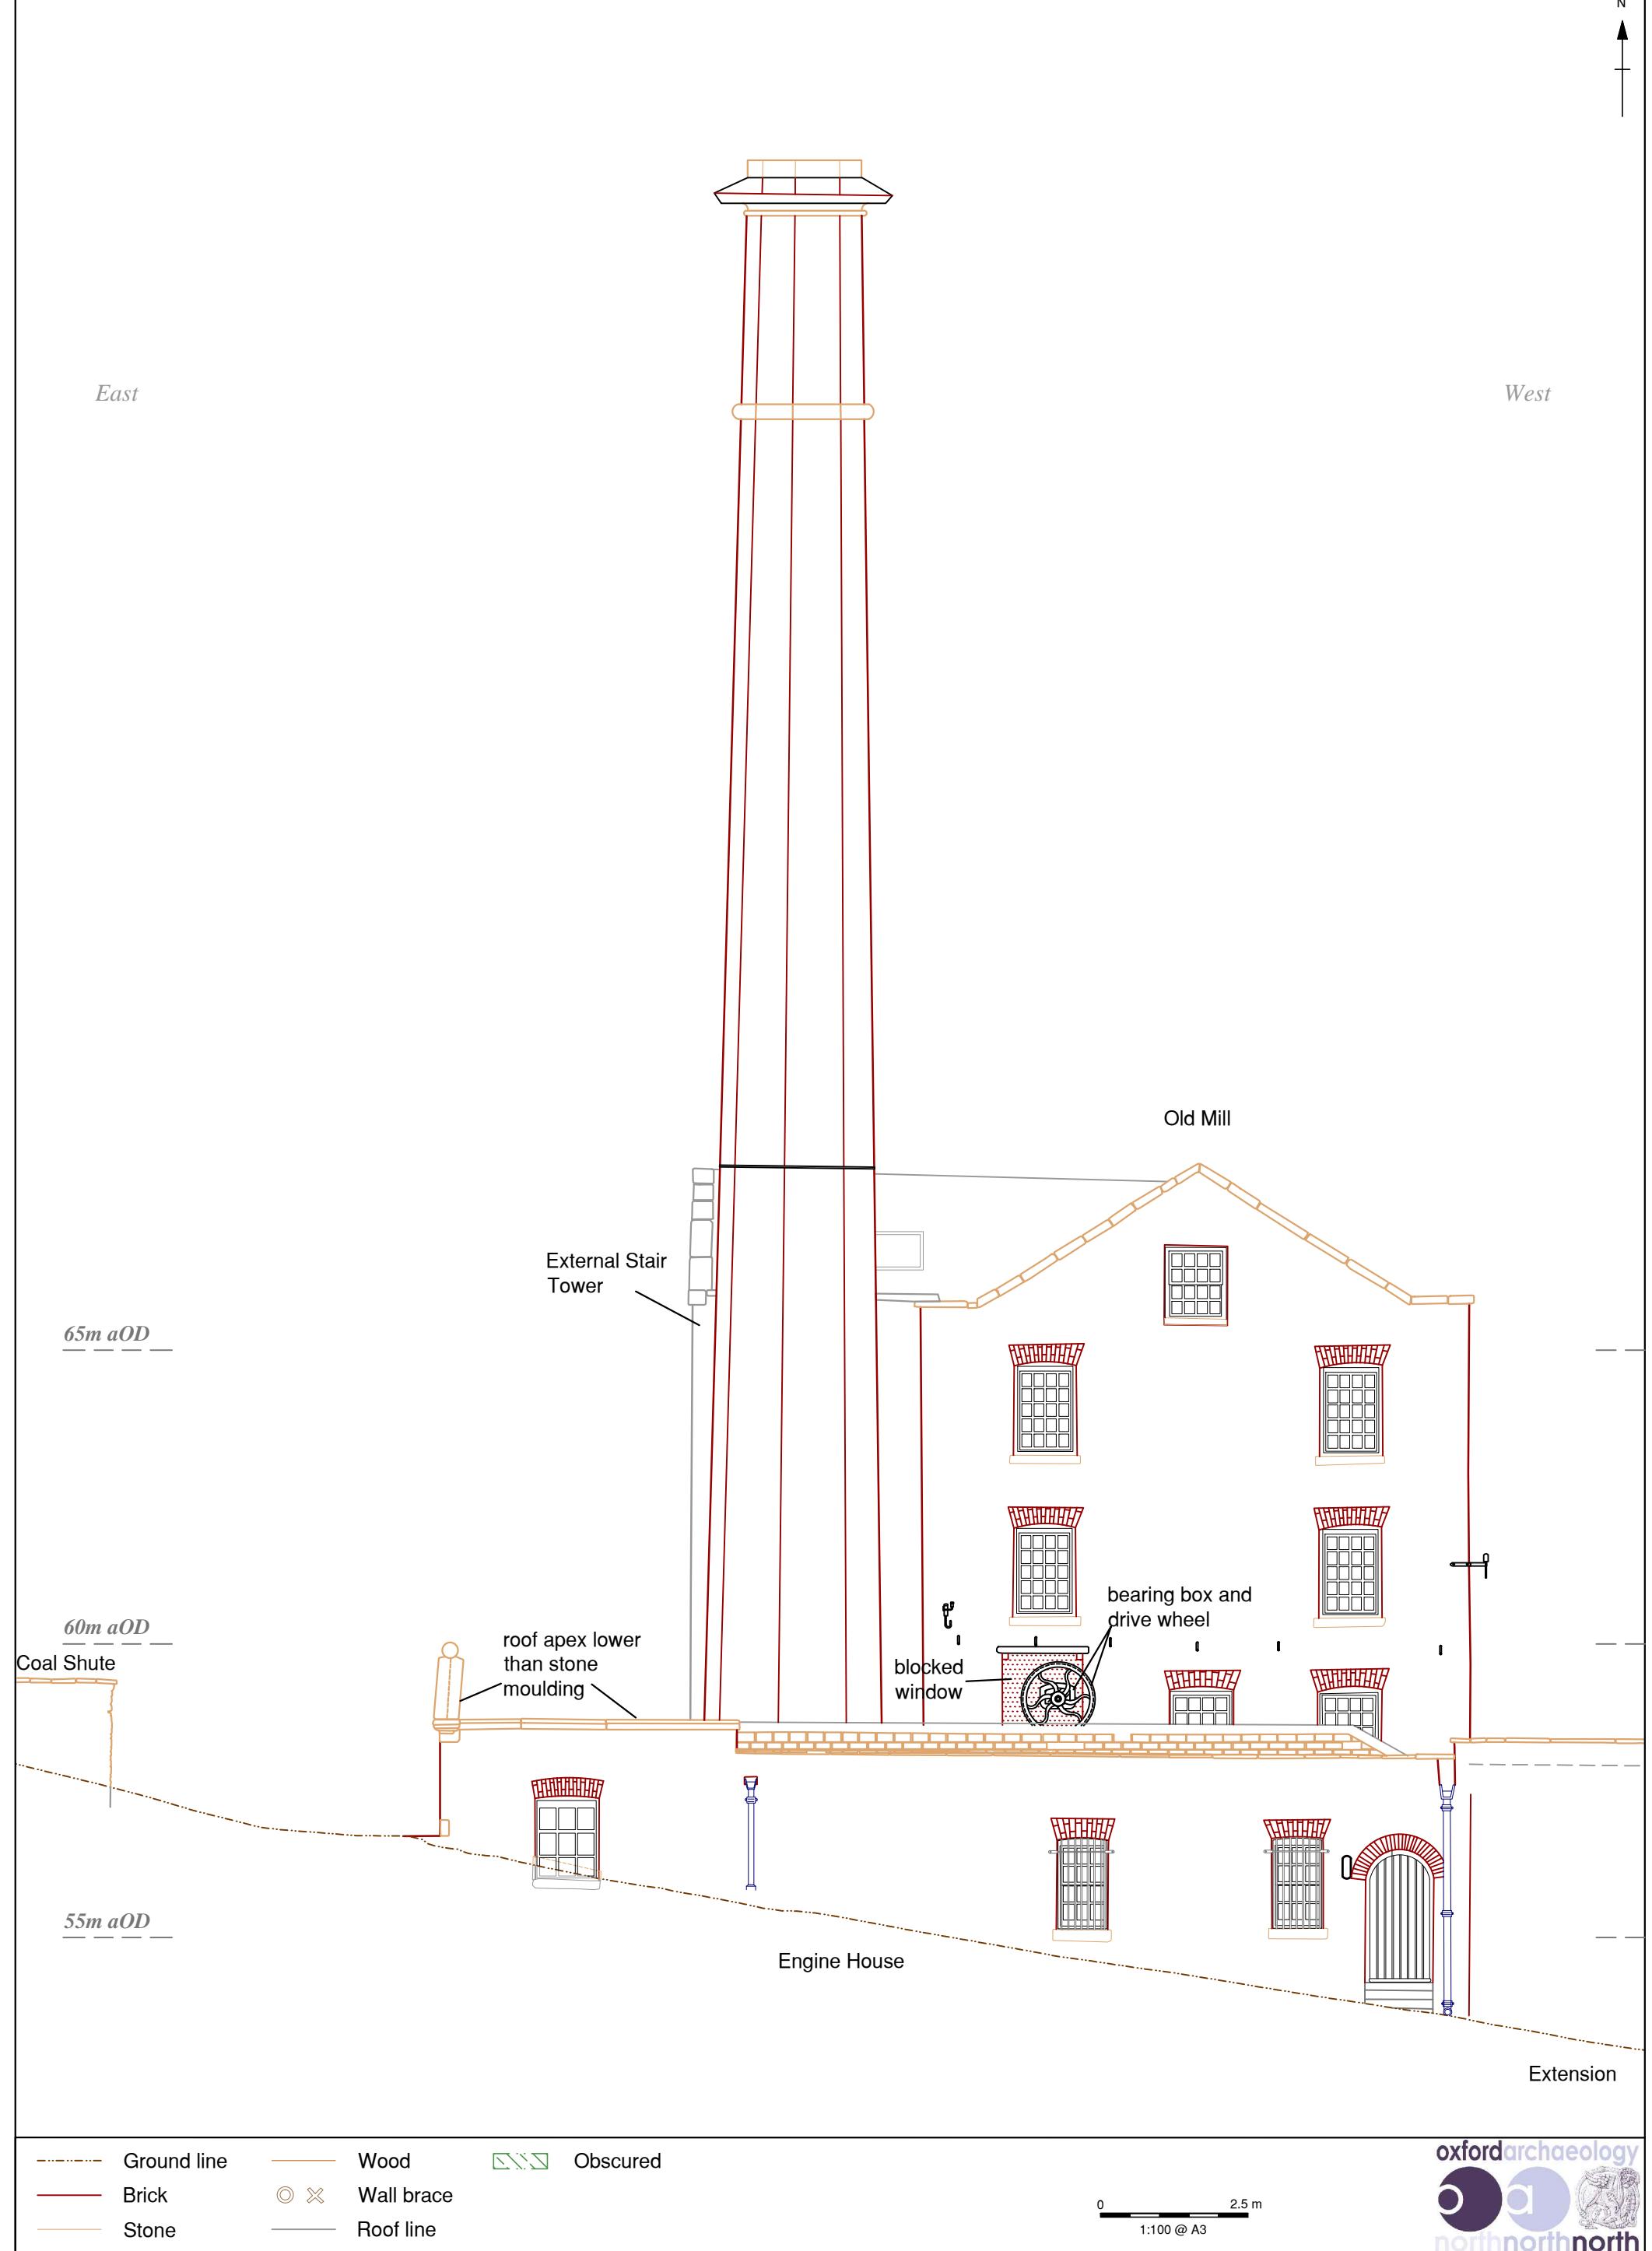


Figure 141: Elevation 2 - The Engine House (West)

East

West

Old Mill

65m aOD

60m aOD

Extension

blocked window

door

55m aOD


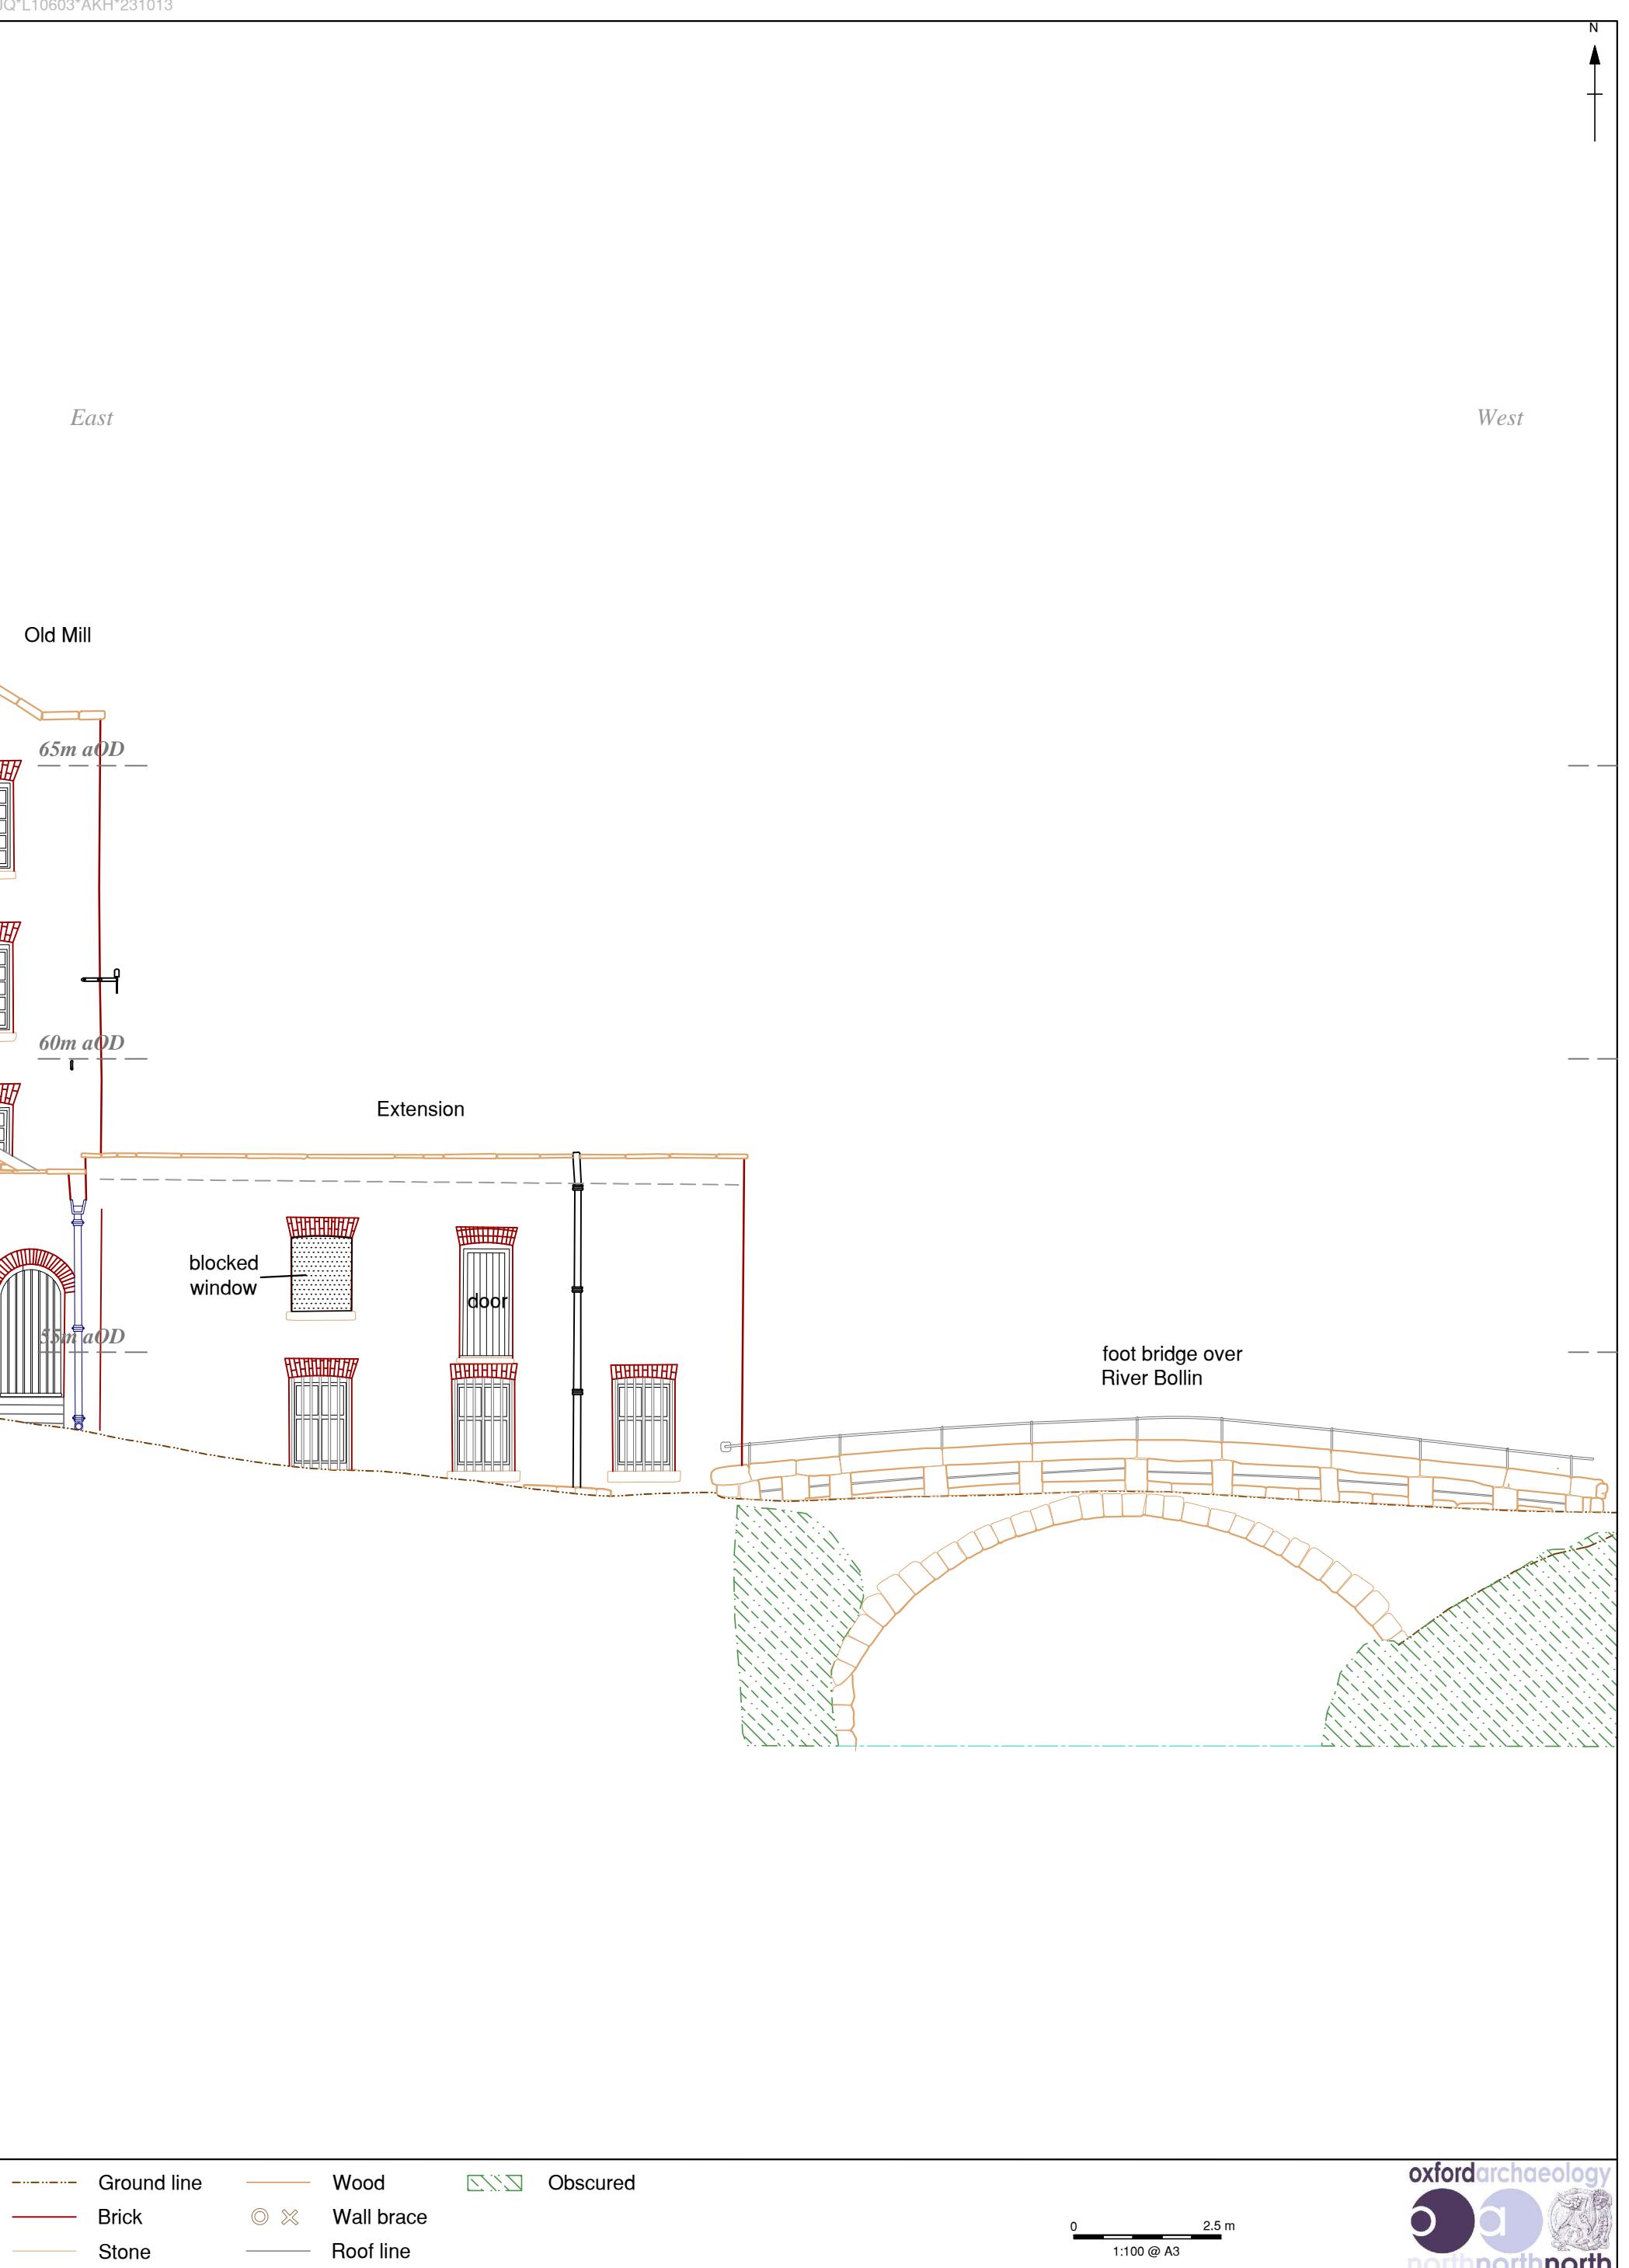
foot bridge over
River Bollin

Figure 142: Elevation 2 - The Engine House (East)

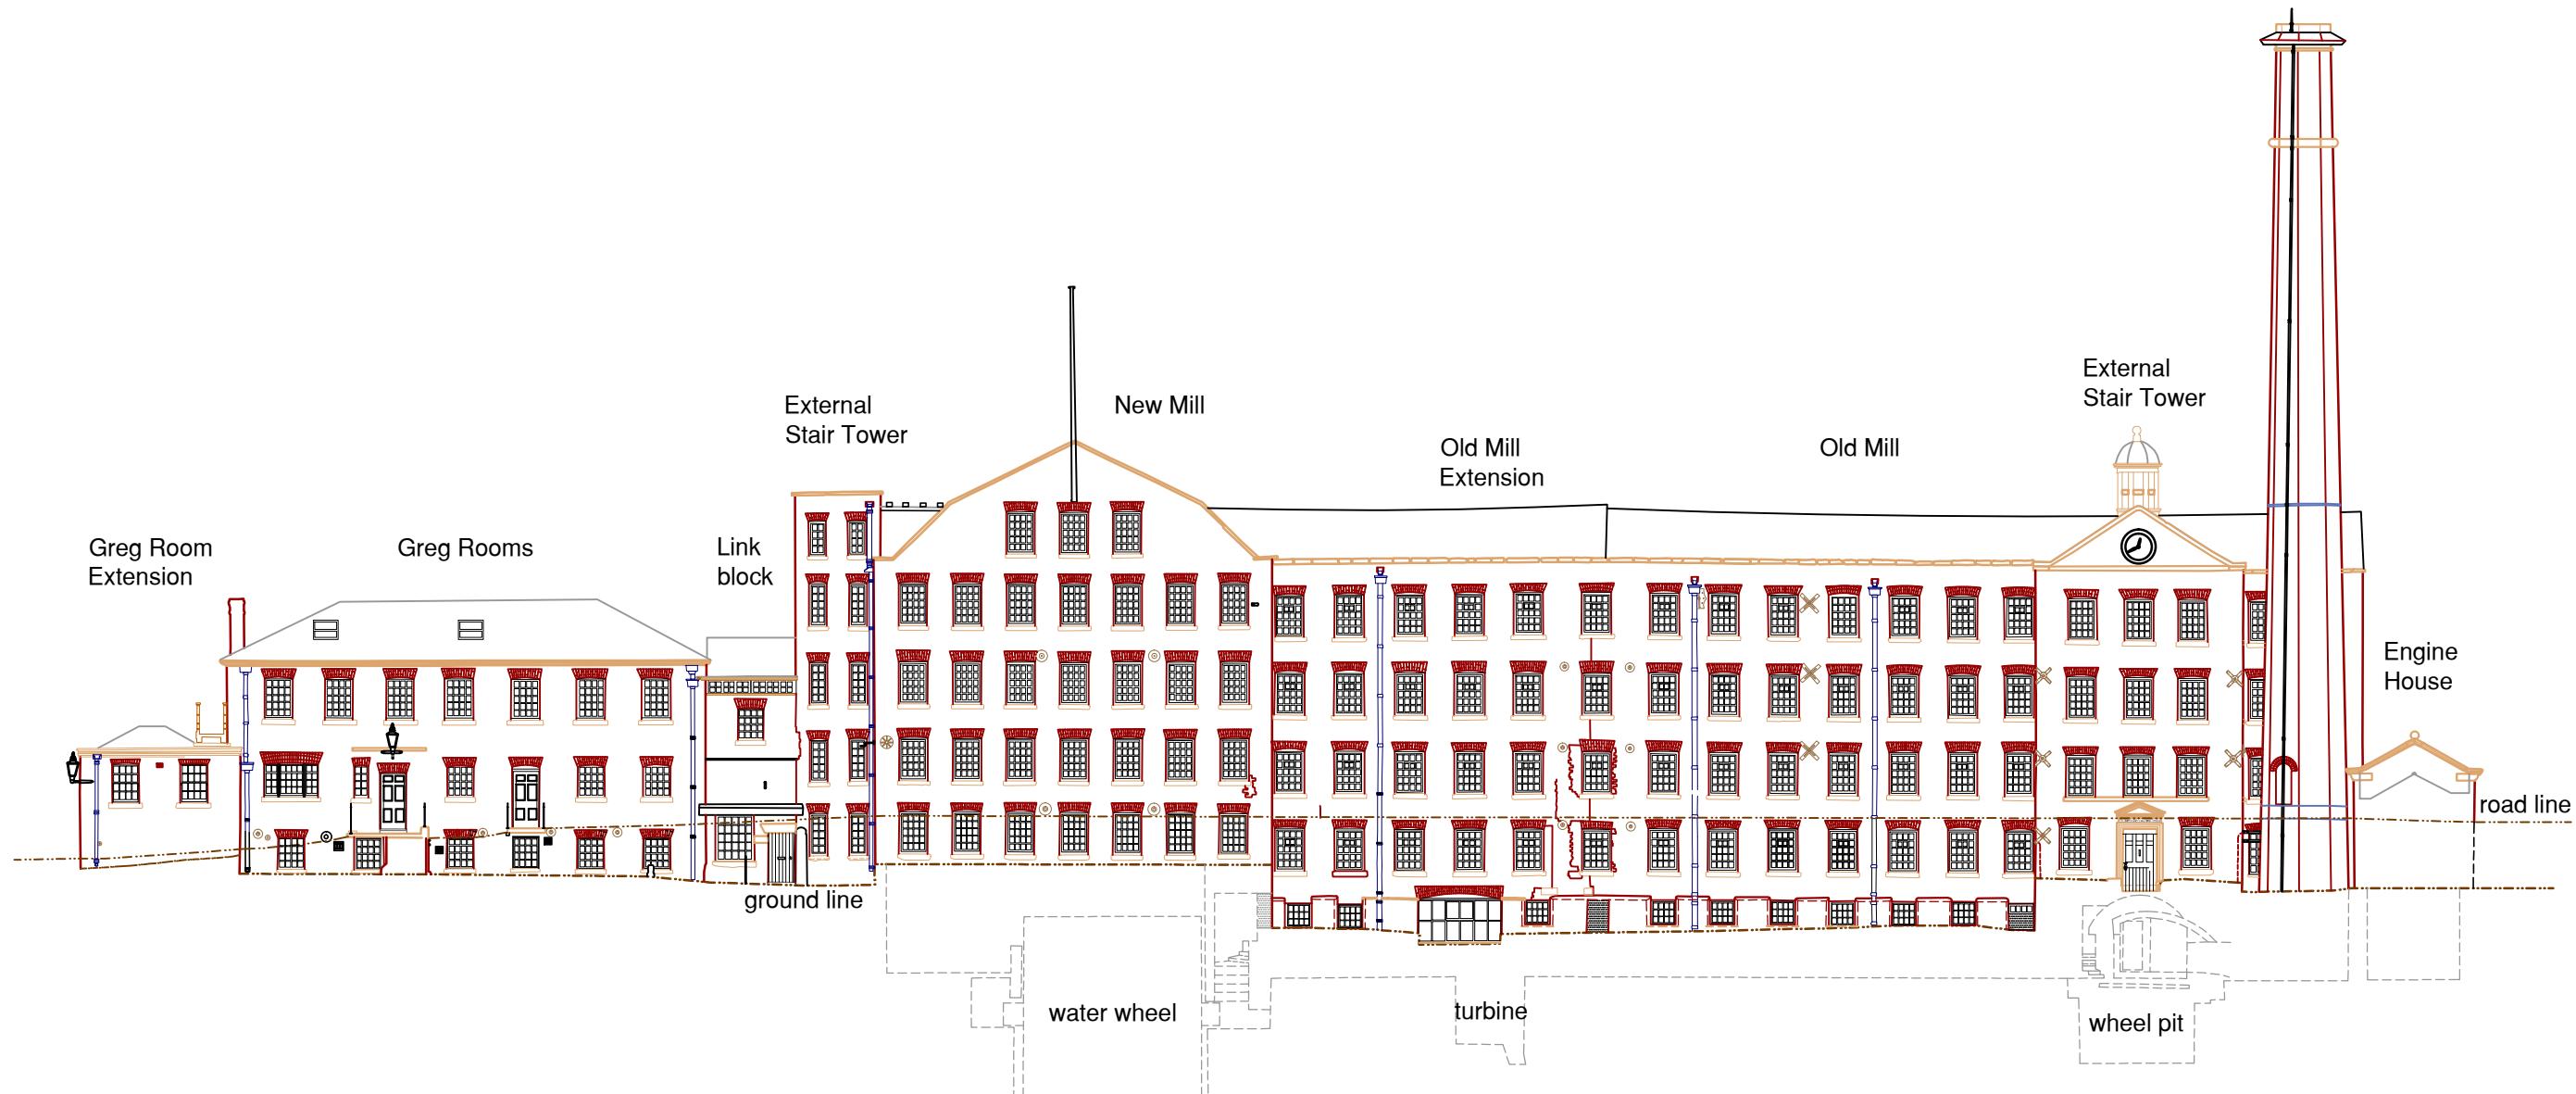

JQ*L10603*AKH*231013


A legend for architectural symbols. It includes: Ground line (dashed line), Wood (thin brown line), Below ground level (dash-dot line); Brick (red line), Wall brace (circle and cross symbol), Blocking (red dotted box); Stone (orange line), and Roof line (thick grey line).

0 5 m
1:250 @ A3


 oxfordarchaeology
 northnorthnorth

Figure 143: Elevation 3 - Greg Rooms, New Mill and Old Mill

South *North*

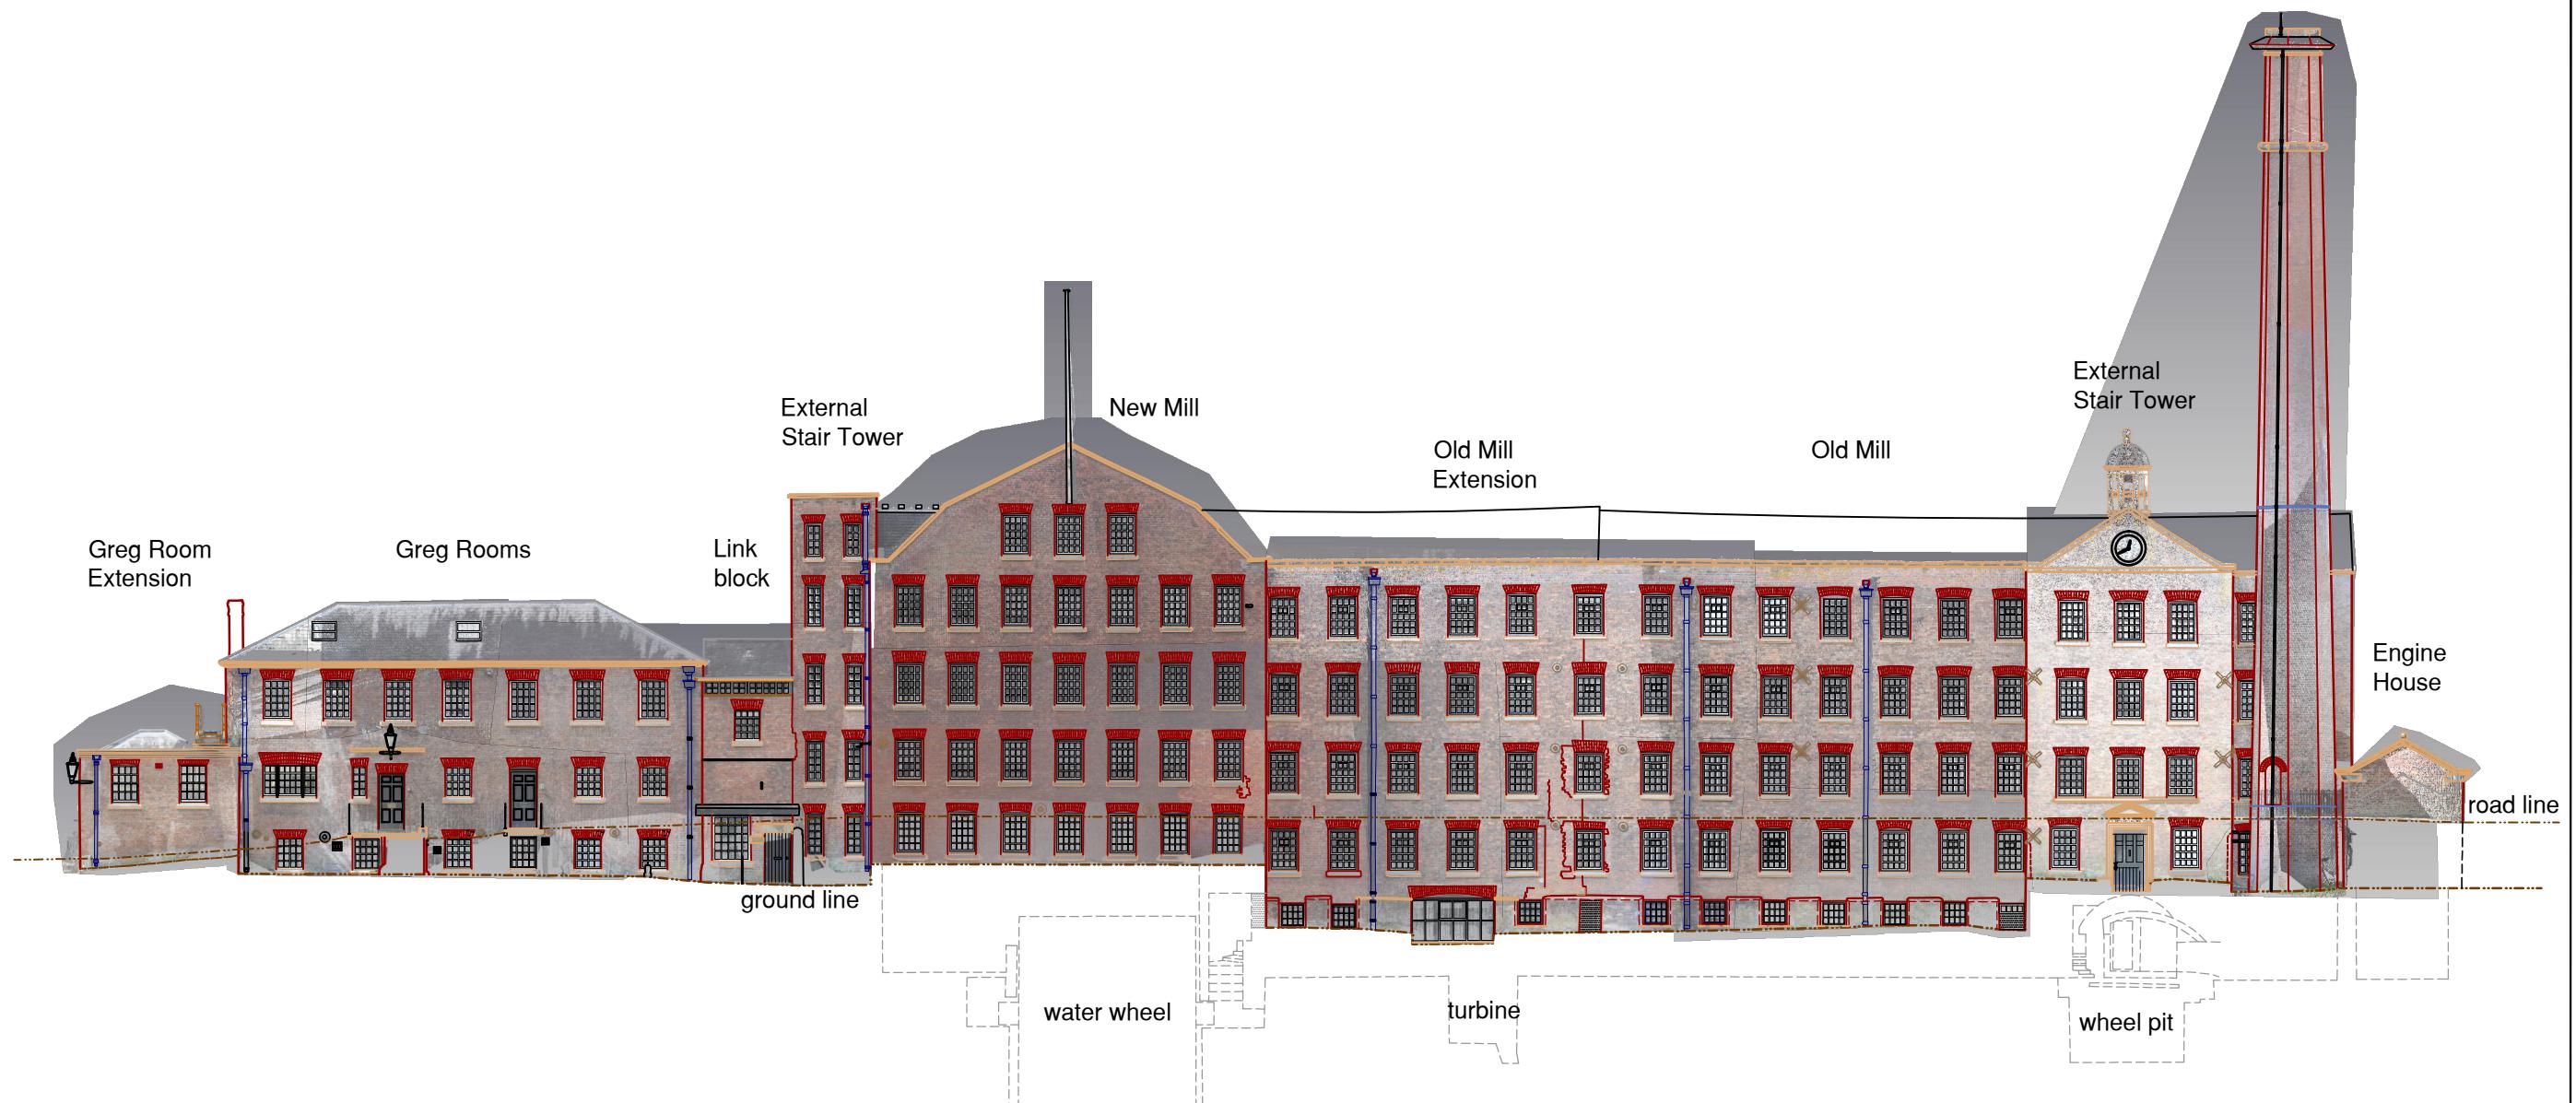

JQ*LL10603*AKH*231013

— Ground line — Wood - - - Below ground level
 — Brick ○ Wall brace ■ Blocking
 — Stone — Roof line

0 5 m
1:250 @ A3

Figure 144: Elevation 3 - Greg Rooms, New Mill and Old Mill showing laser scan data

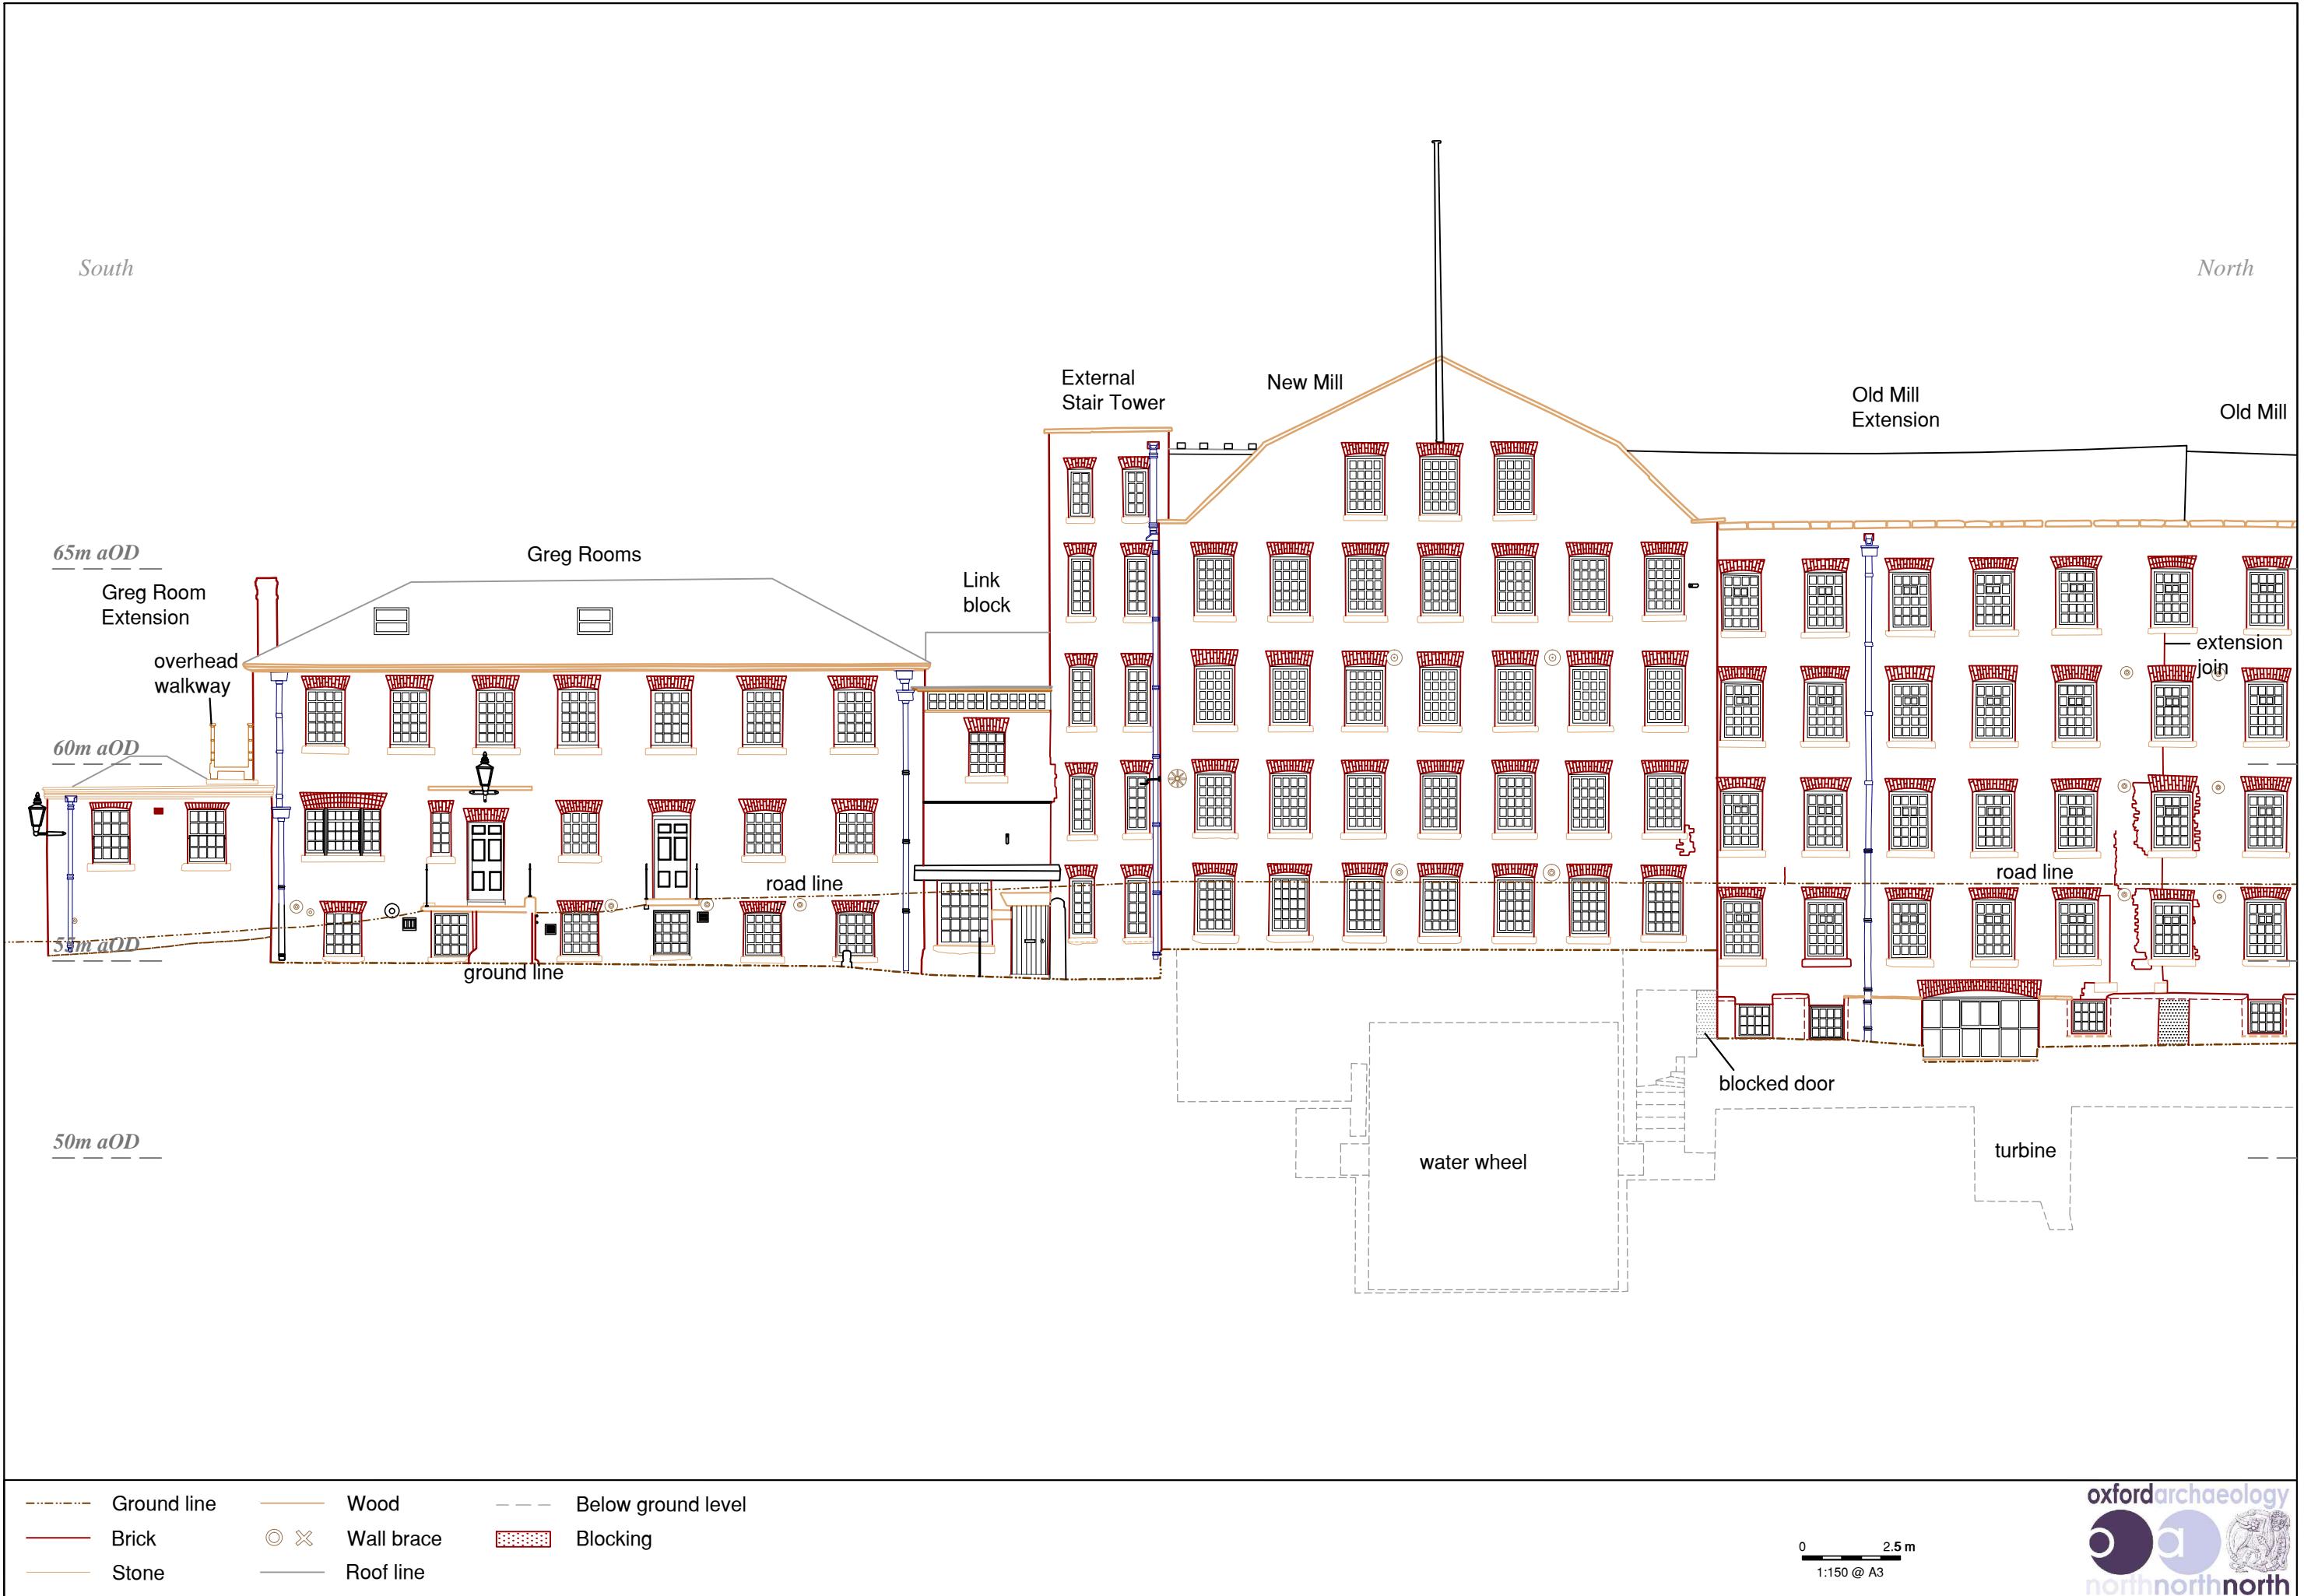


Figure 145: Elevation 3 Greg Rooms and New Mill (South)

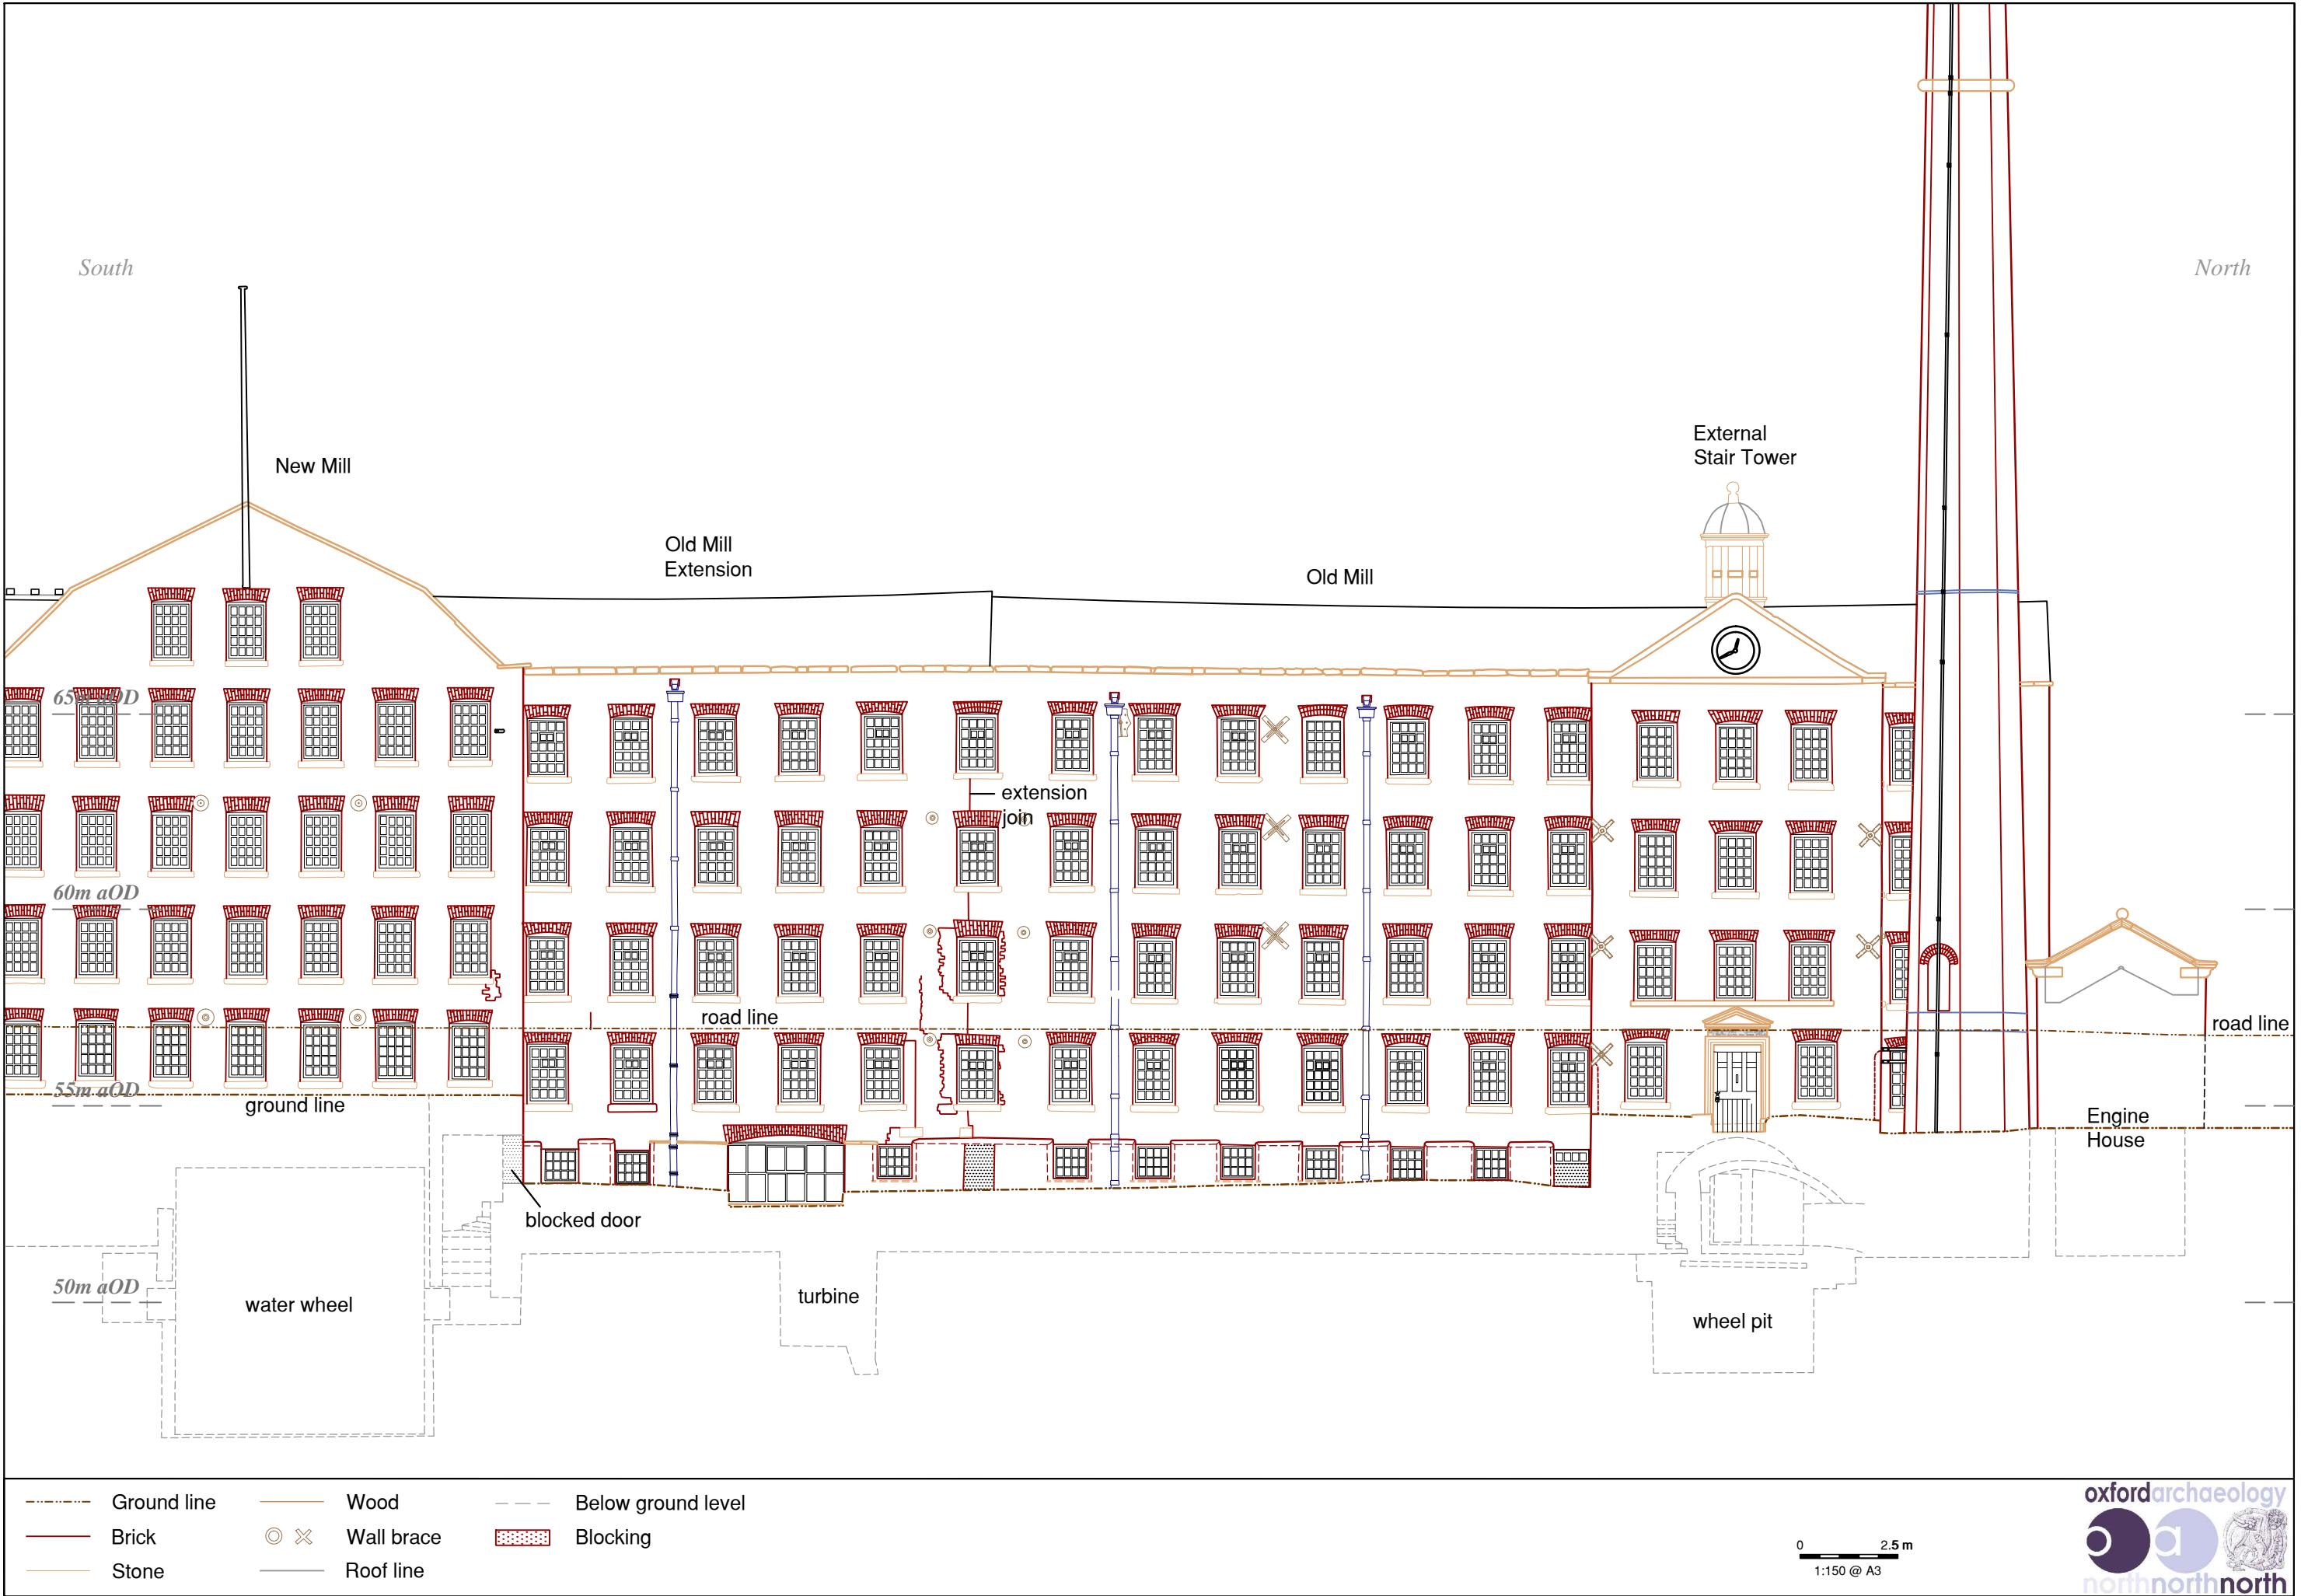


Figure 146: Elevation 3 - New Mill and Old Mill (North)

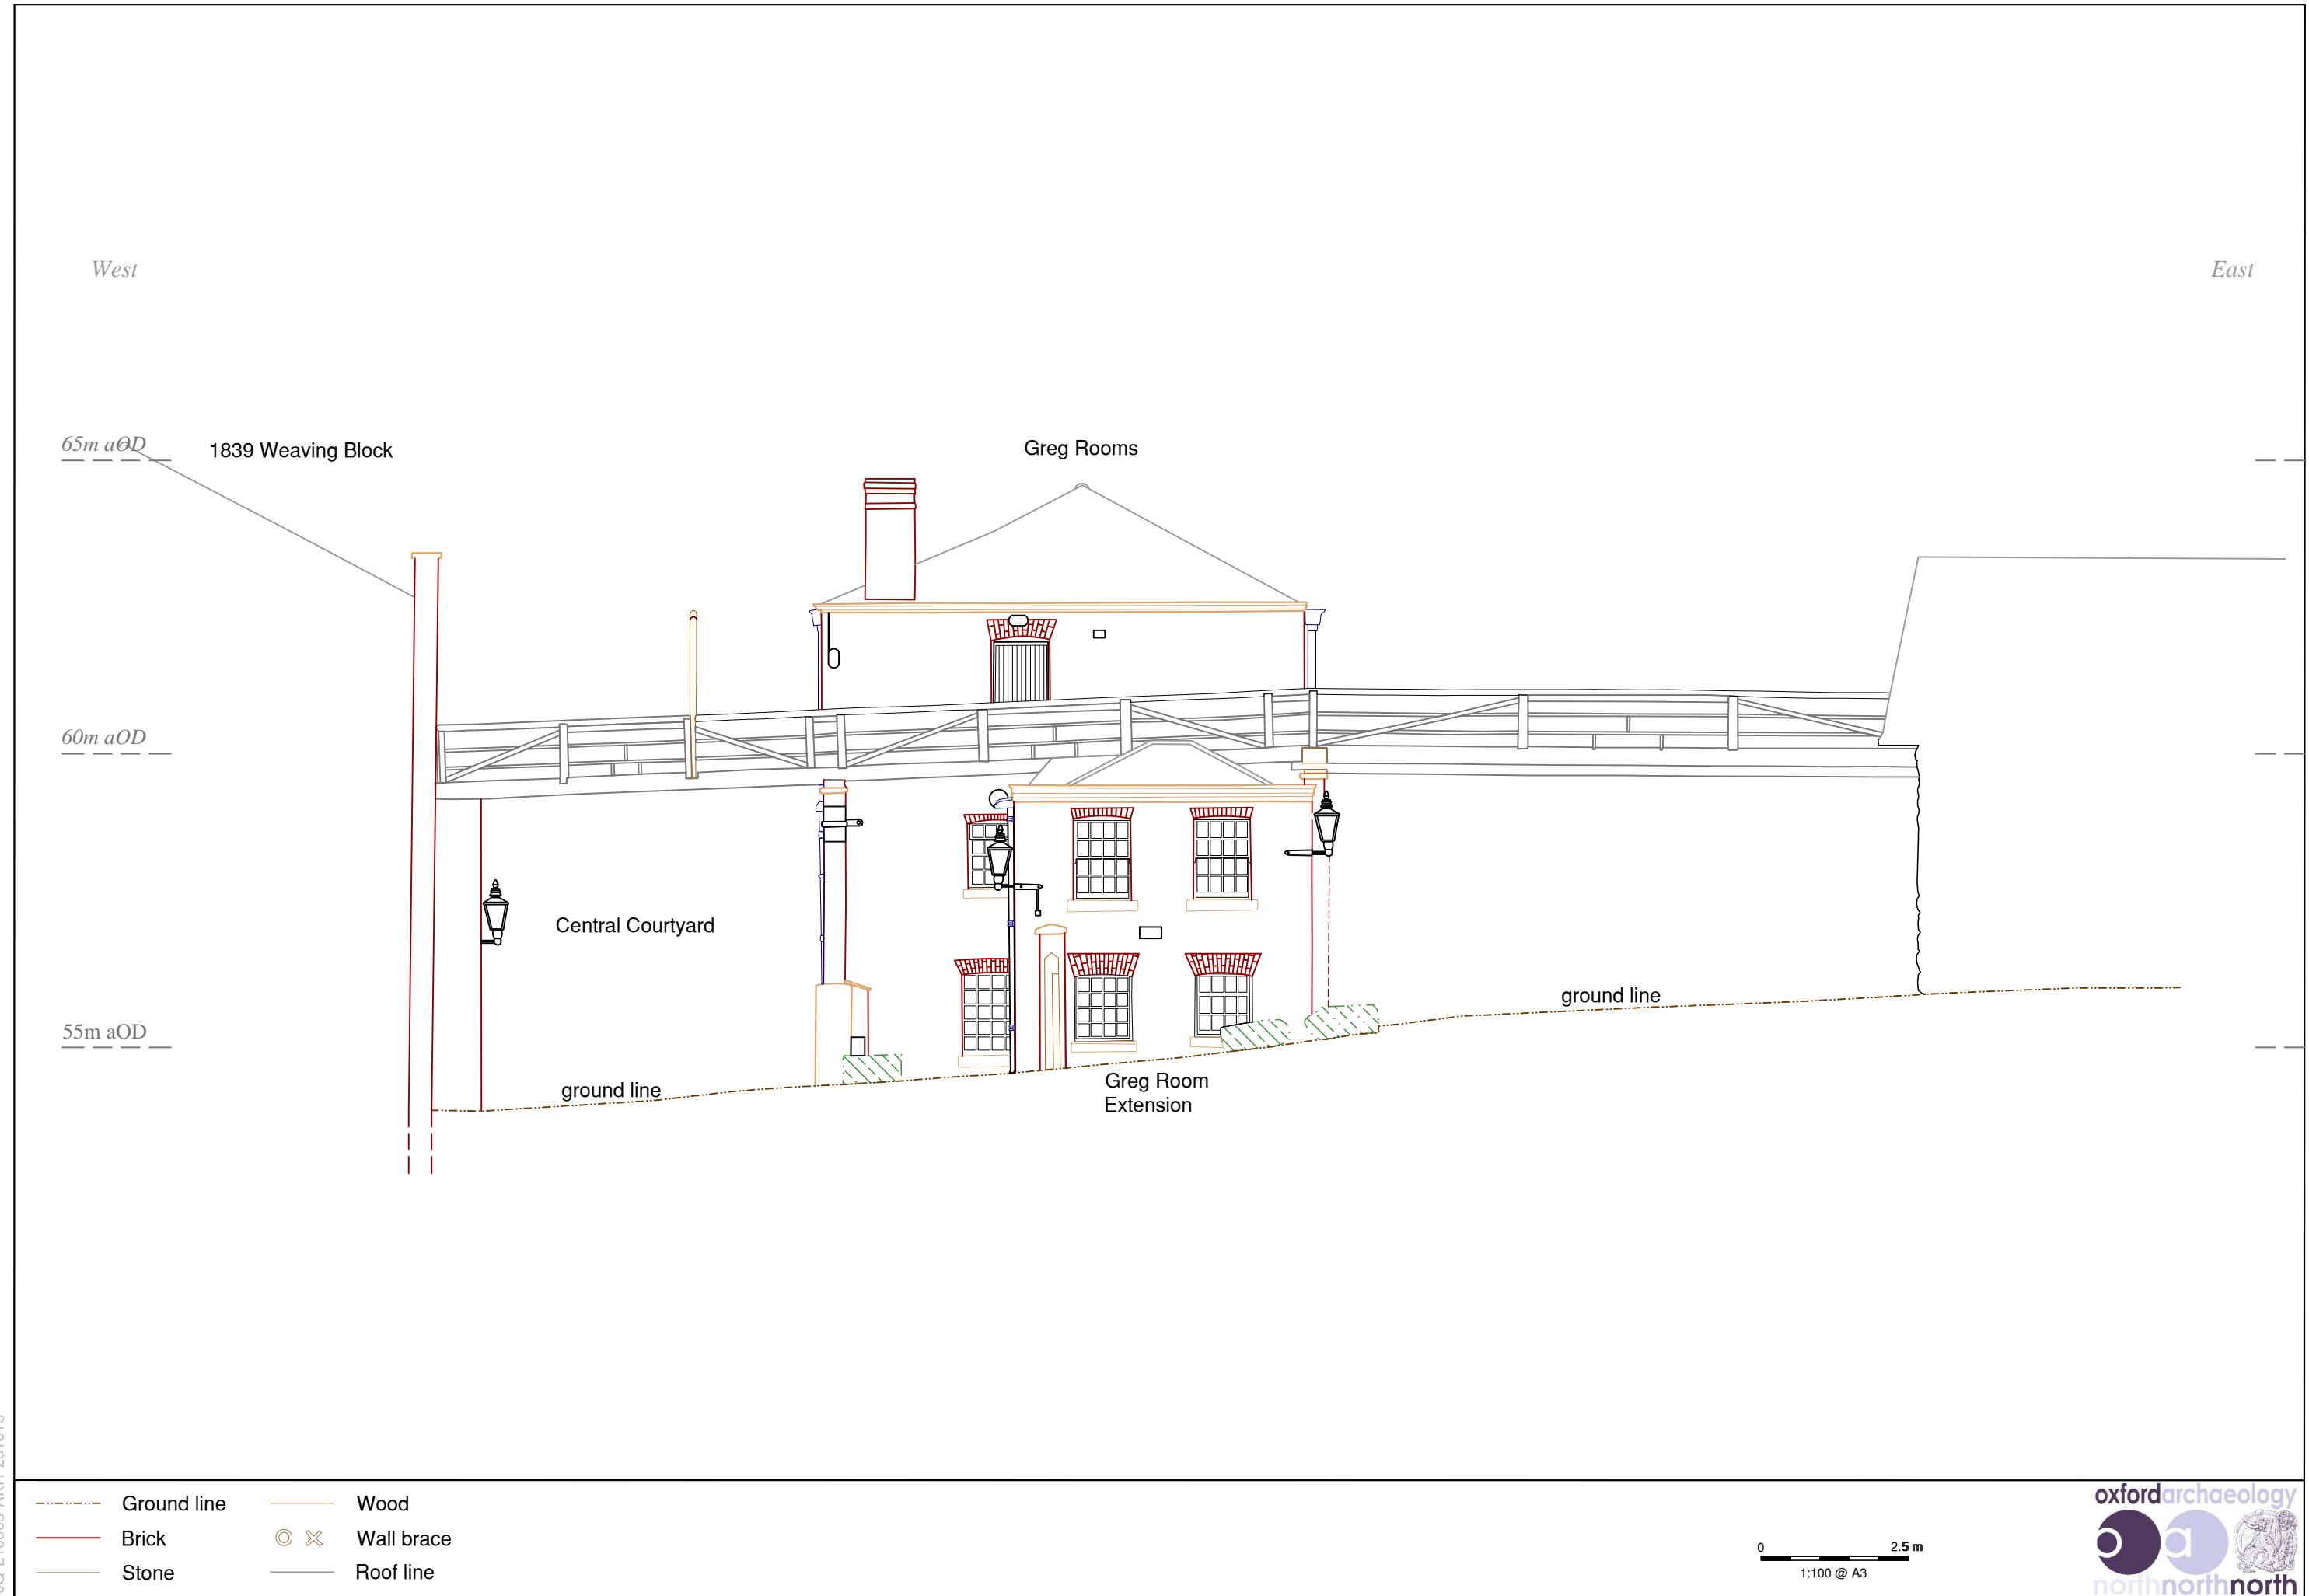




Figure 148: Elevation 4 - Greg Rooms showing laser scan data



South

North

1839 Weaving Block



JQ*L10603*AKH*231013

- Ground line
- Brick
- Stone
- Wood
- Wall brace
- Roof line
- ☒ Obscured

0 2.5 m
1:100 @ A3

Figure 150: Elevation 5 - 1839 Weaving Block showing laser scan data



Figure 151: Elevation 6 - 1836 Weaving Block



Figure 152: Elevation 6 - 1836 Weaving Block showing laser scan data



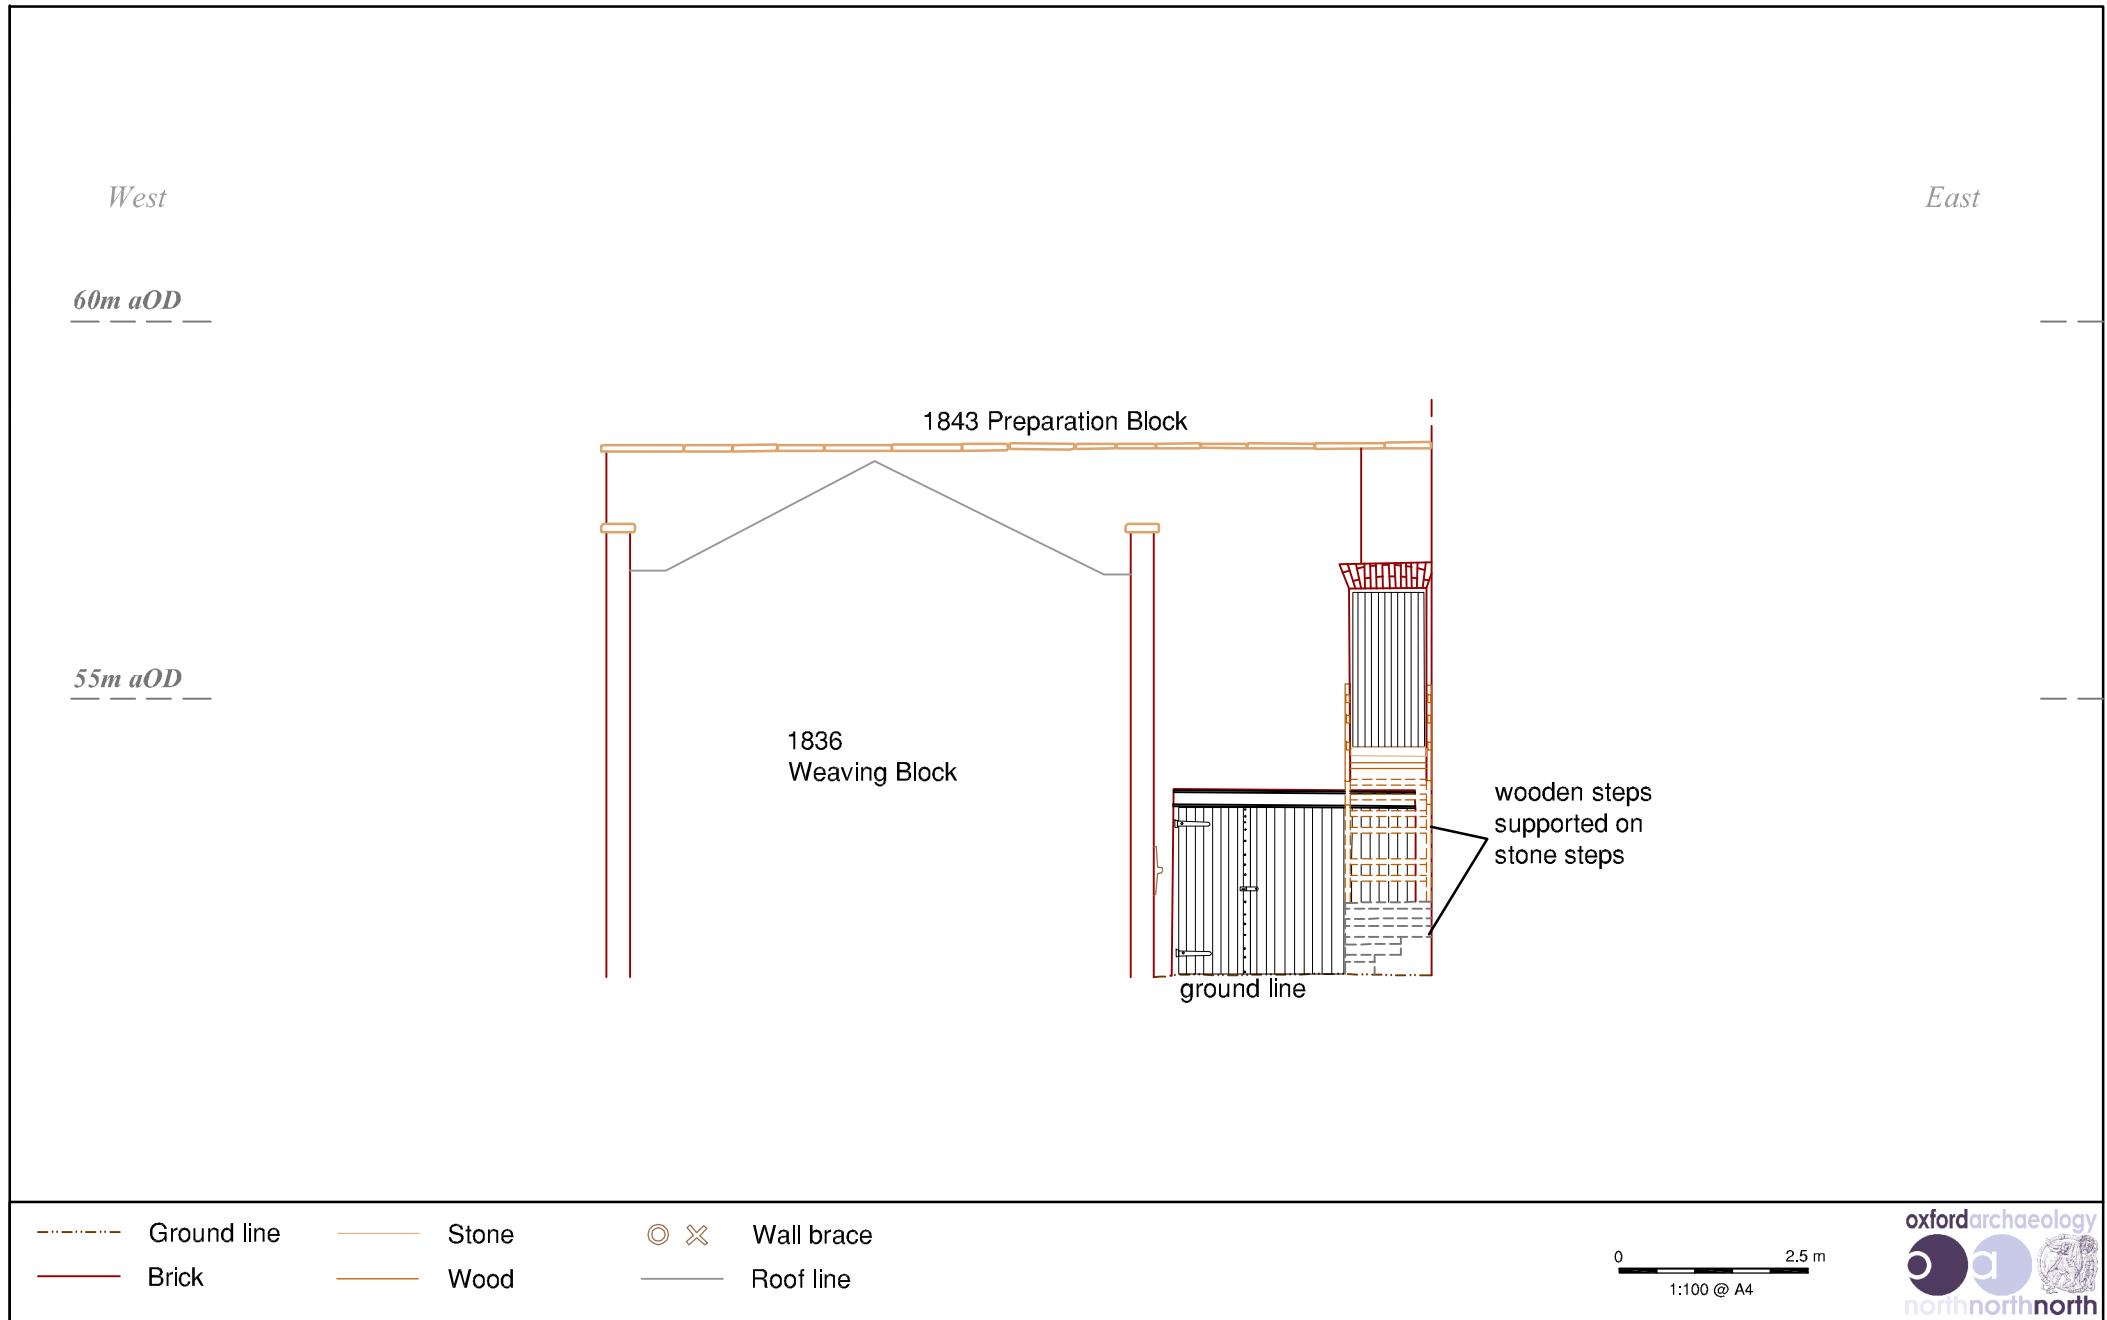


Figure 153: Elevation 7 - 1843 Preparation Block Southern Elevation

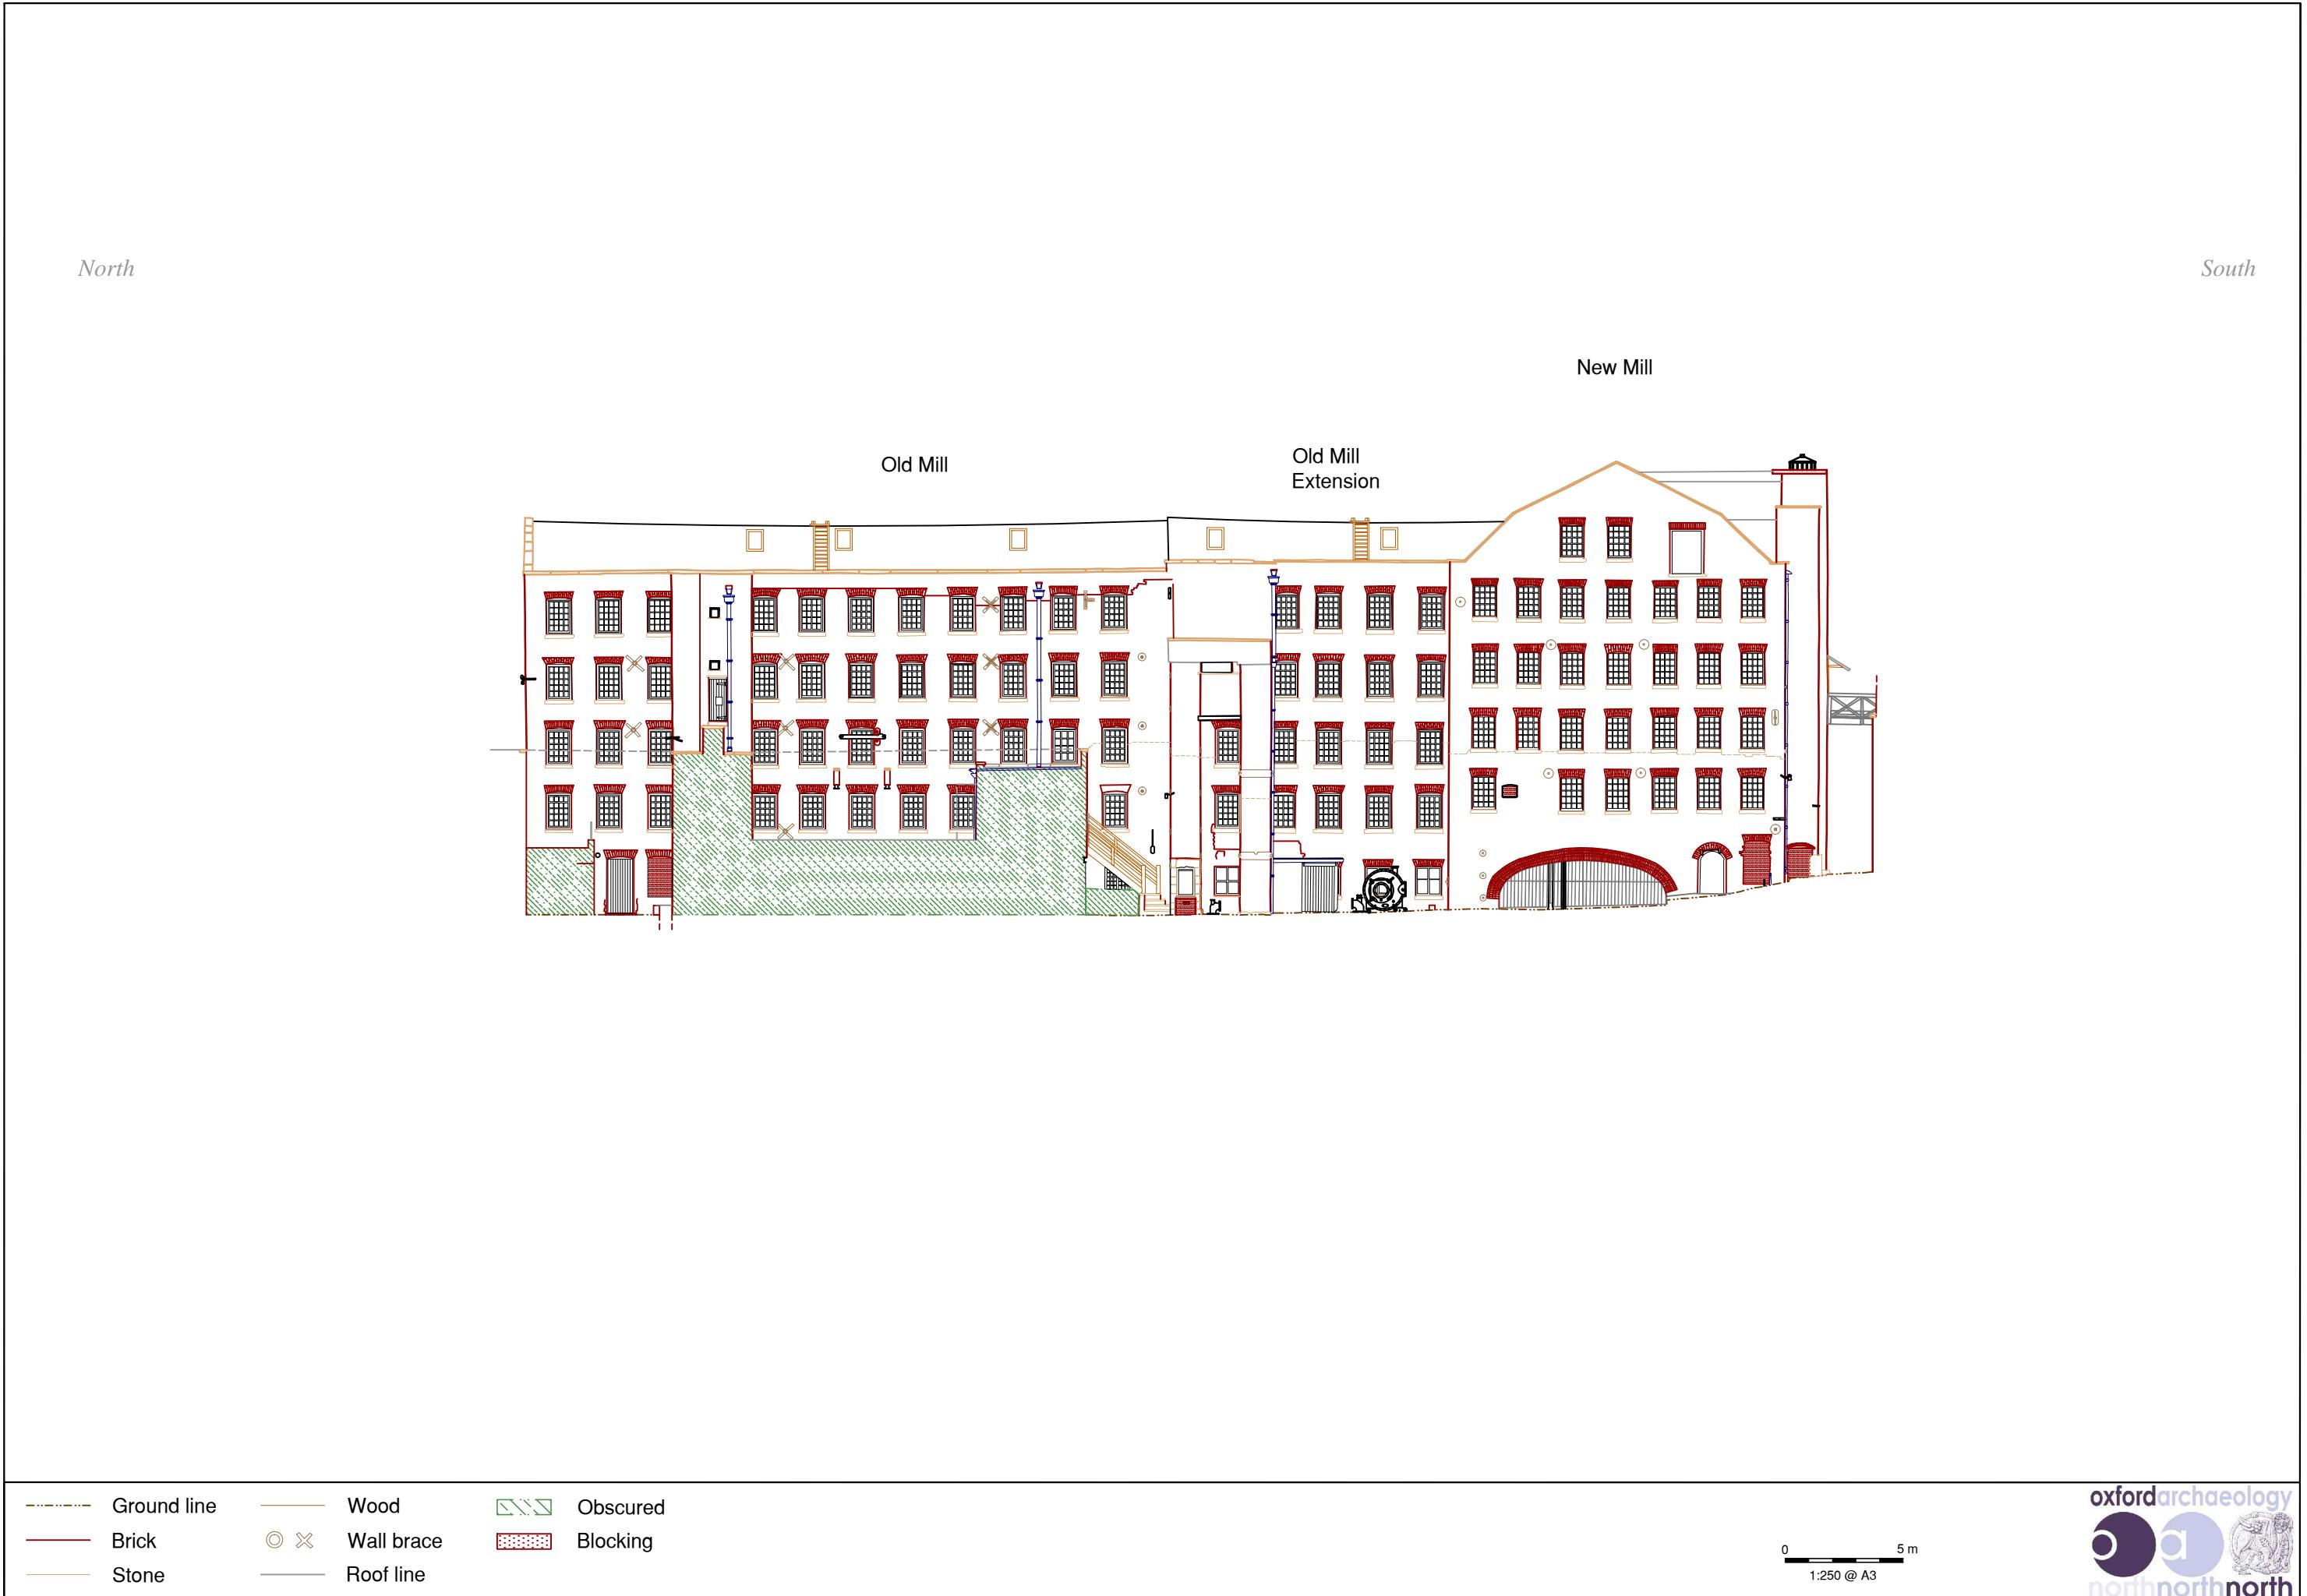

North

South

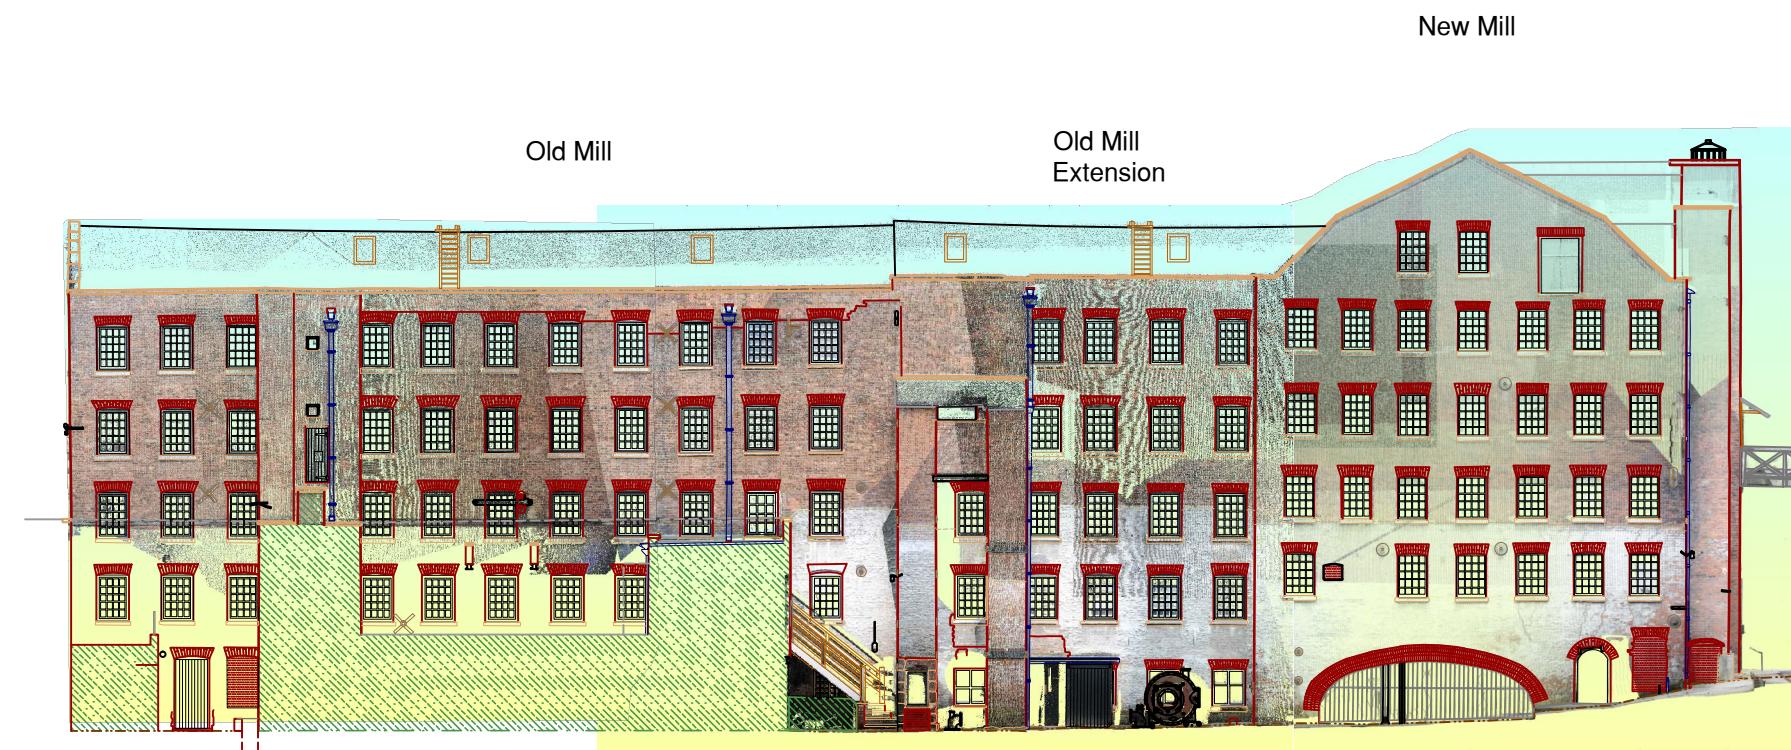

JQ*L10603*AMS*251013

- Ground line
- Wood
- Obscured
- Brick
- X Wall brace
- Blocking
- Stone
- Roof line

0 5 m
1:250 @ A3


Figure 155: Elevation 8 - Old and New Mills, Western Elevation showing laser scan data



North

South

Old Mill

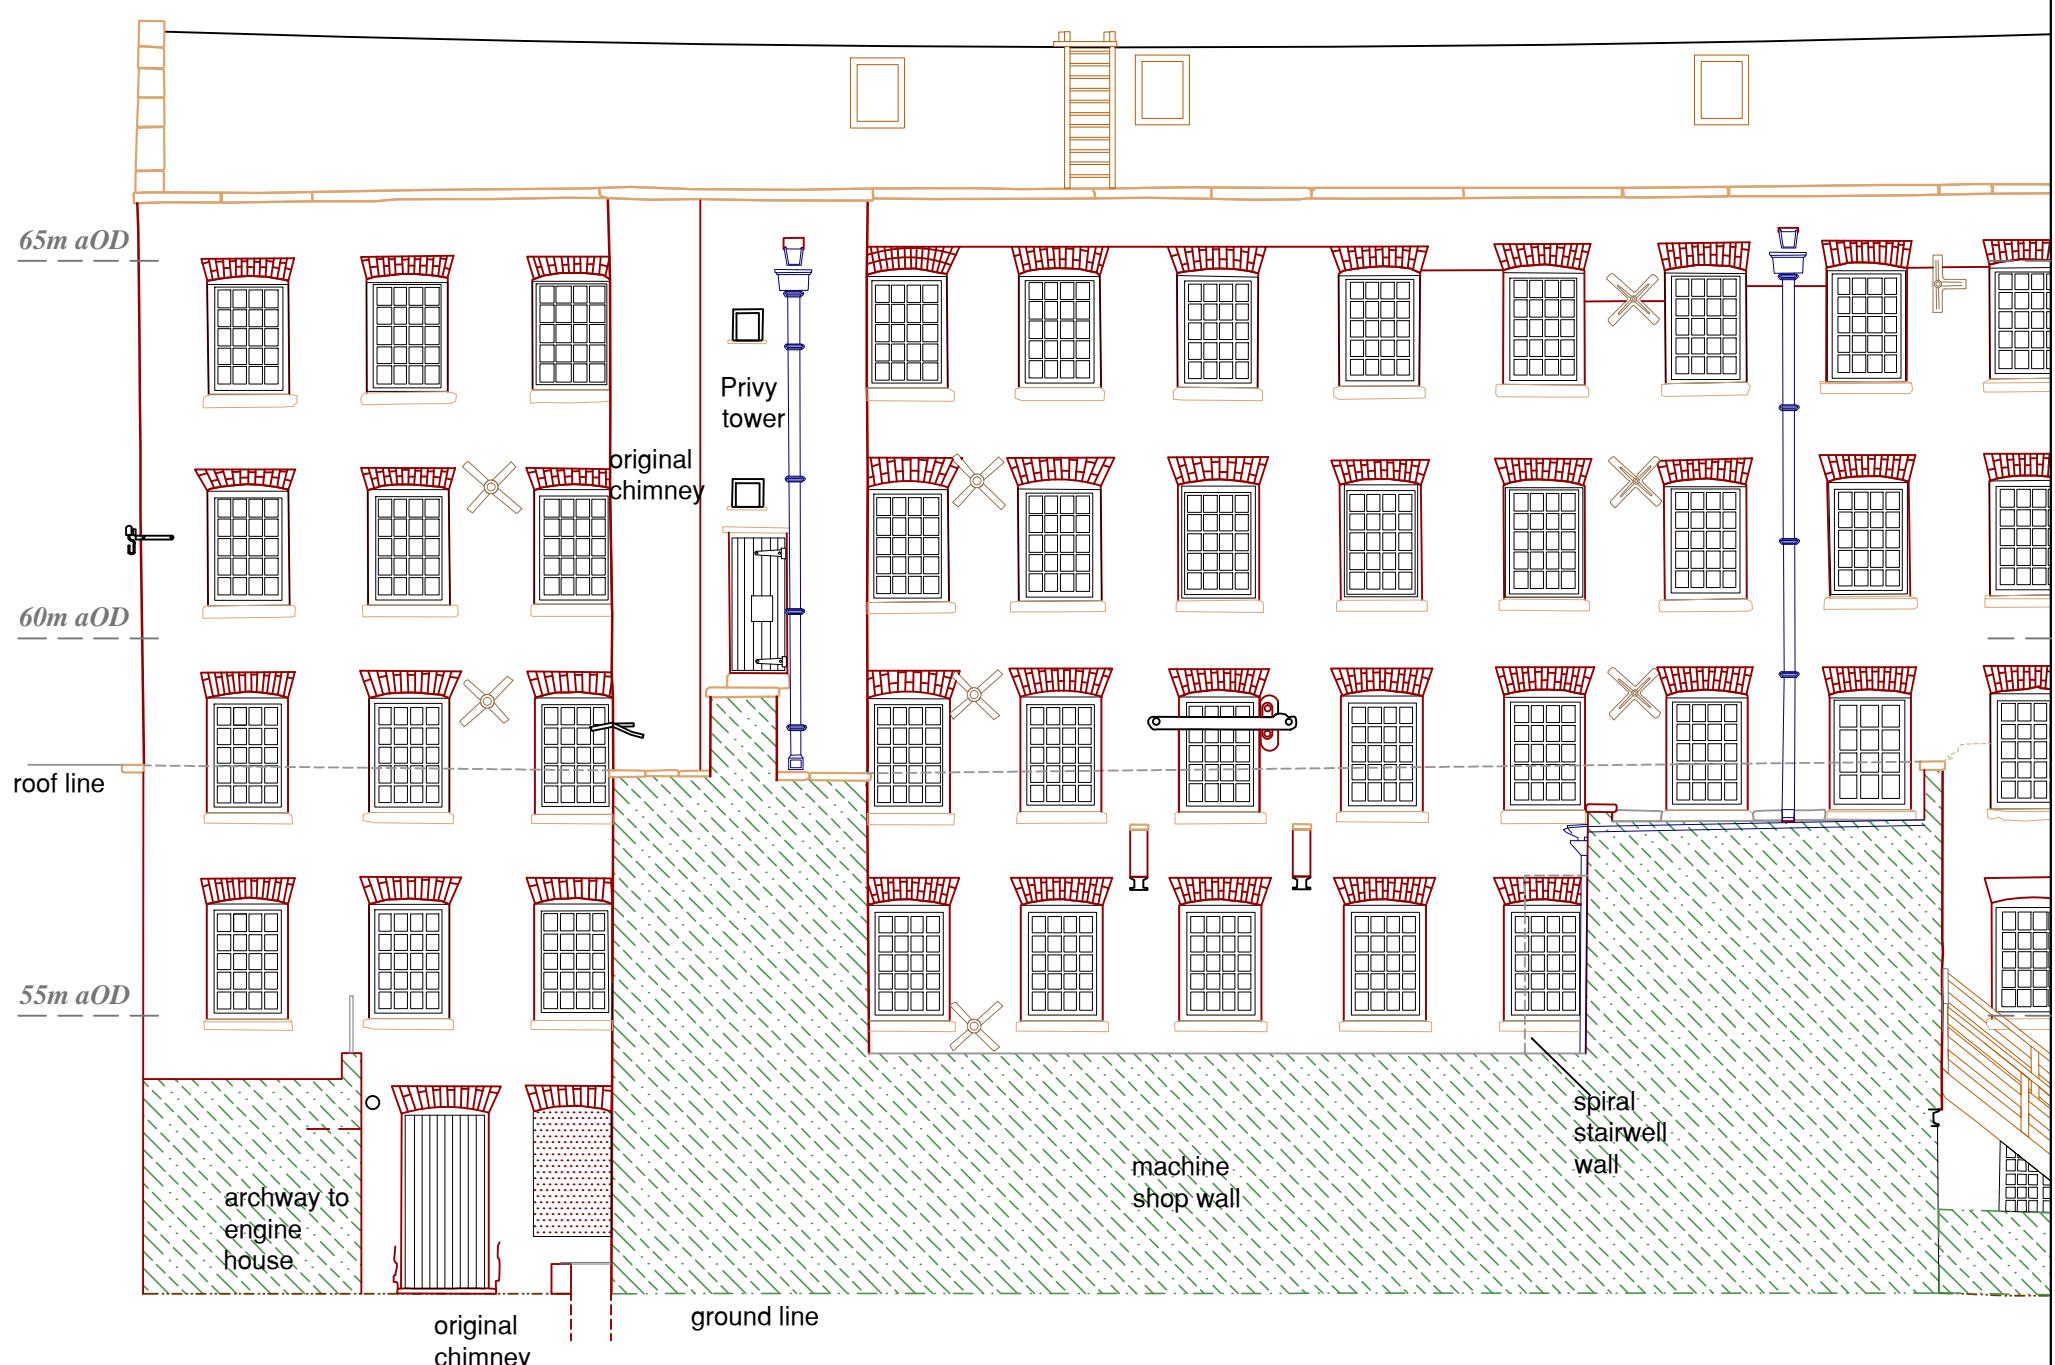

Ground line	Wood	Obscured
Brick	○ X	Wall brace
Stone	—	Roof line

0 2.5 m
1:100 @ A3

Figure 156: Elevation 8 - Old Mill (North)

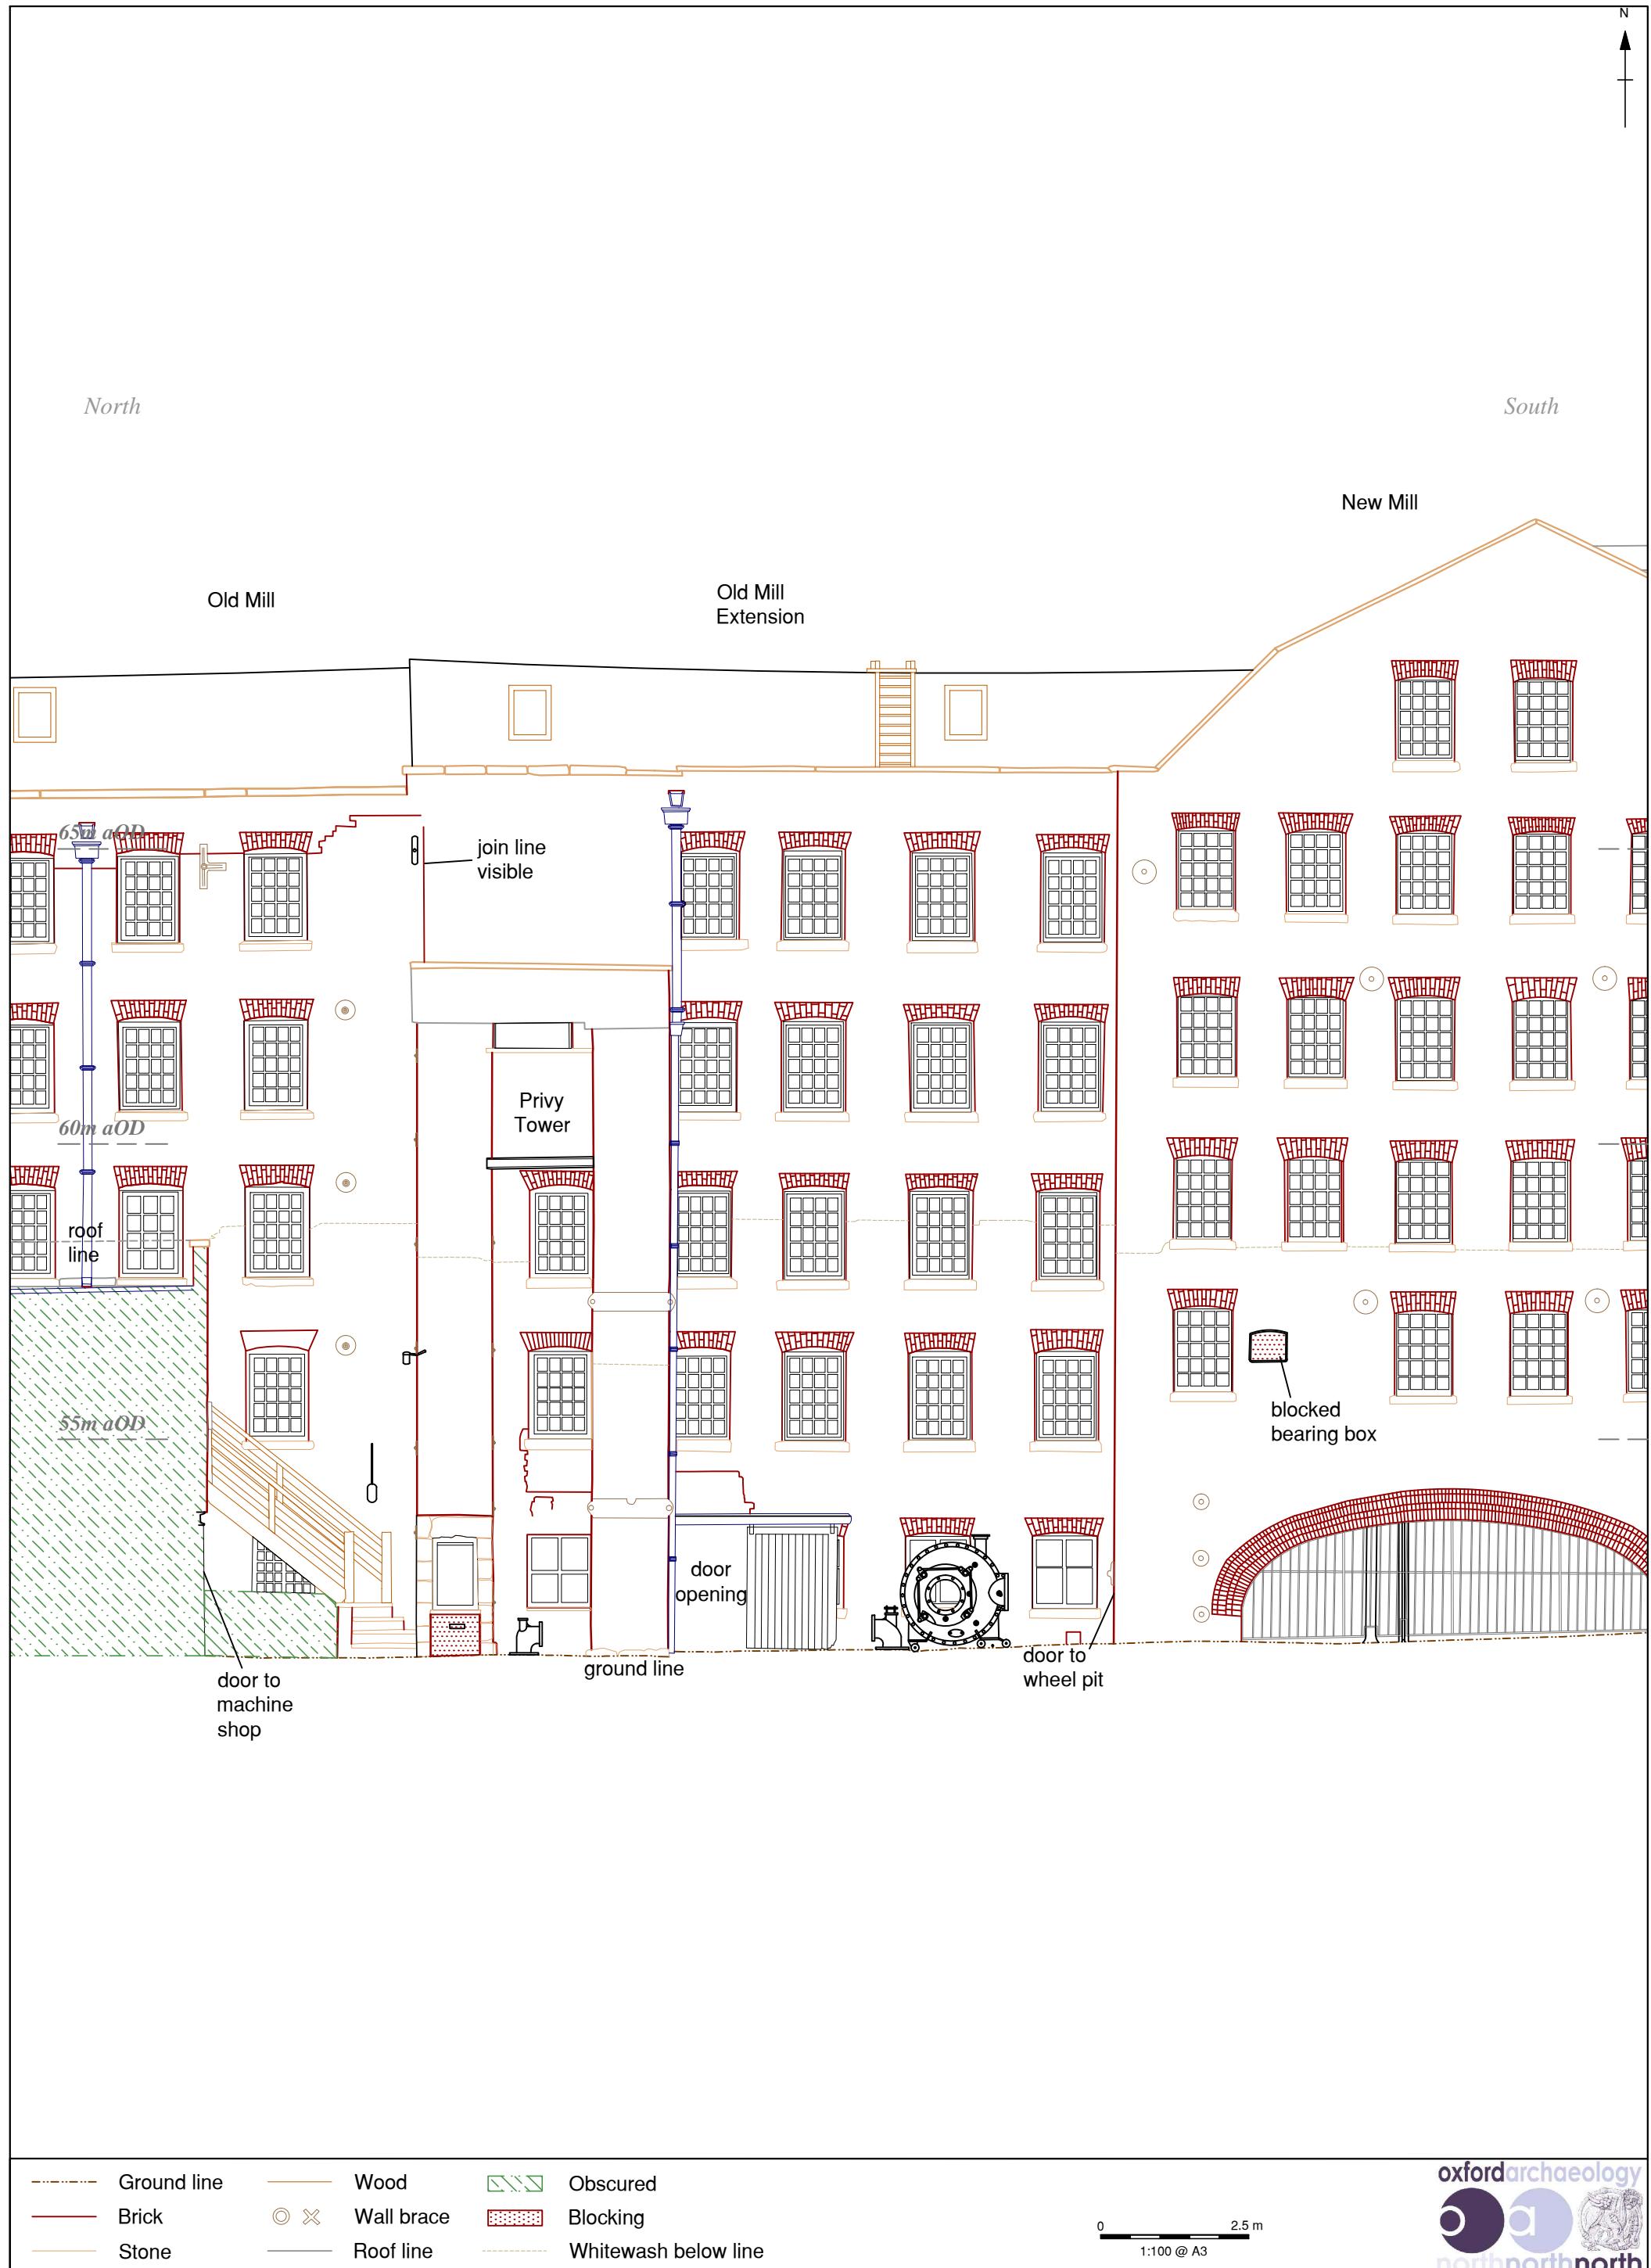
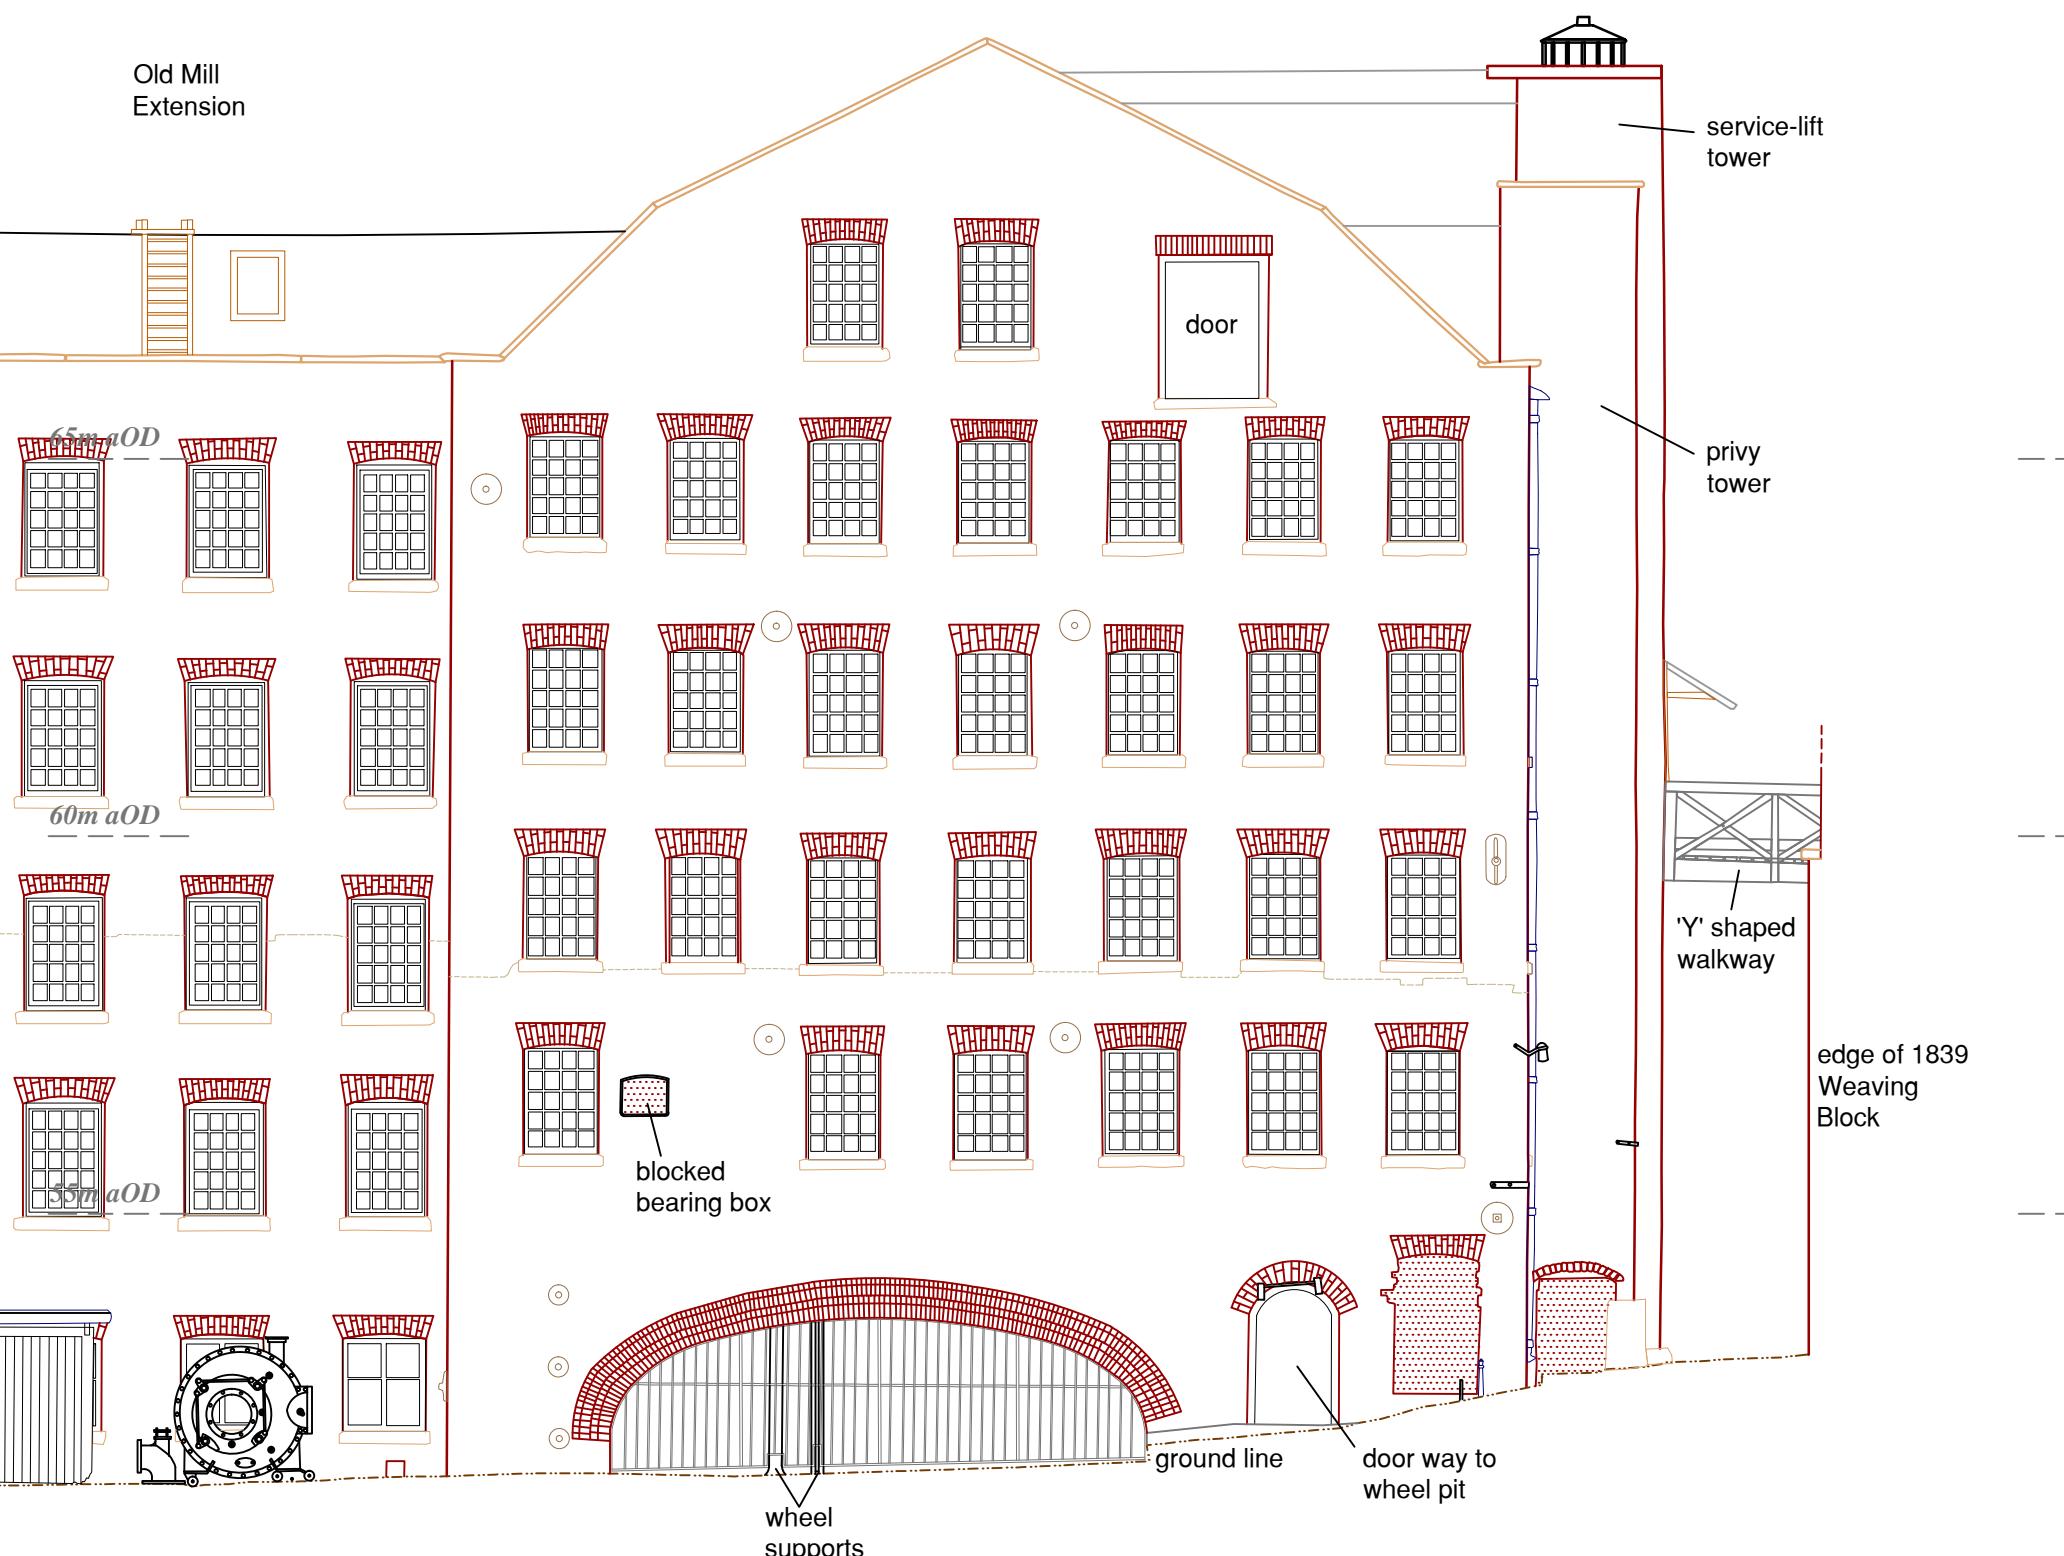


Figure 157: Elevation 8 - Old Mill Extension (Central)

North

South

New Mill

Old Mill
Extension

Ground line	Wood	Obscured
Brick	Wall brace	Blocking
Stone	Roof line	Whitewash below line

0 2.5 m
1:100 @ A3

Figure 158: Elevation 8 - New Mill (South)

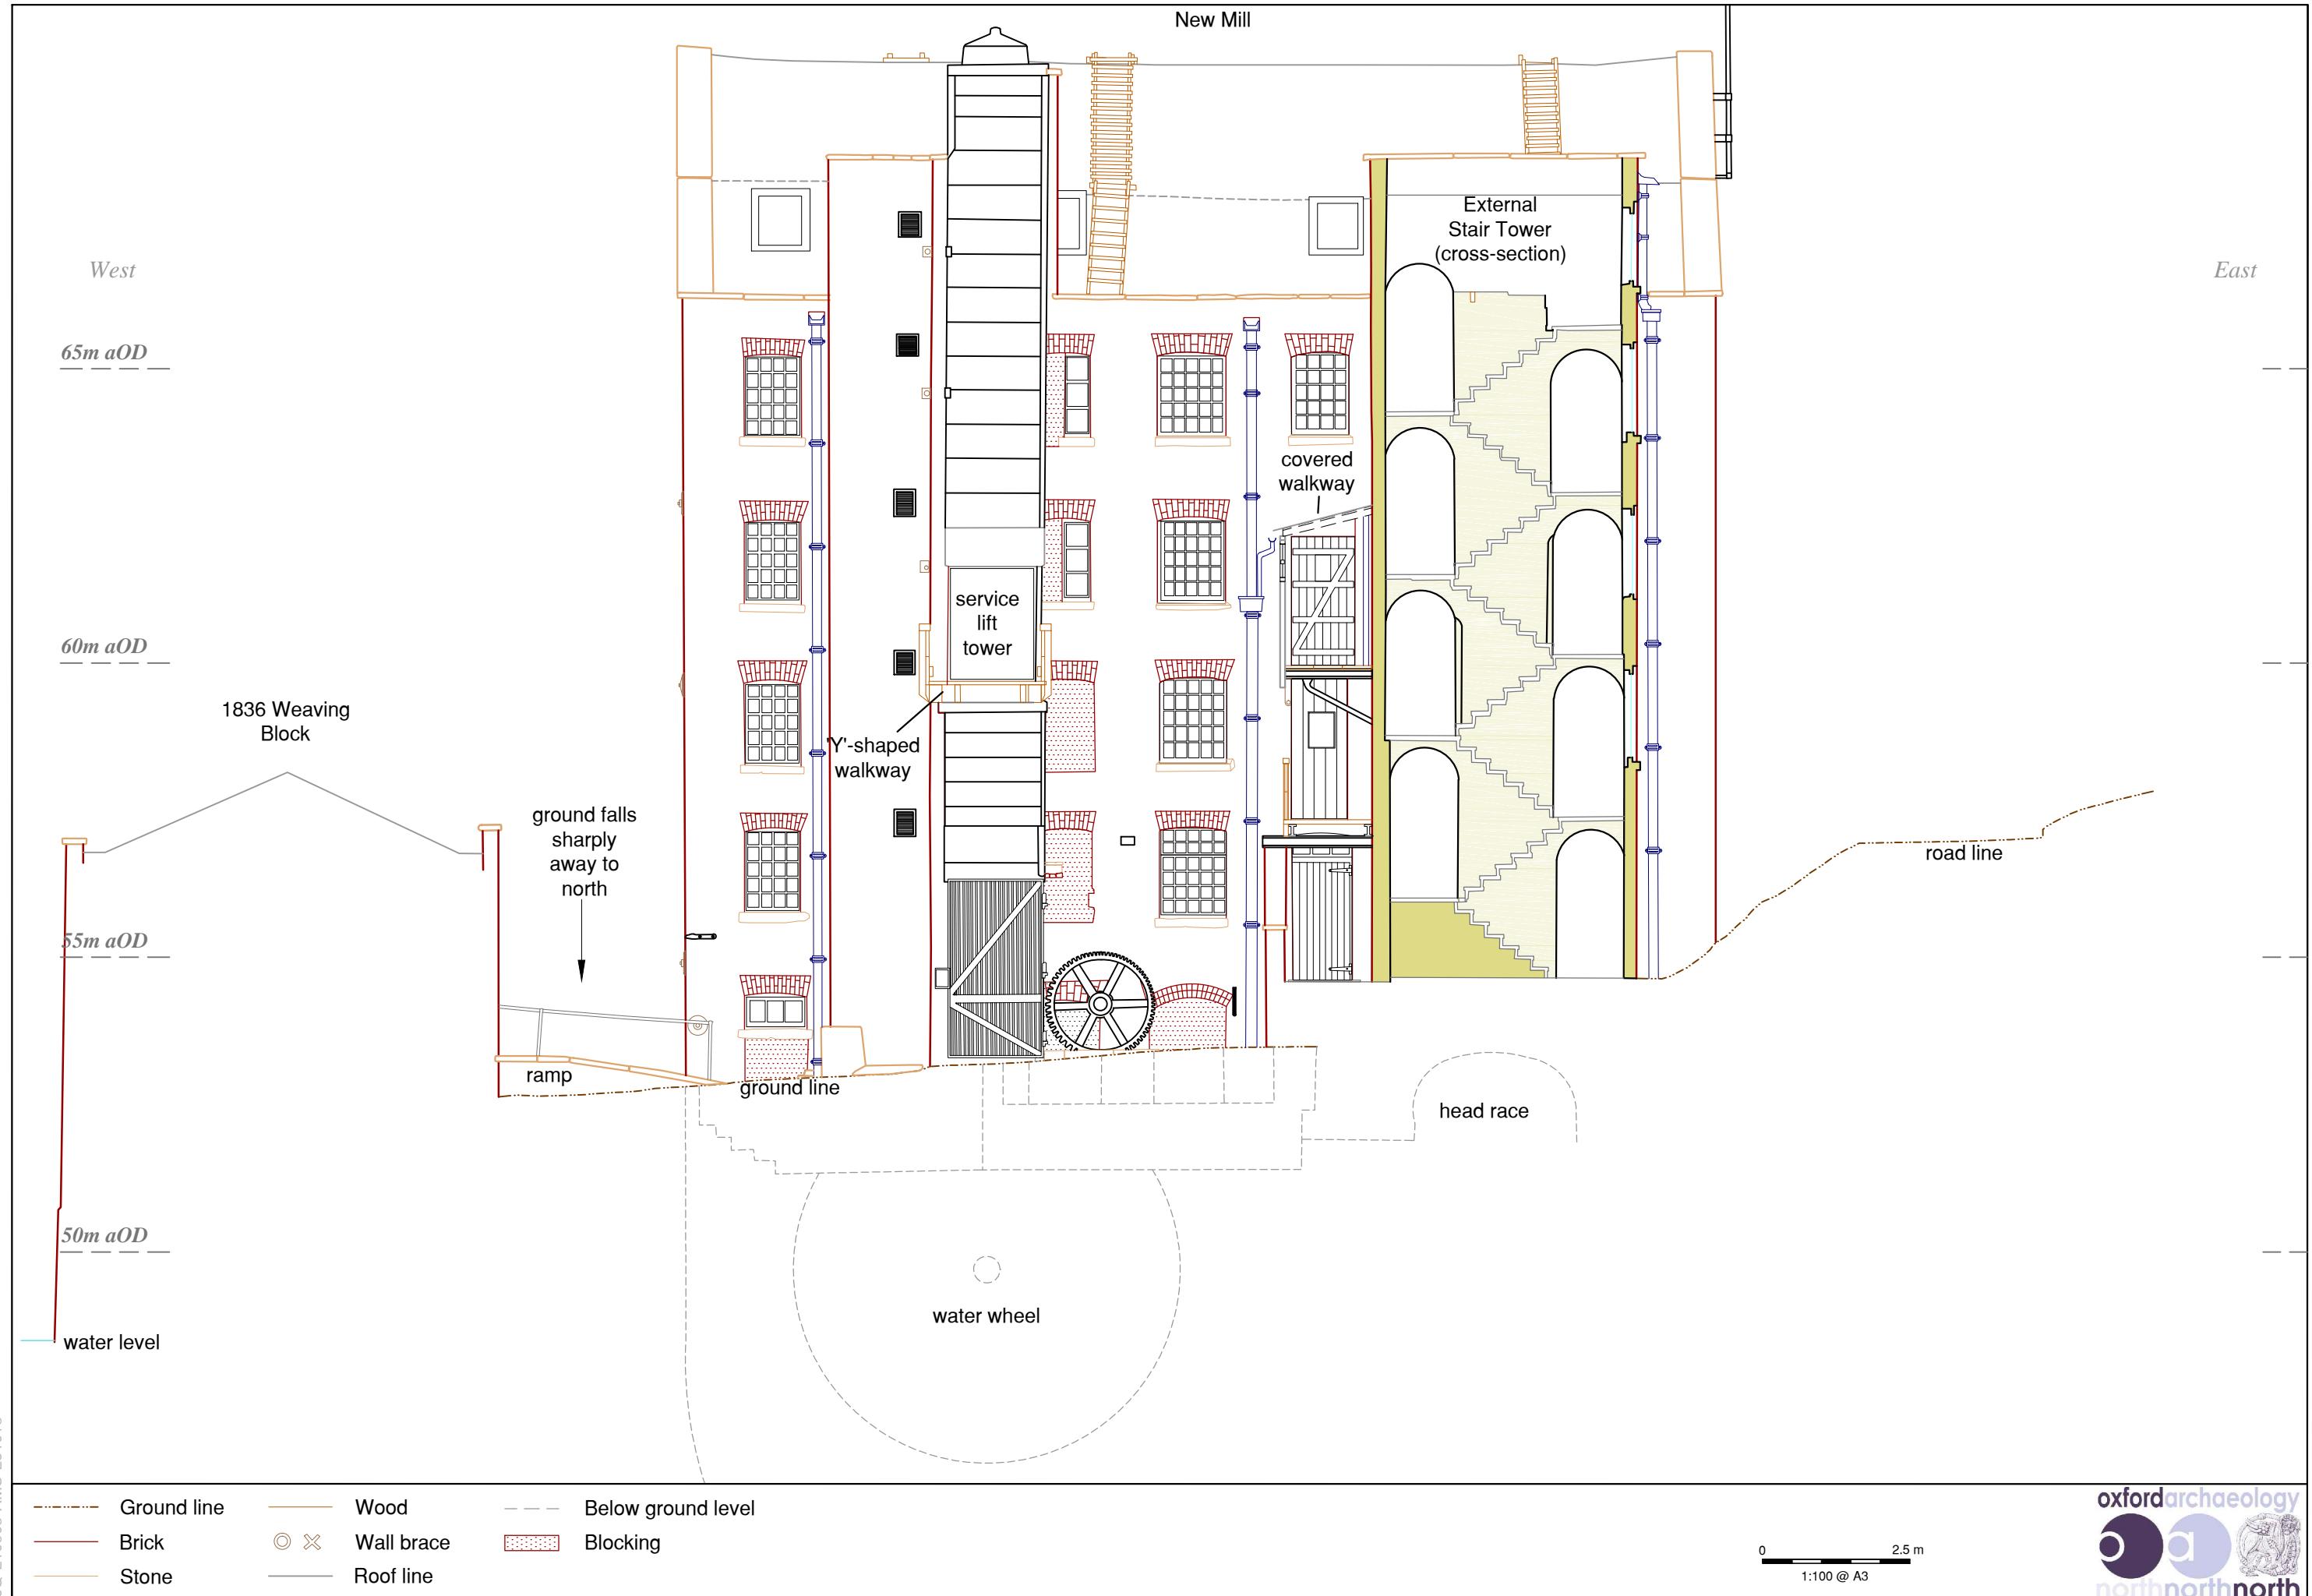


Figure 159: Elevation 9 - New Mill Southern Elevation and Cross Section through Stair Tower



Figure 160: Elevation 9 - New Mill Southern Elevation and Cross Section through Stair Tower showing laser scan data

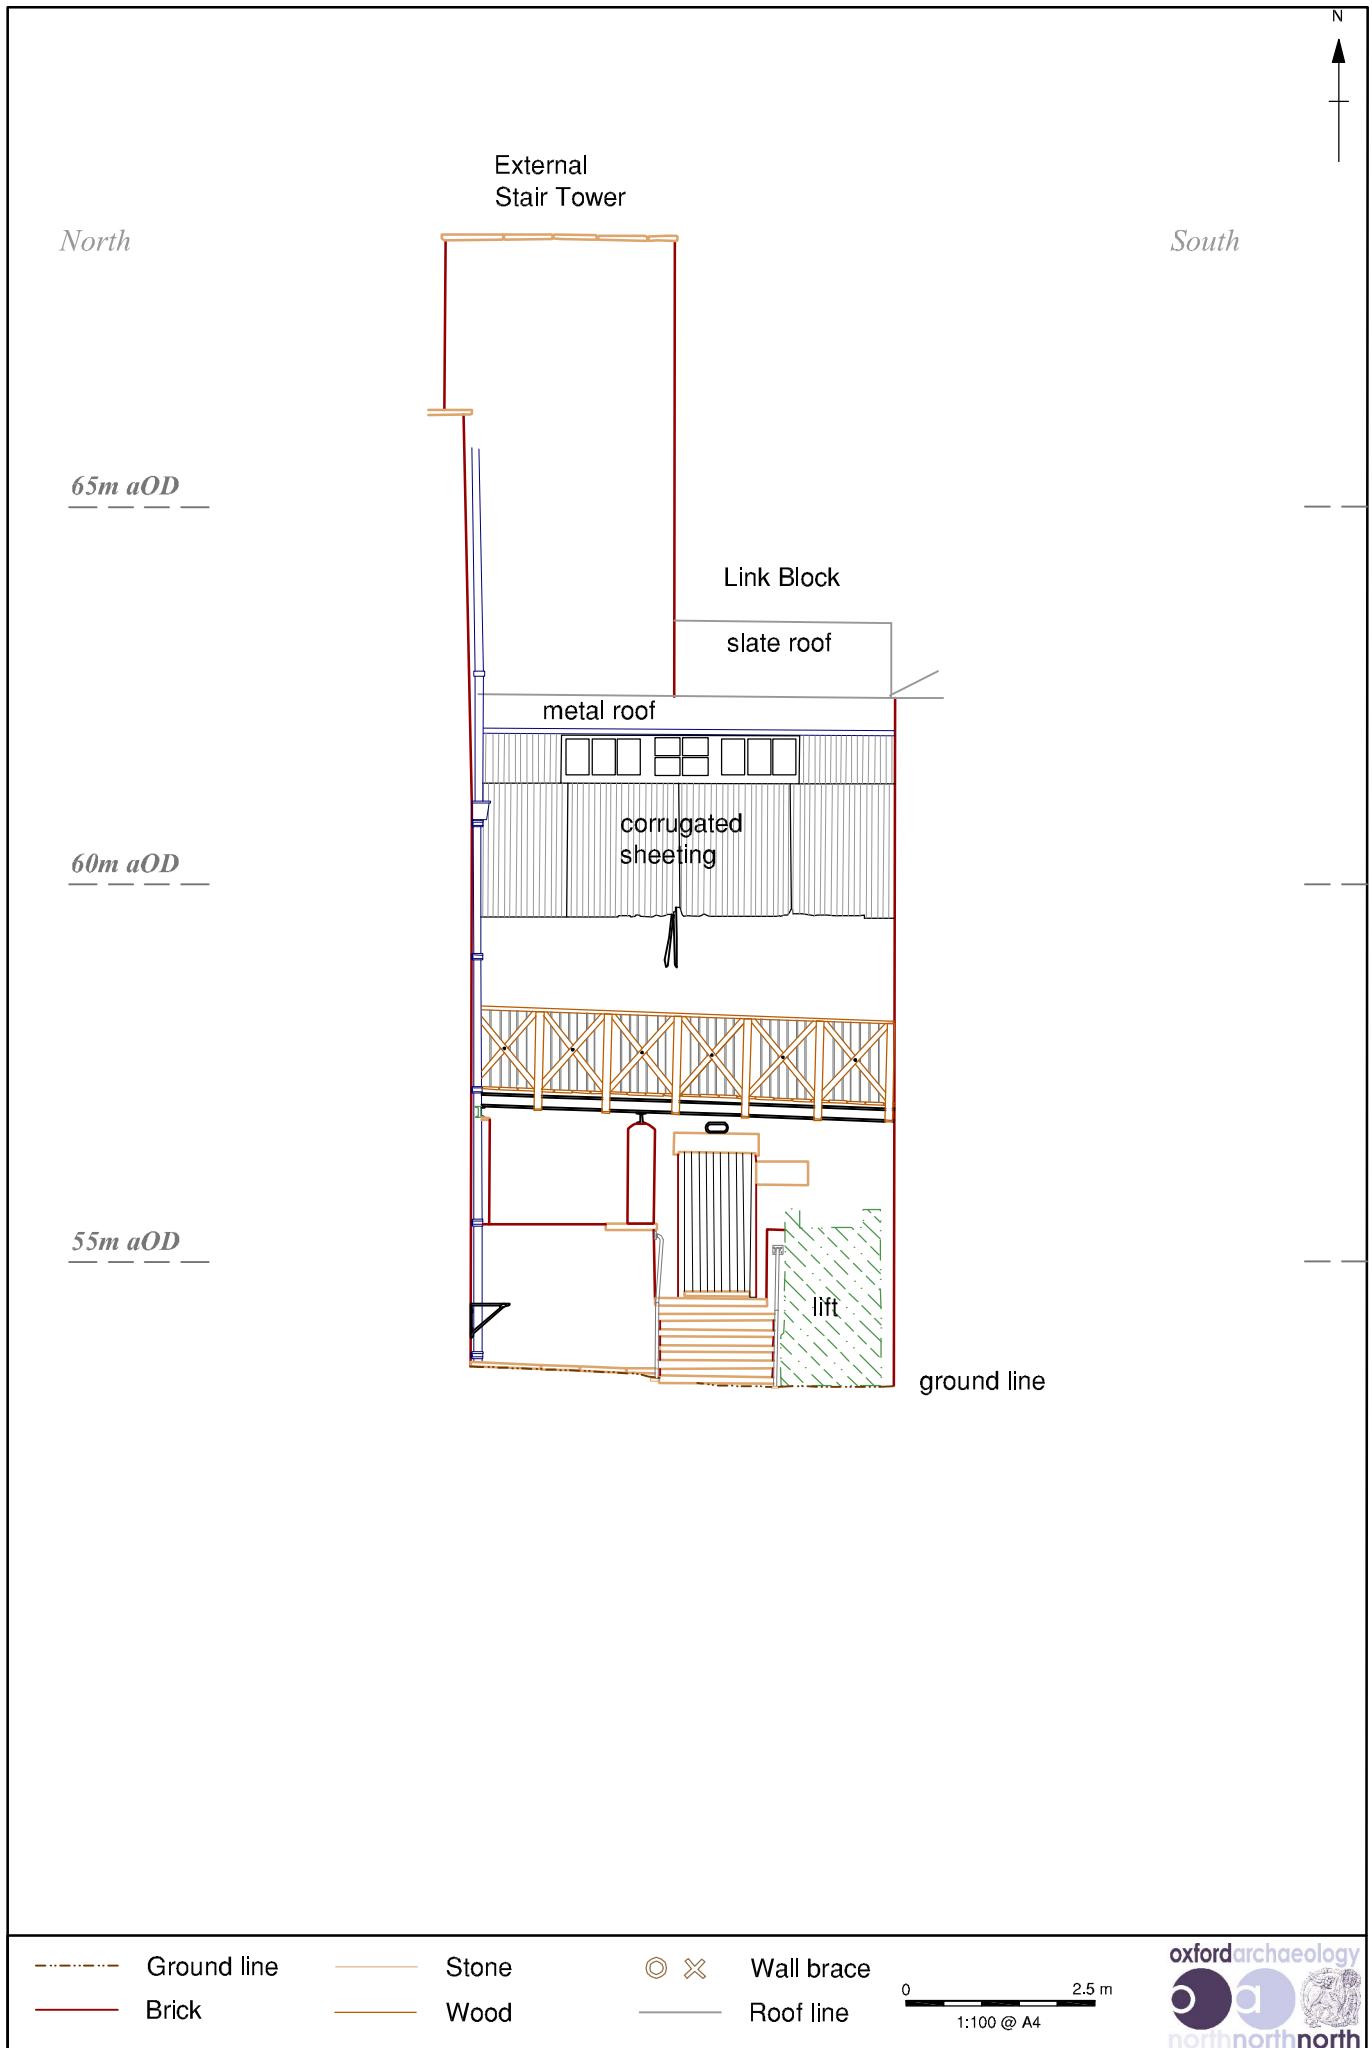


Figure 161: Elevation 10 - Stair Tower and Link Block Western Elevation

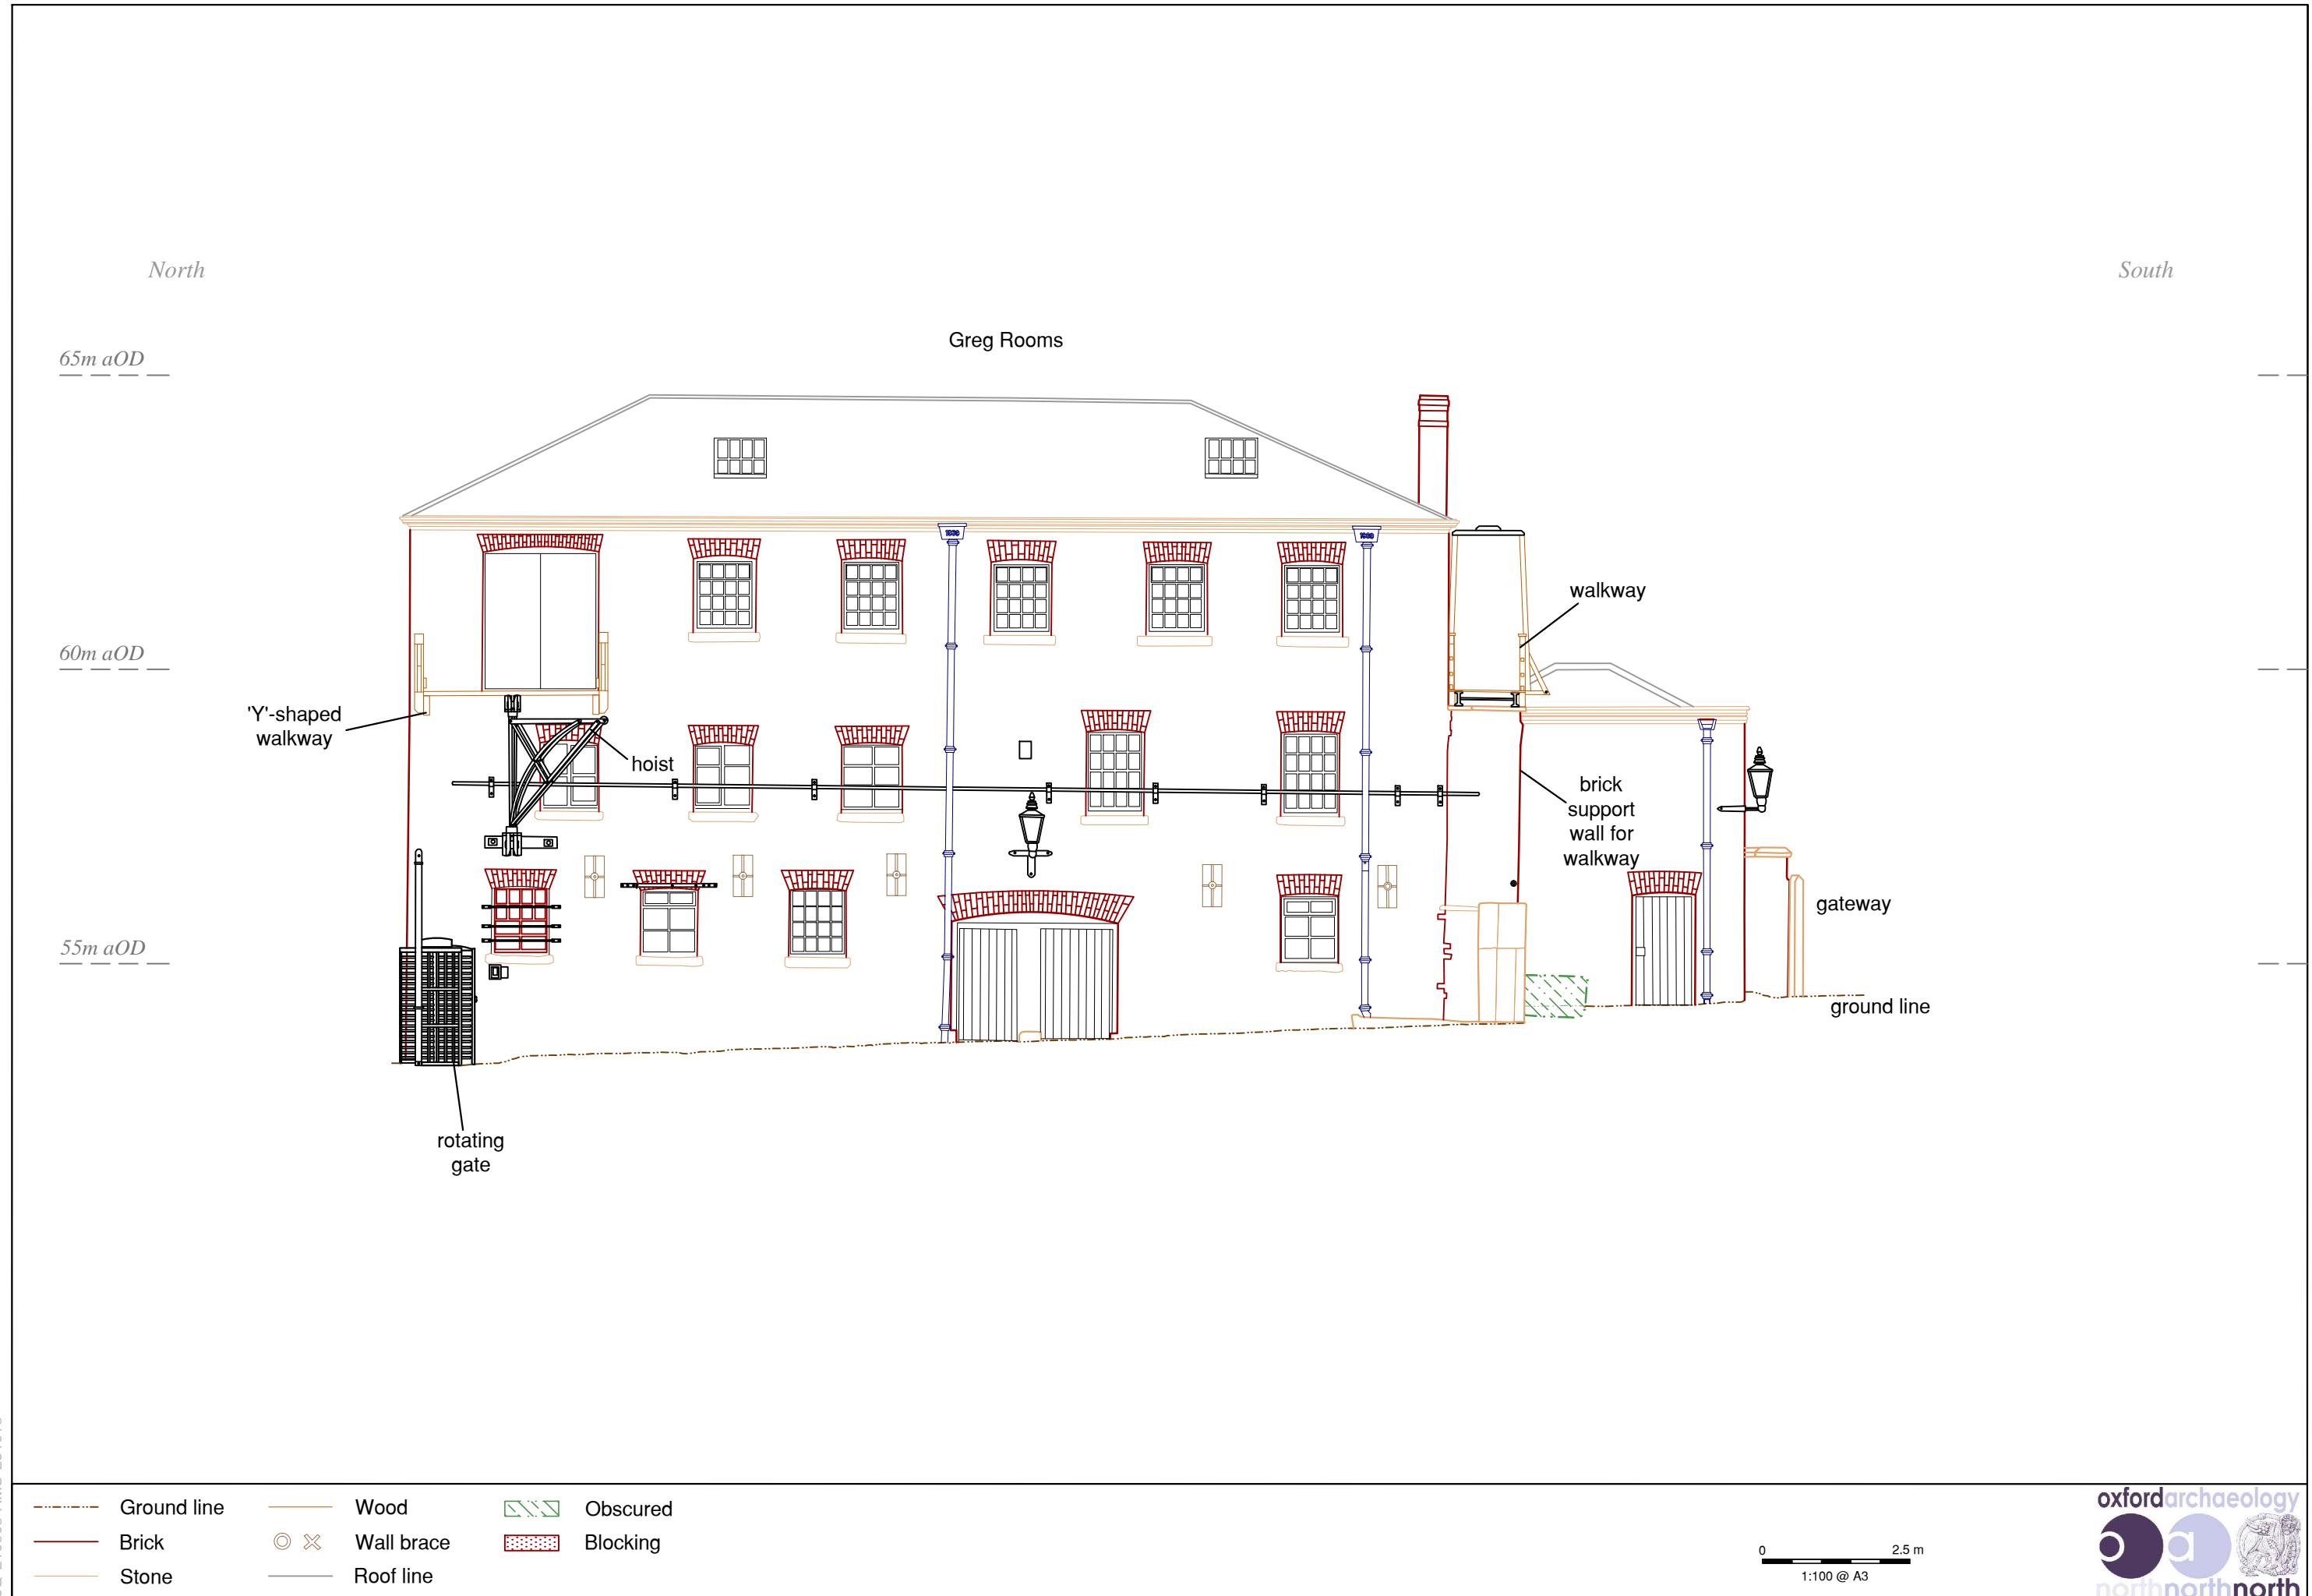


Figure 163: Elevation 12 - Western facing elevation of Greg Rooms

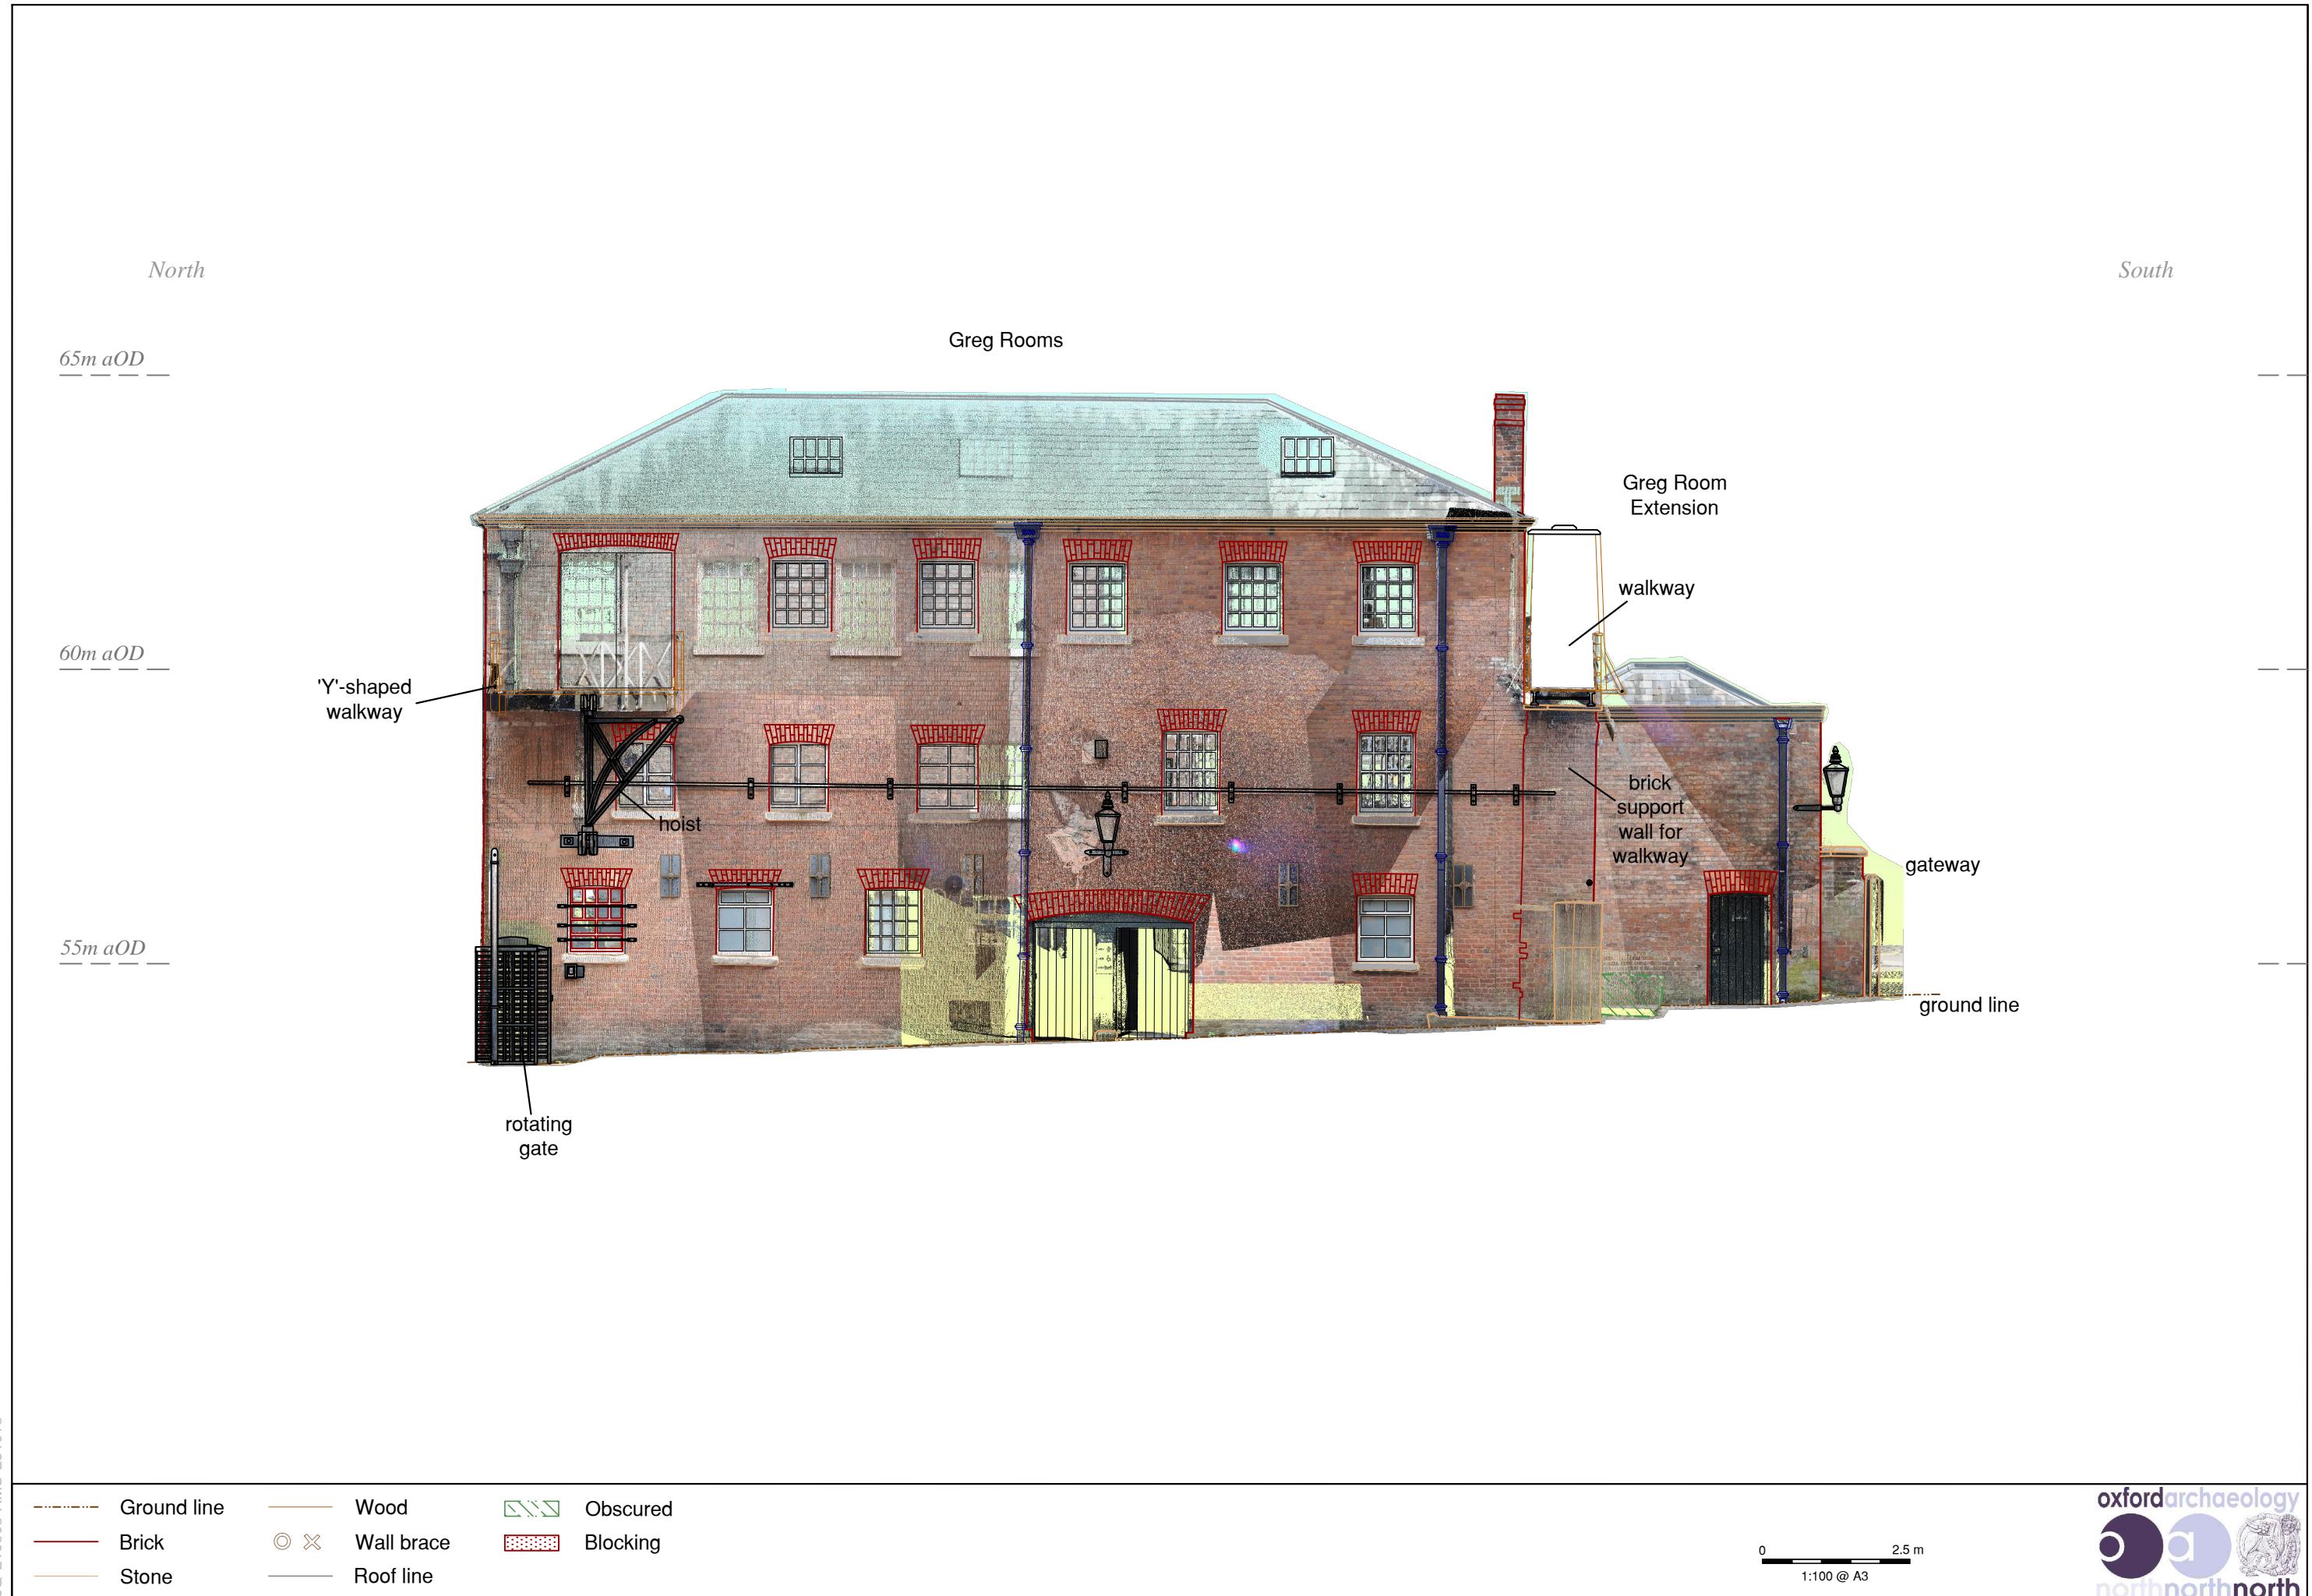




Figure 165: Location of Cross Sections

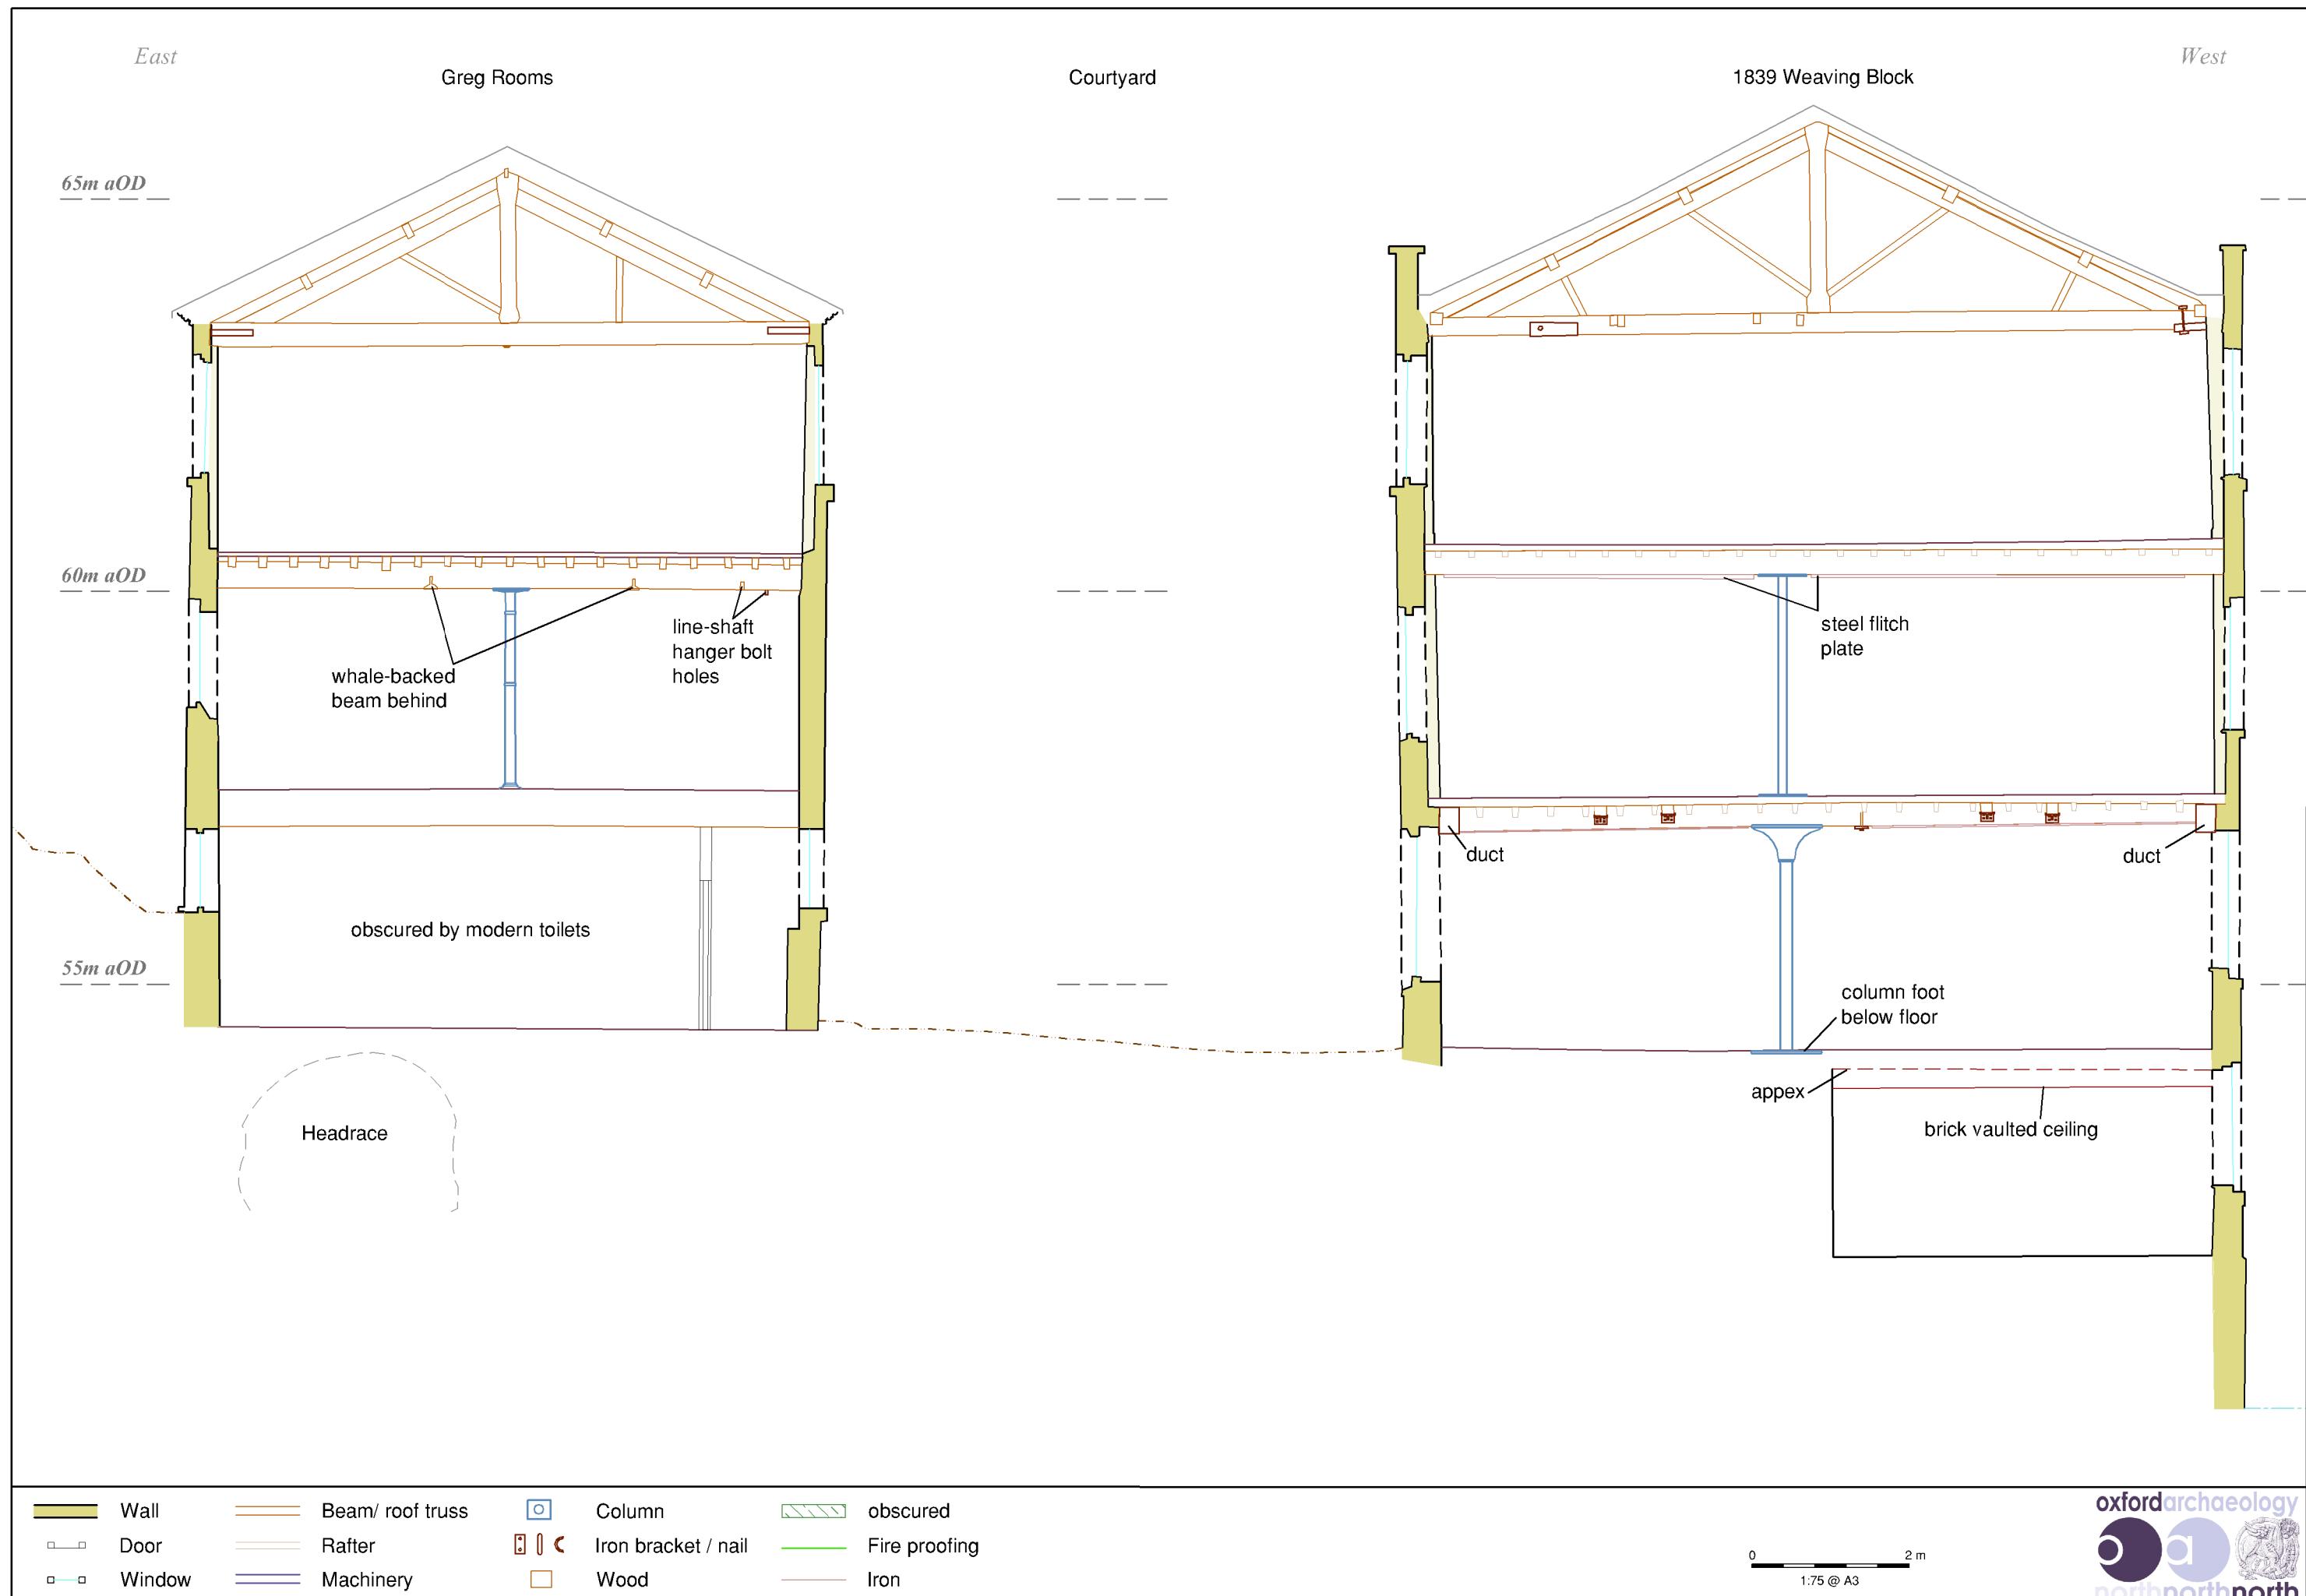


Figure 166: Cross-section 1 across 1839 weaving Block and Greg Rooms



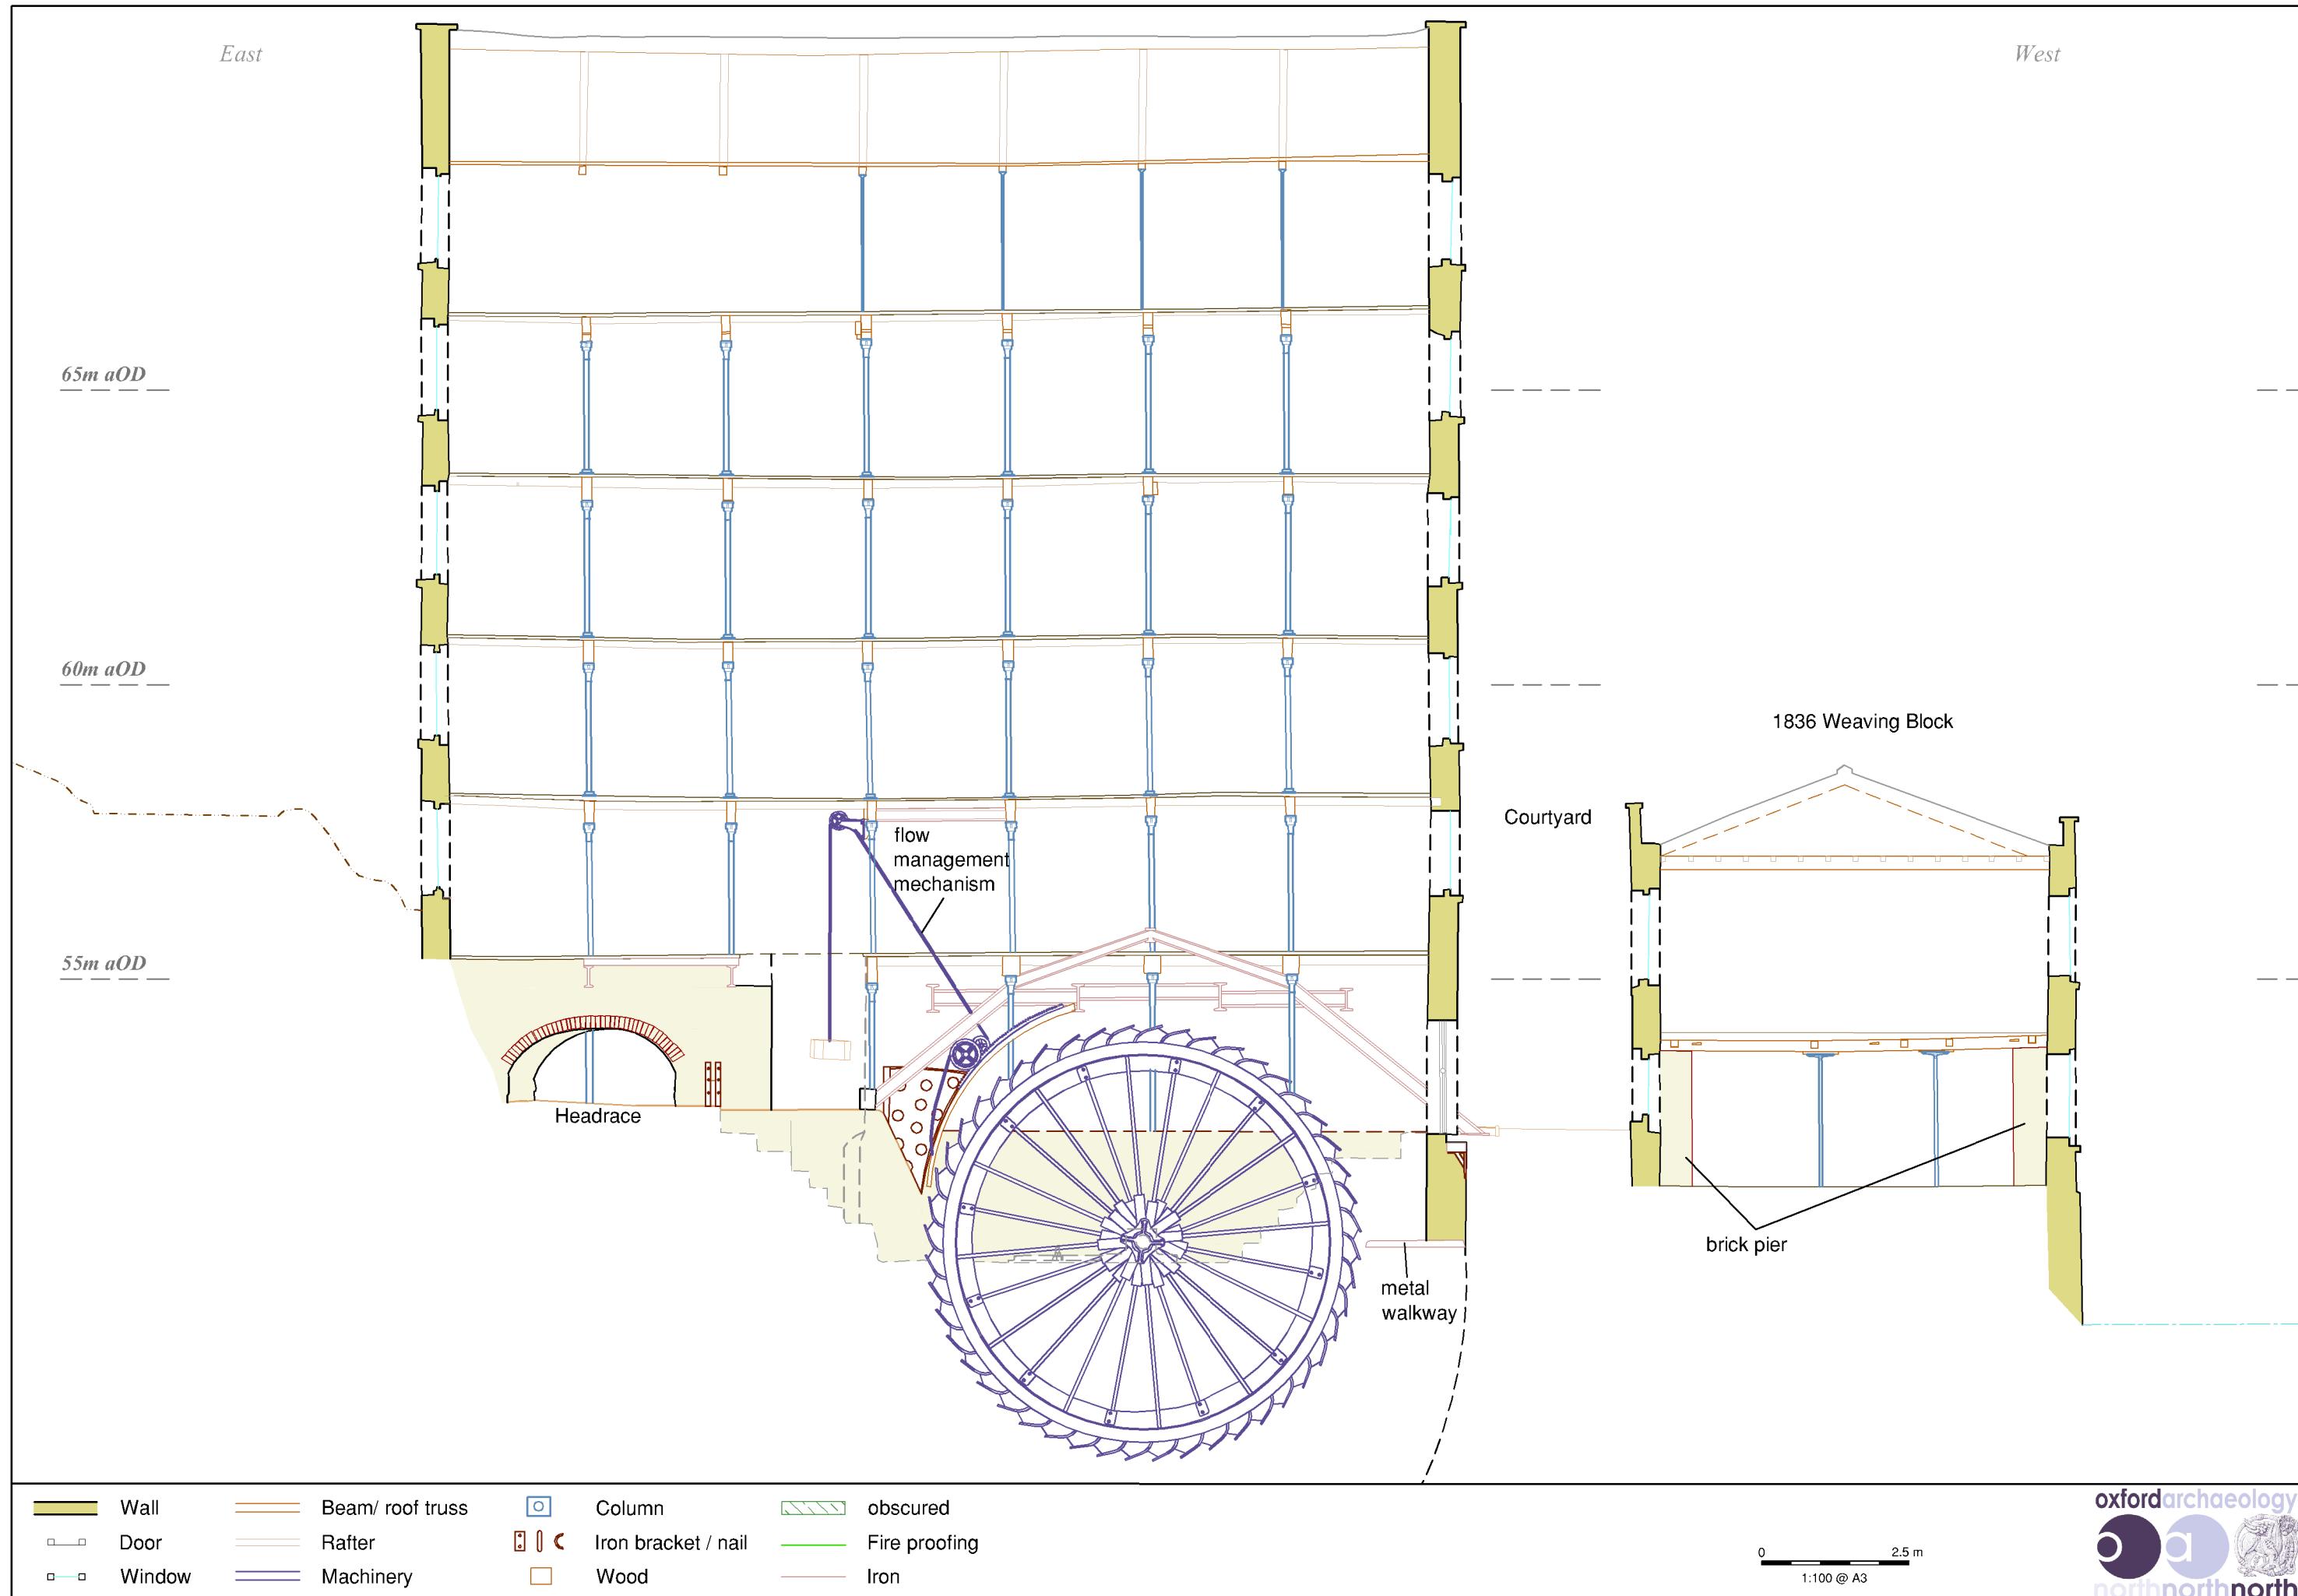


Figure 167: Cross Section 2 across New Mill and 1836 Weaving Block

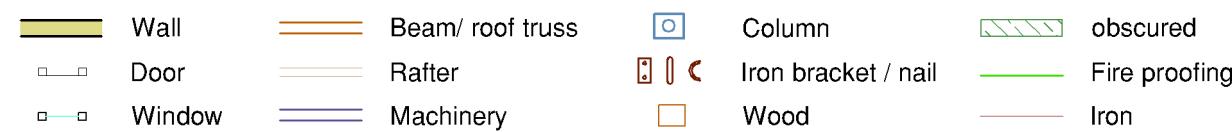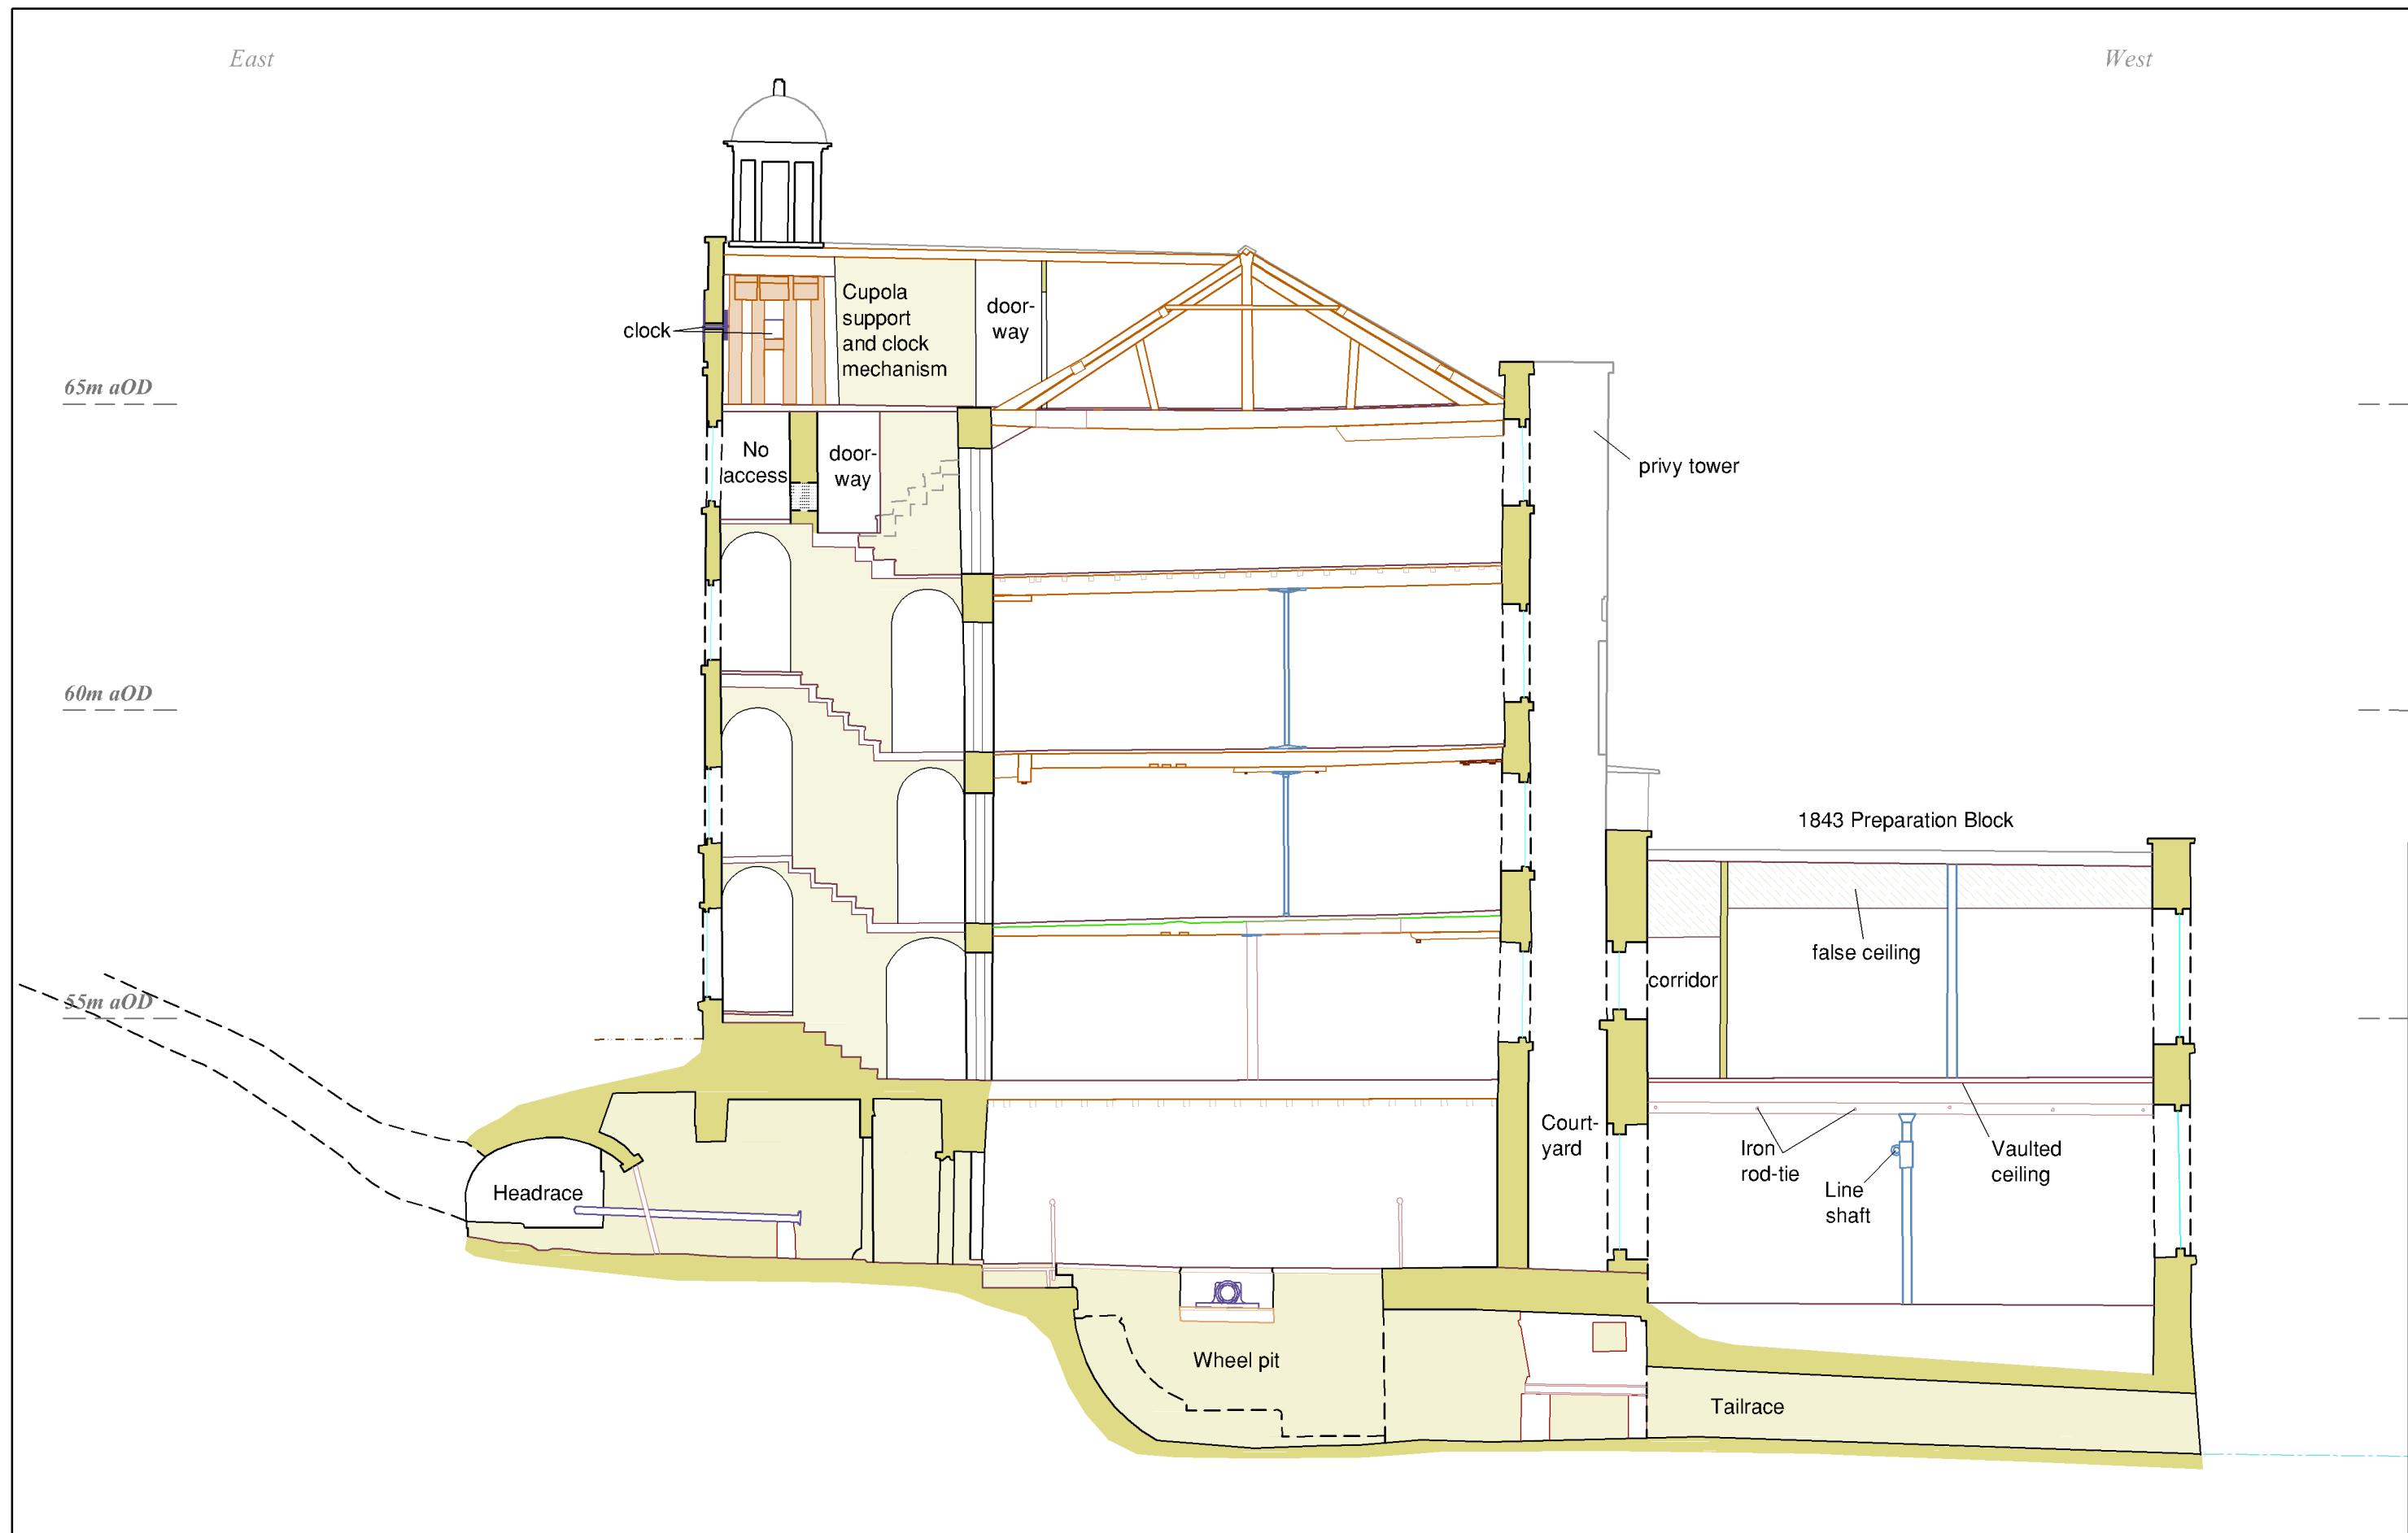


0 2.5 m
1:100 @ A3

Figure 168: Cross Section 3 across Old Mill and 1843 Preparation Block

North

South

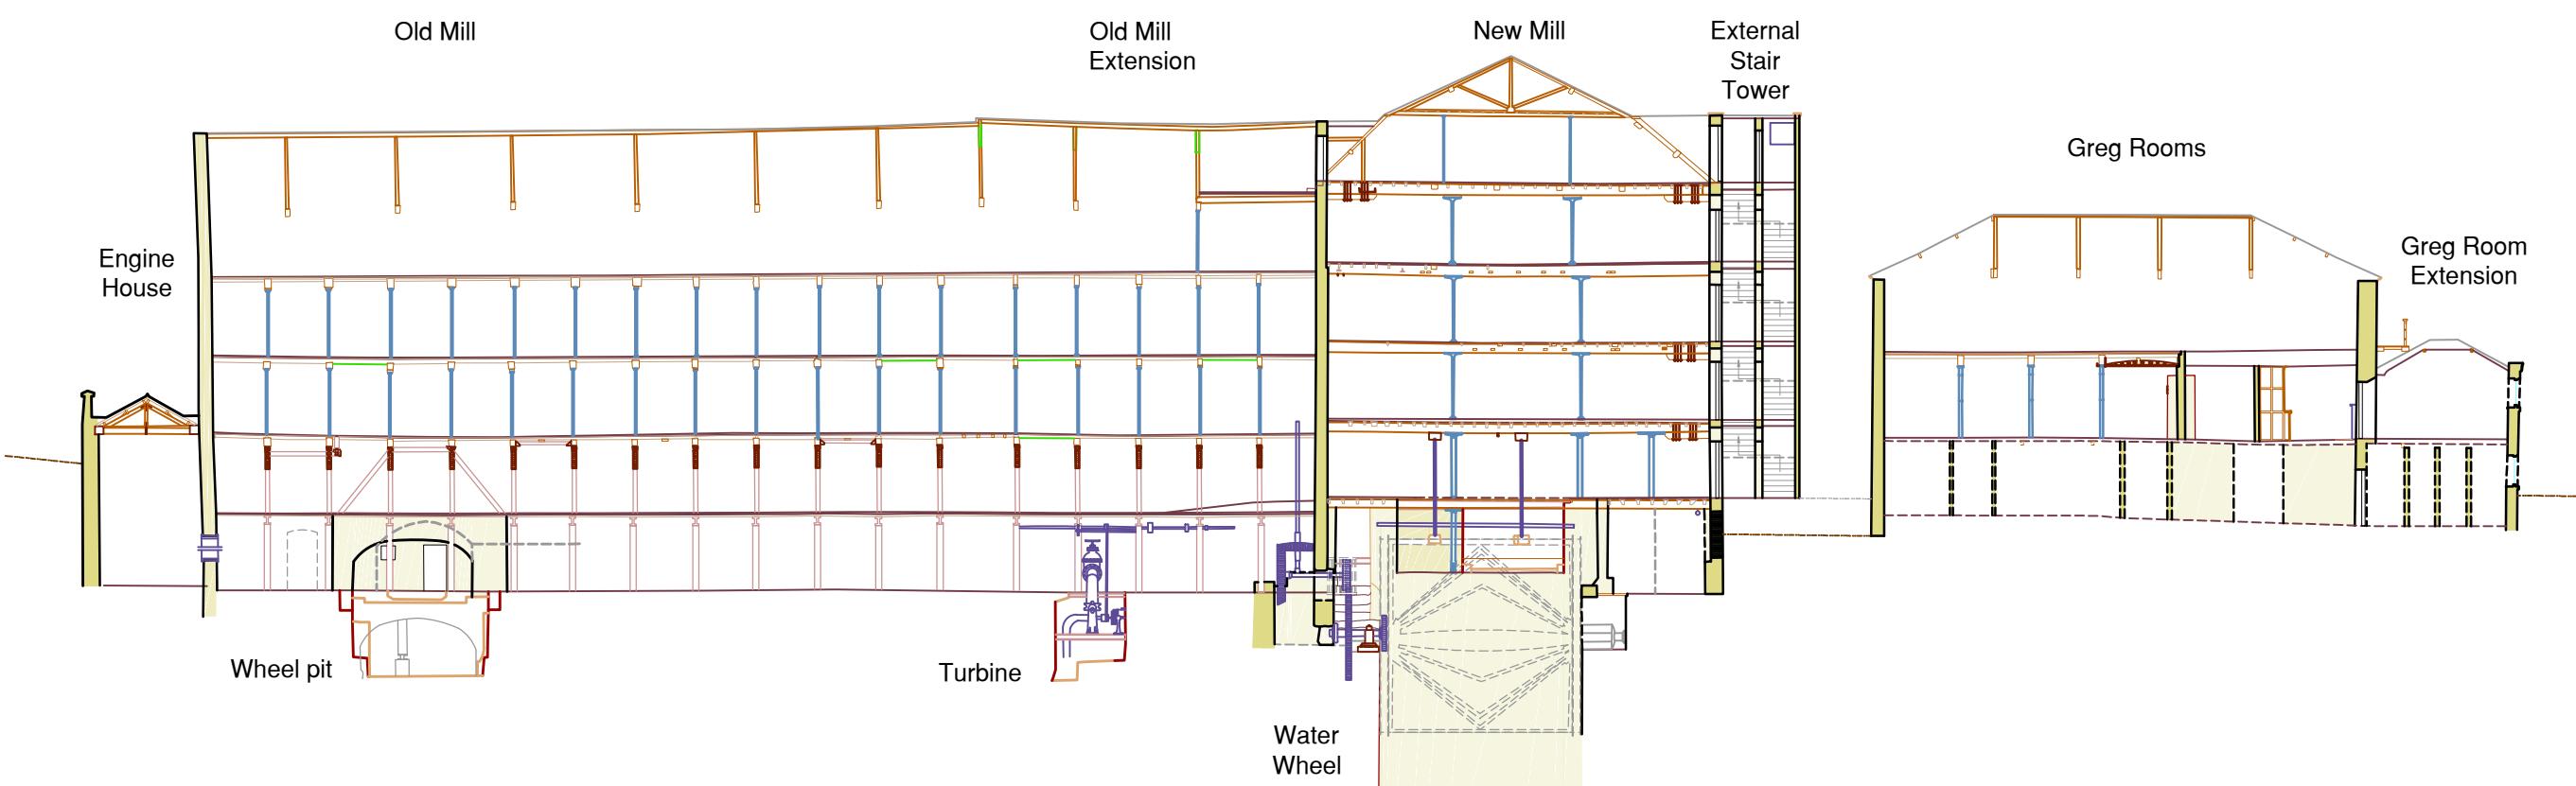

Wall	Beam/ roof truss	Column	obscured
Door	Rafter	Iron bracket / nail	Fire proofing
Window	Machinery	Wood	Iron

0 5 m
1:250 @ A3

Figure 169: Cross Section 4 through Old Mill, New Mill and Greg Rooms

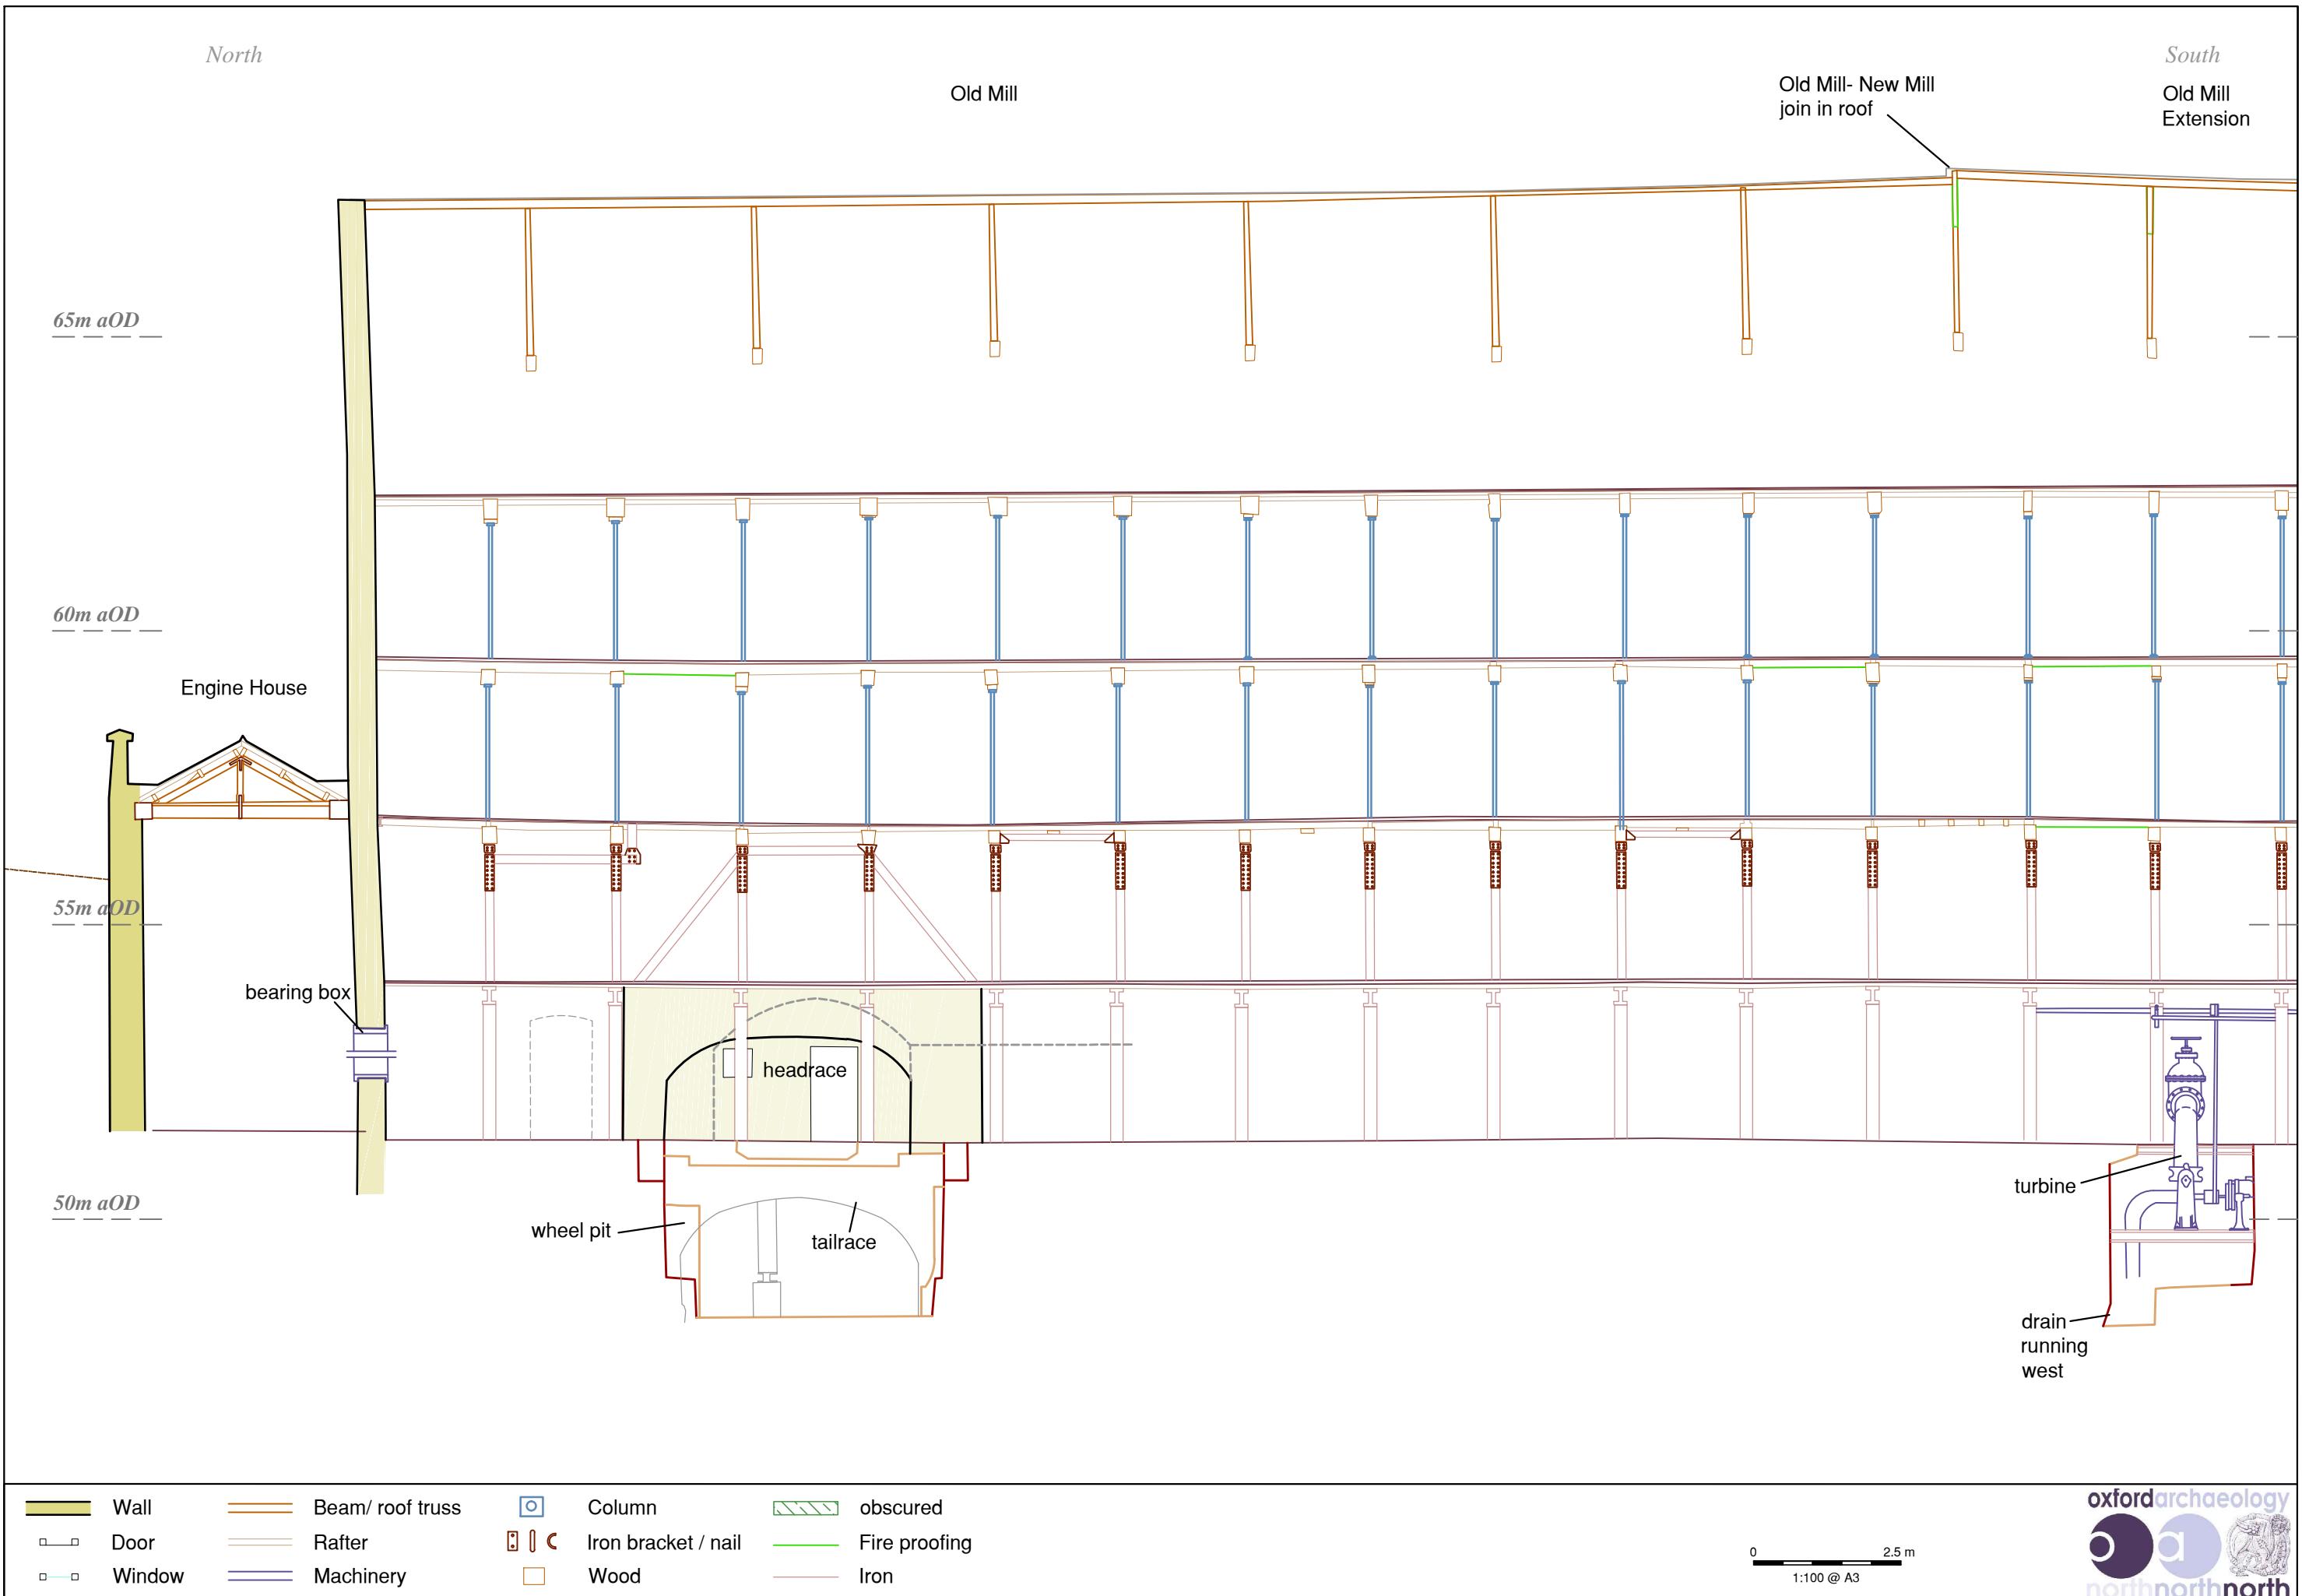


Figure 170: Cross Section 4 detail through Old Mill

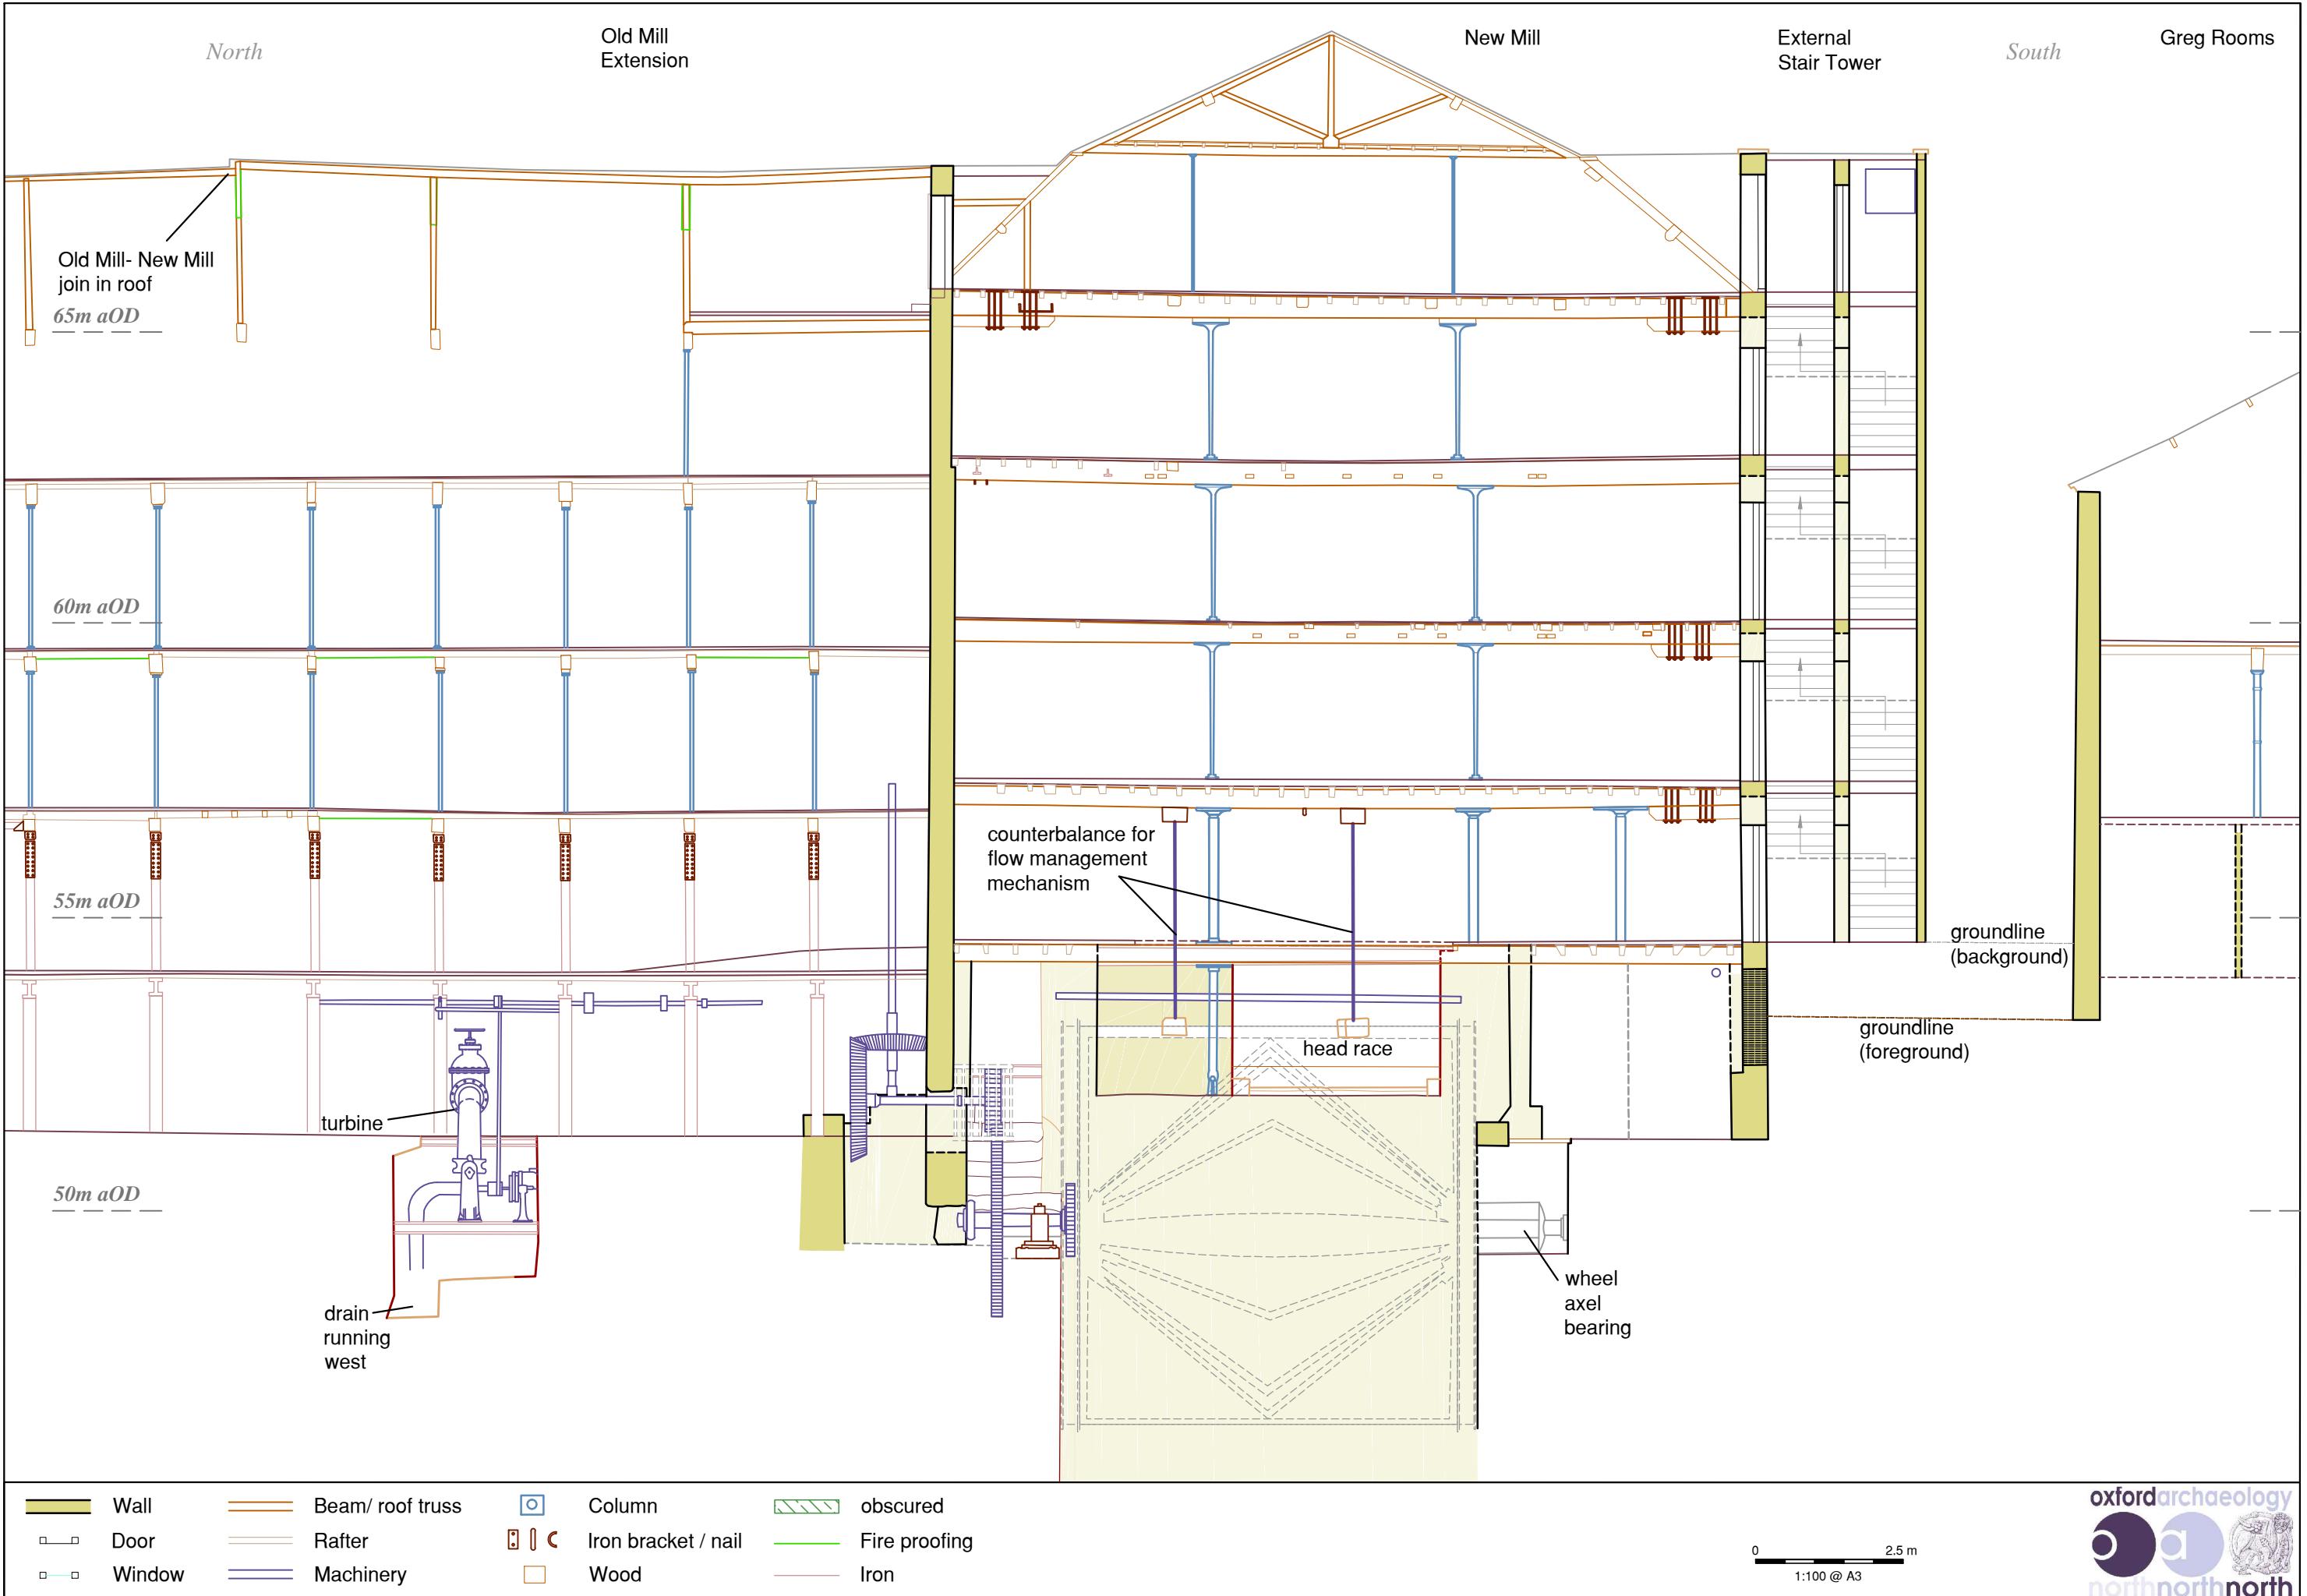
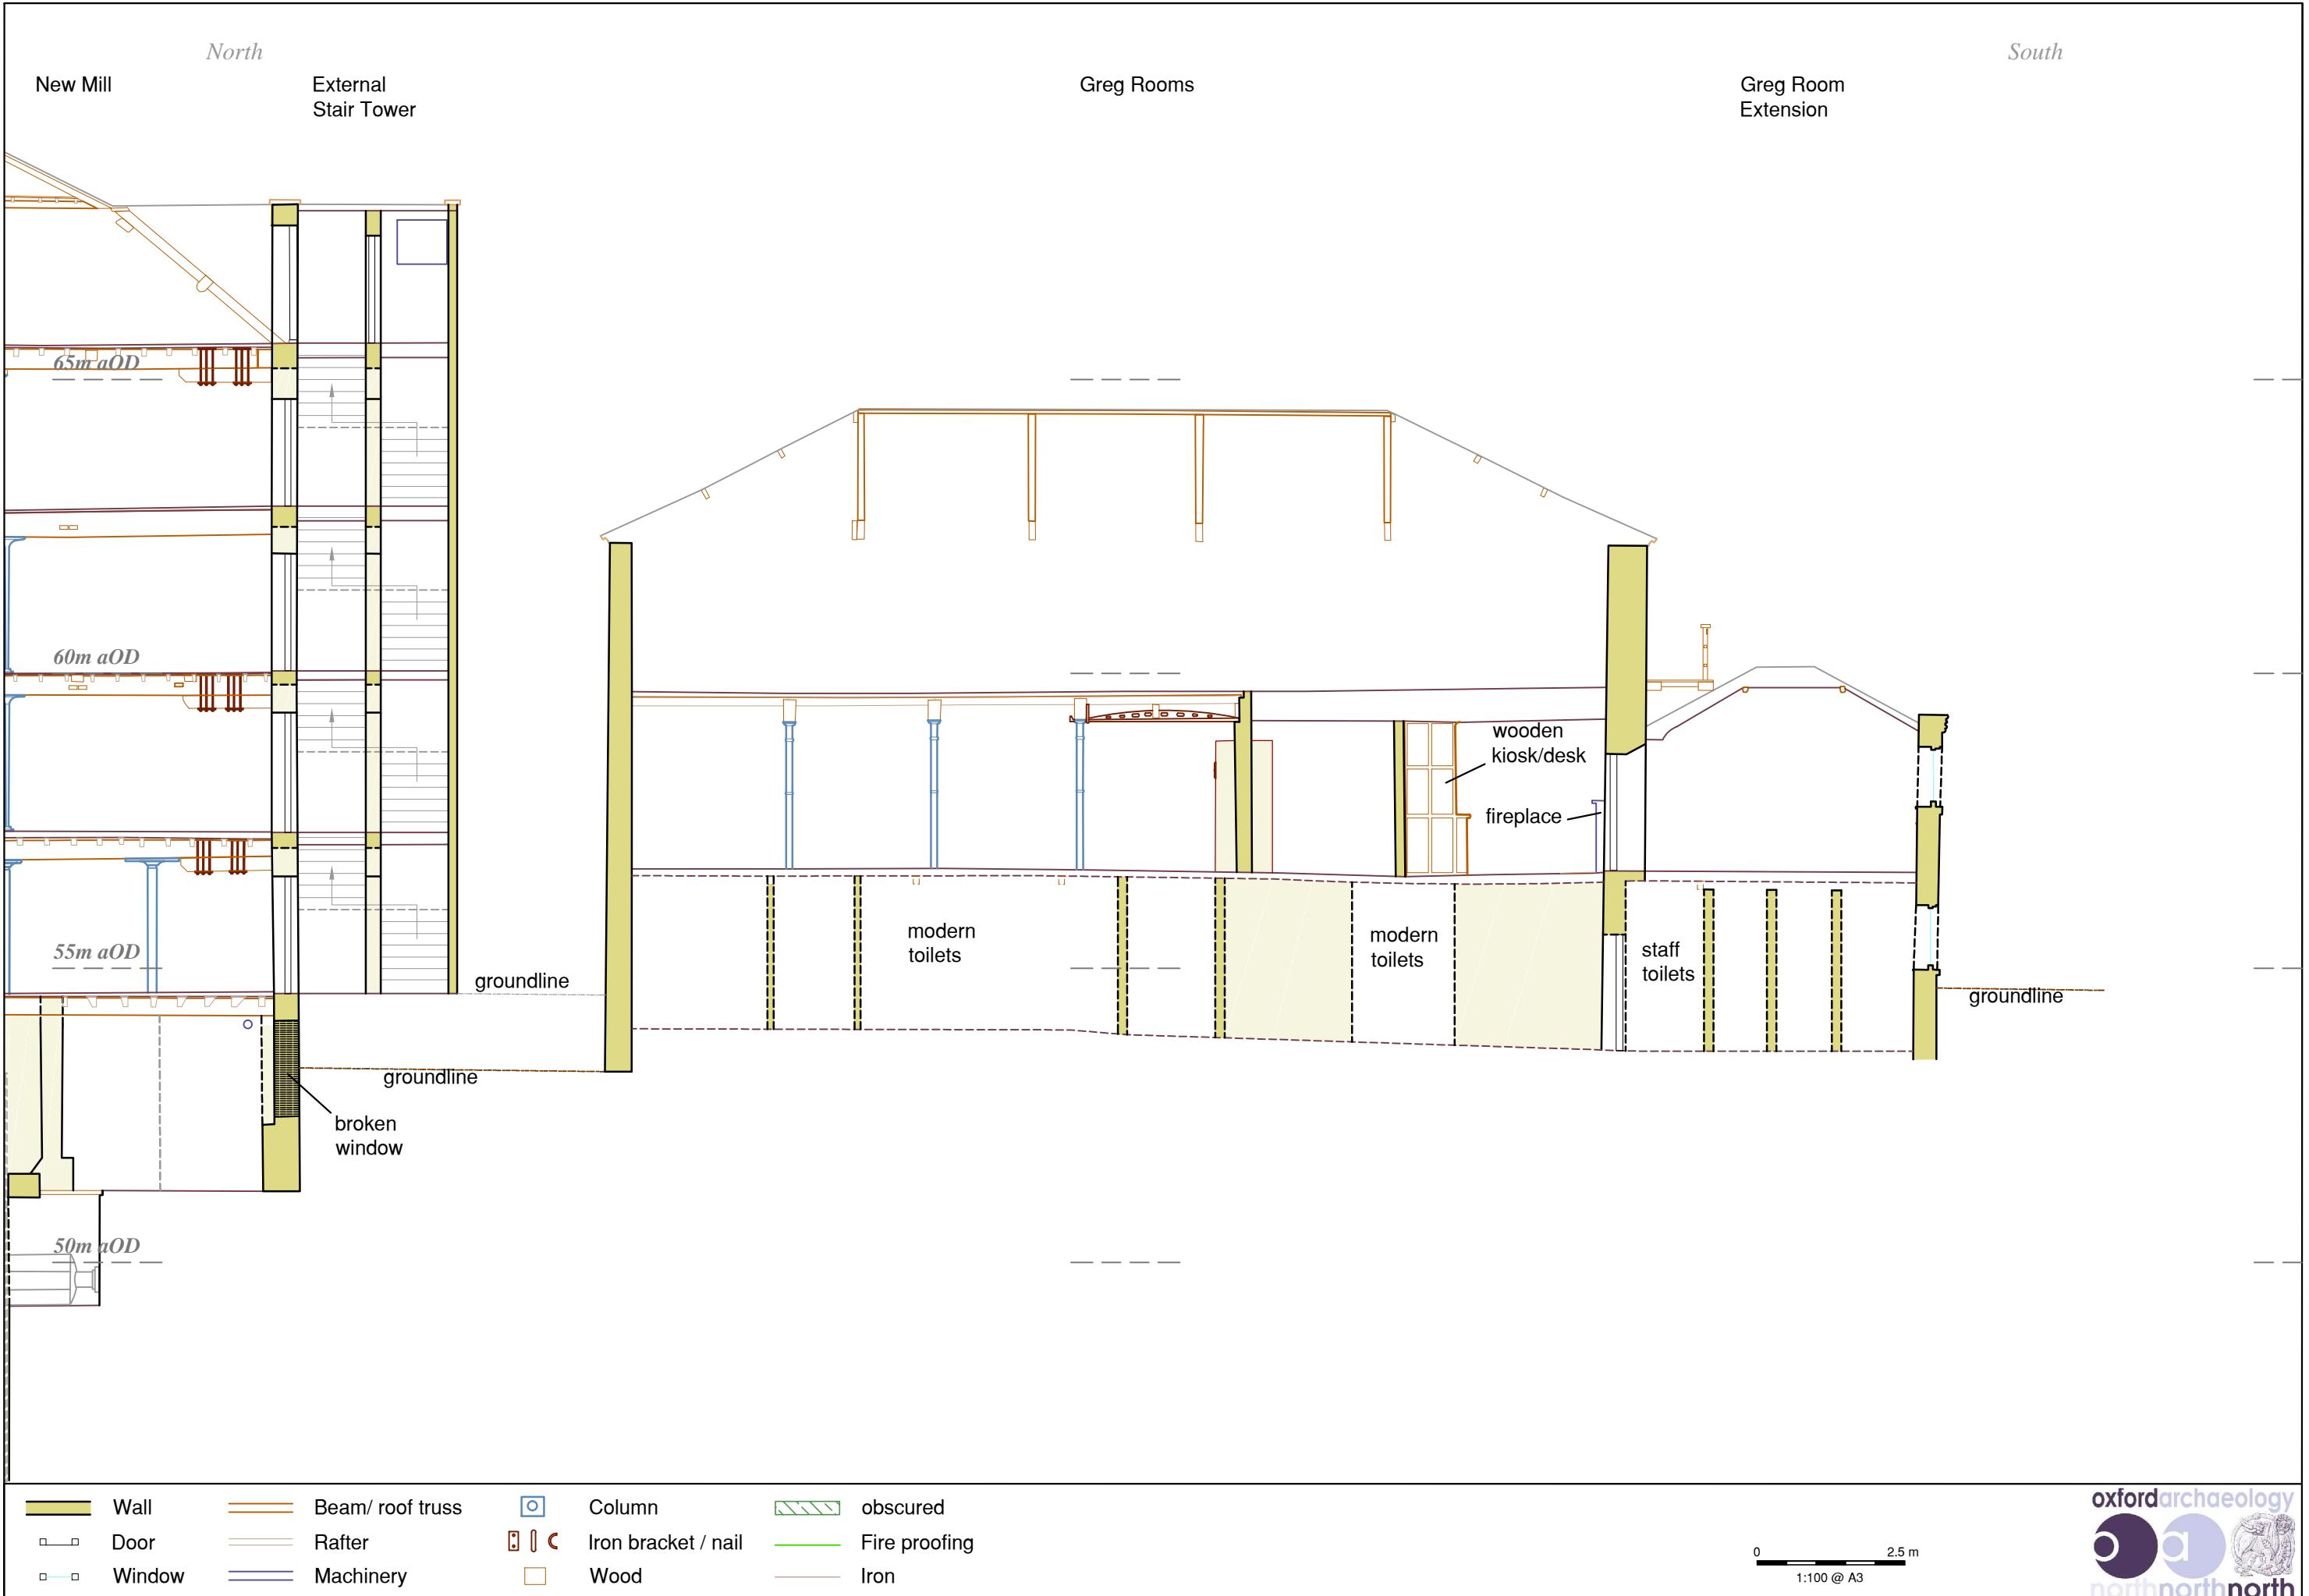


Figure 171: Cross-section 4 detail through New Mill



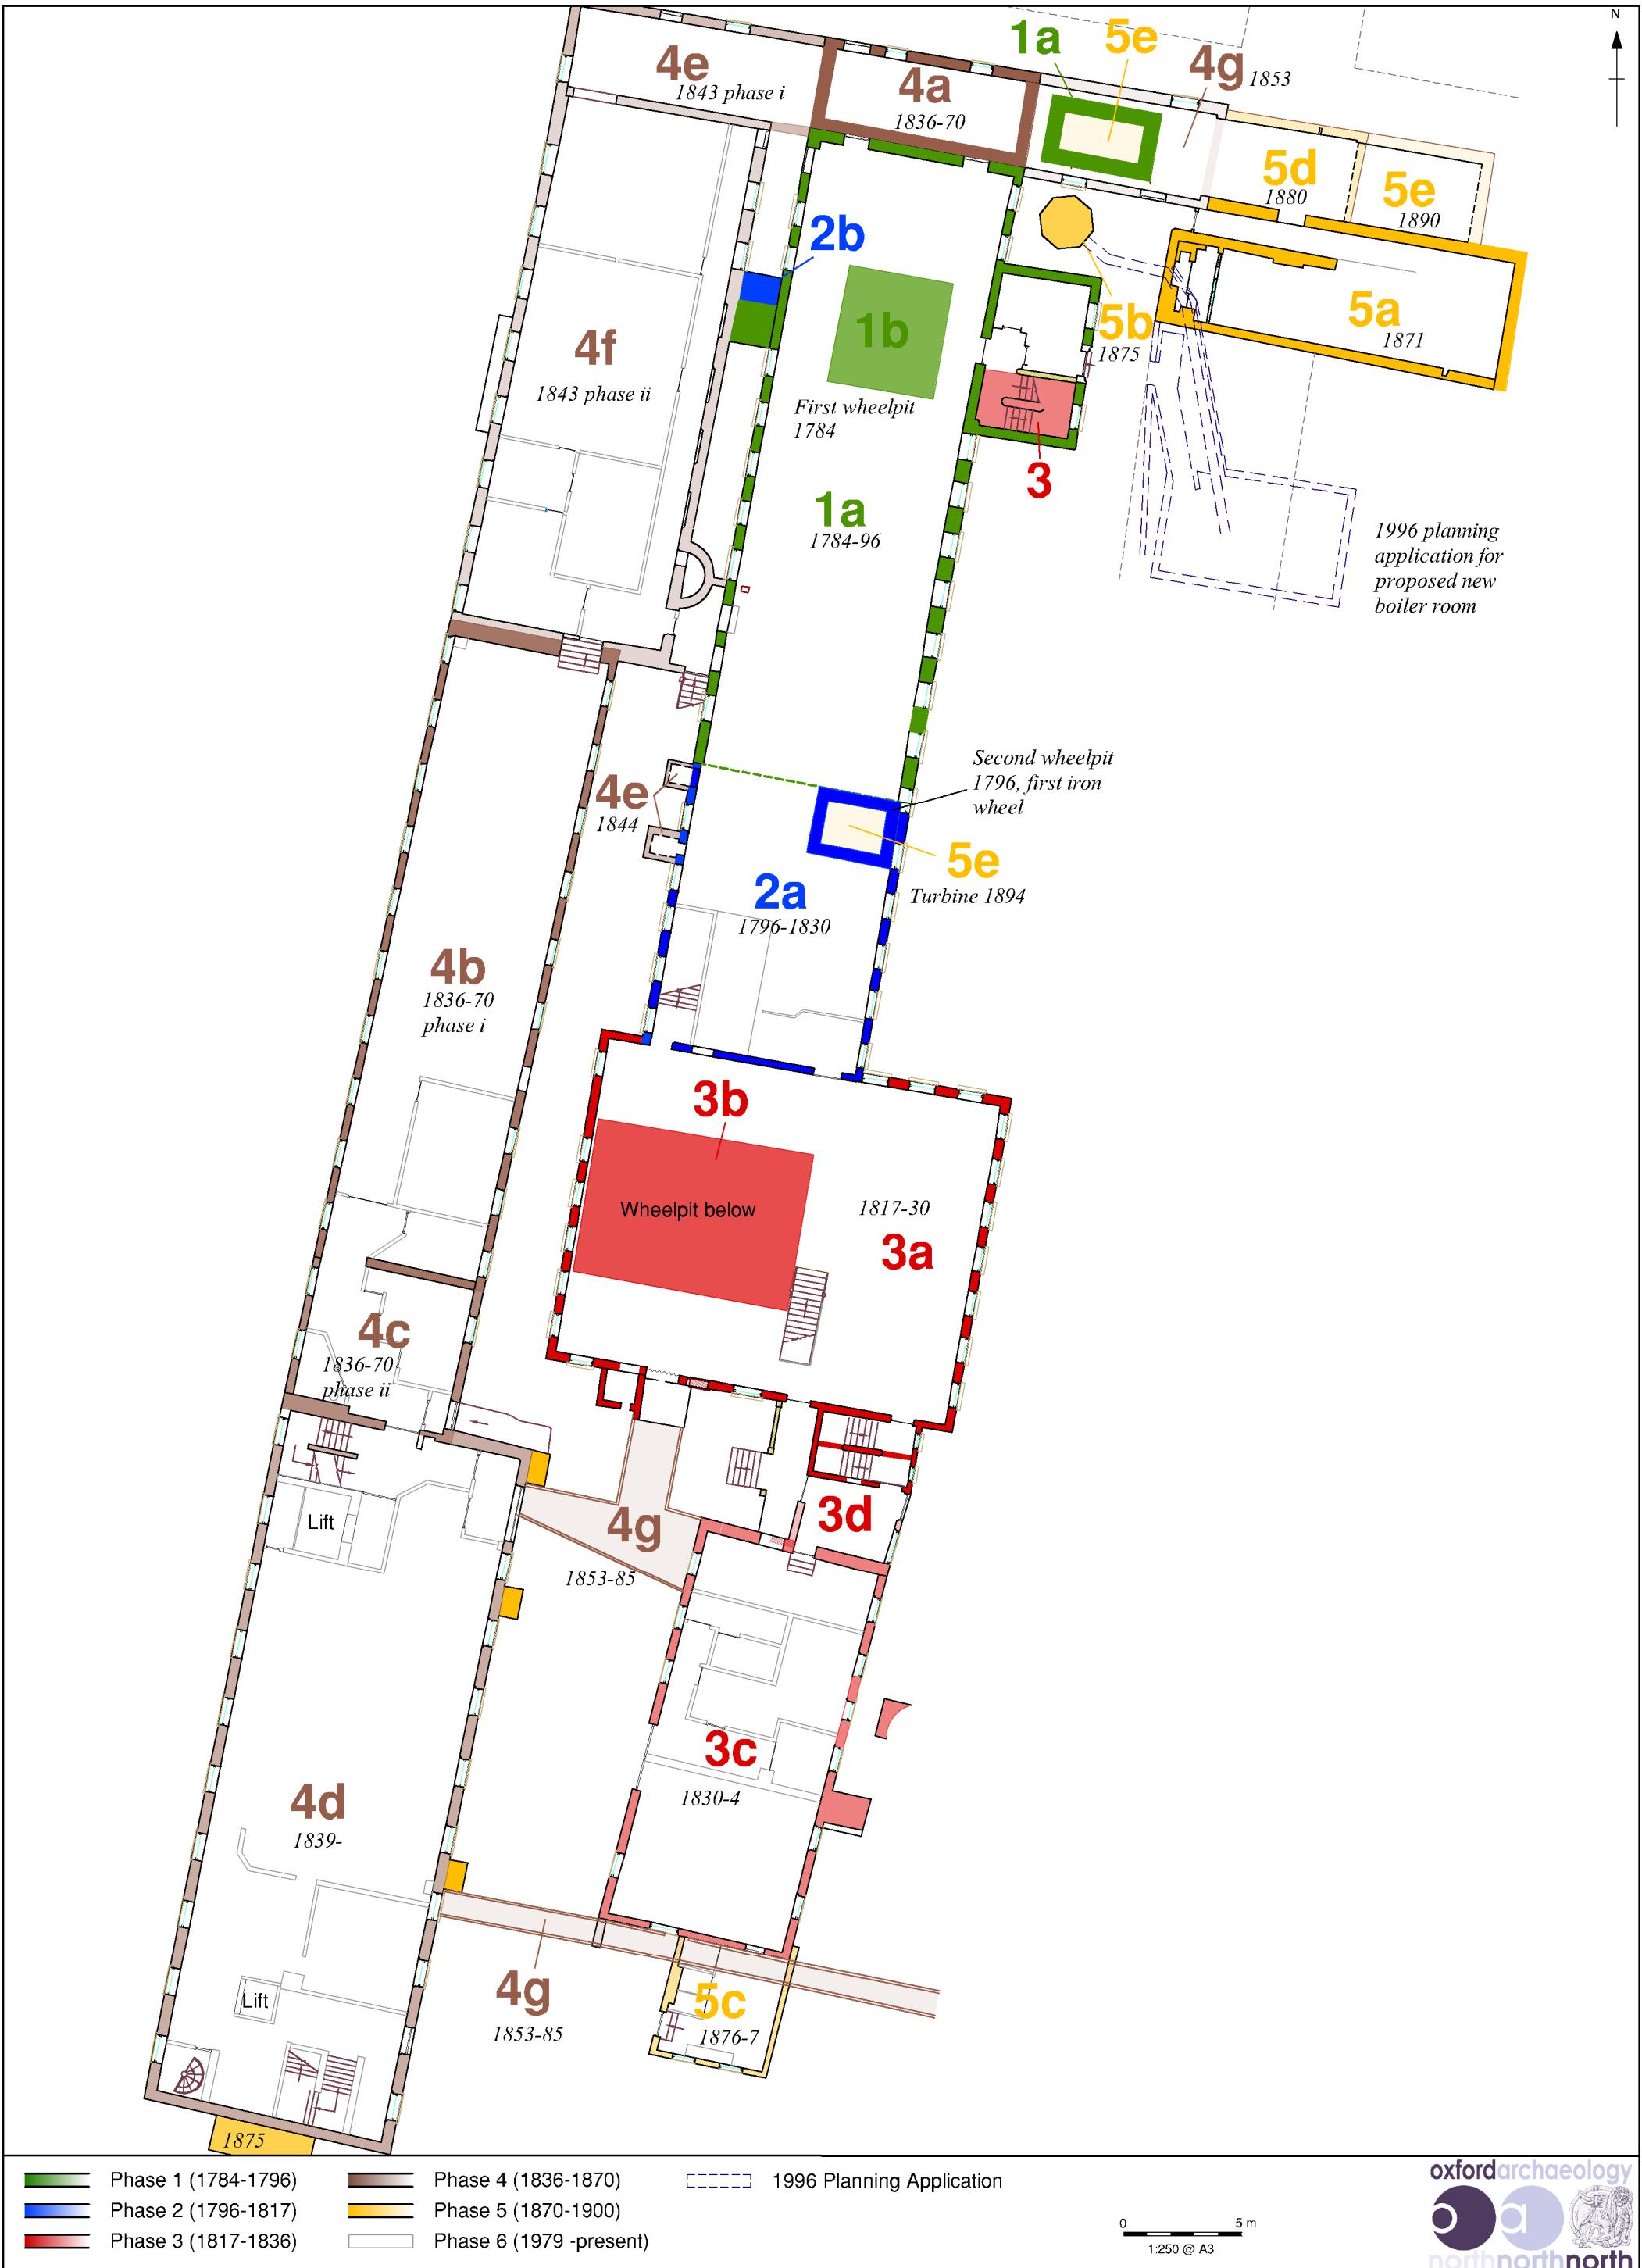


Figure 173: Quarry Bank Mill Phase plan

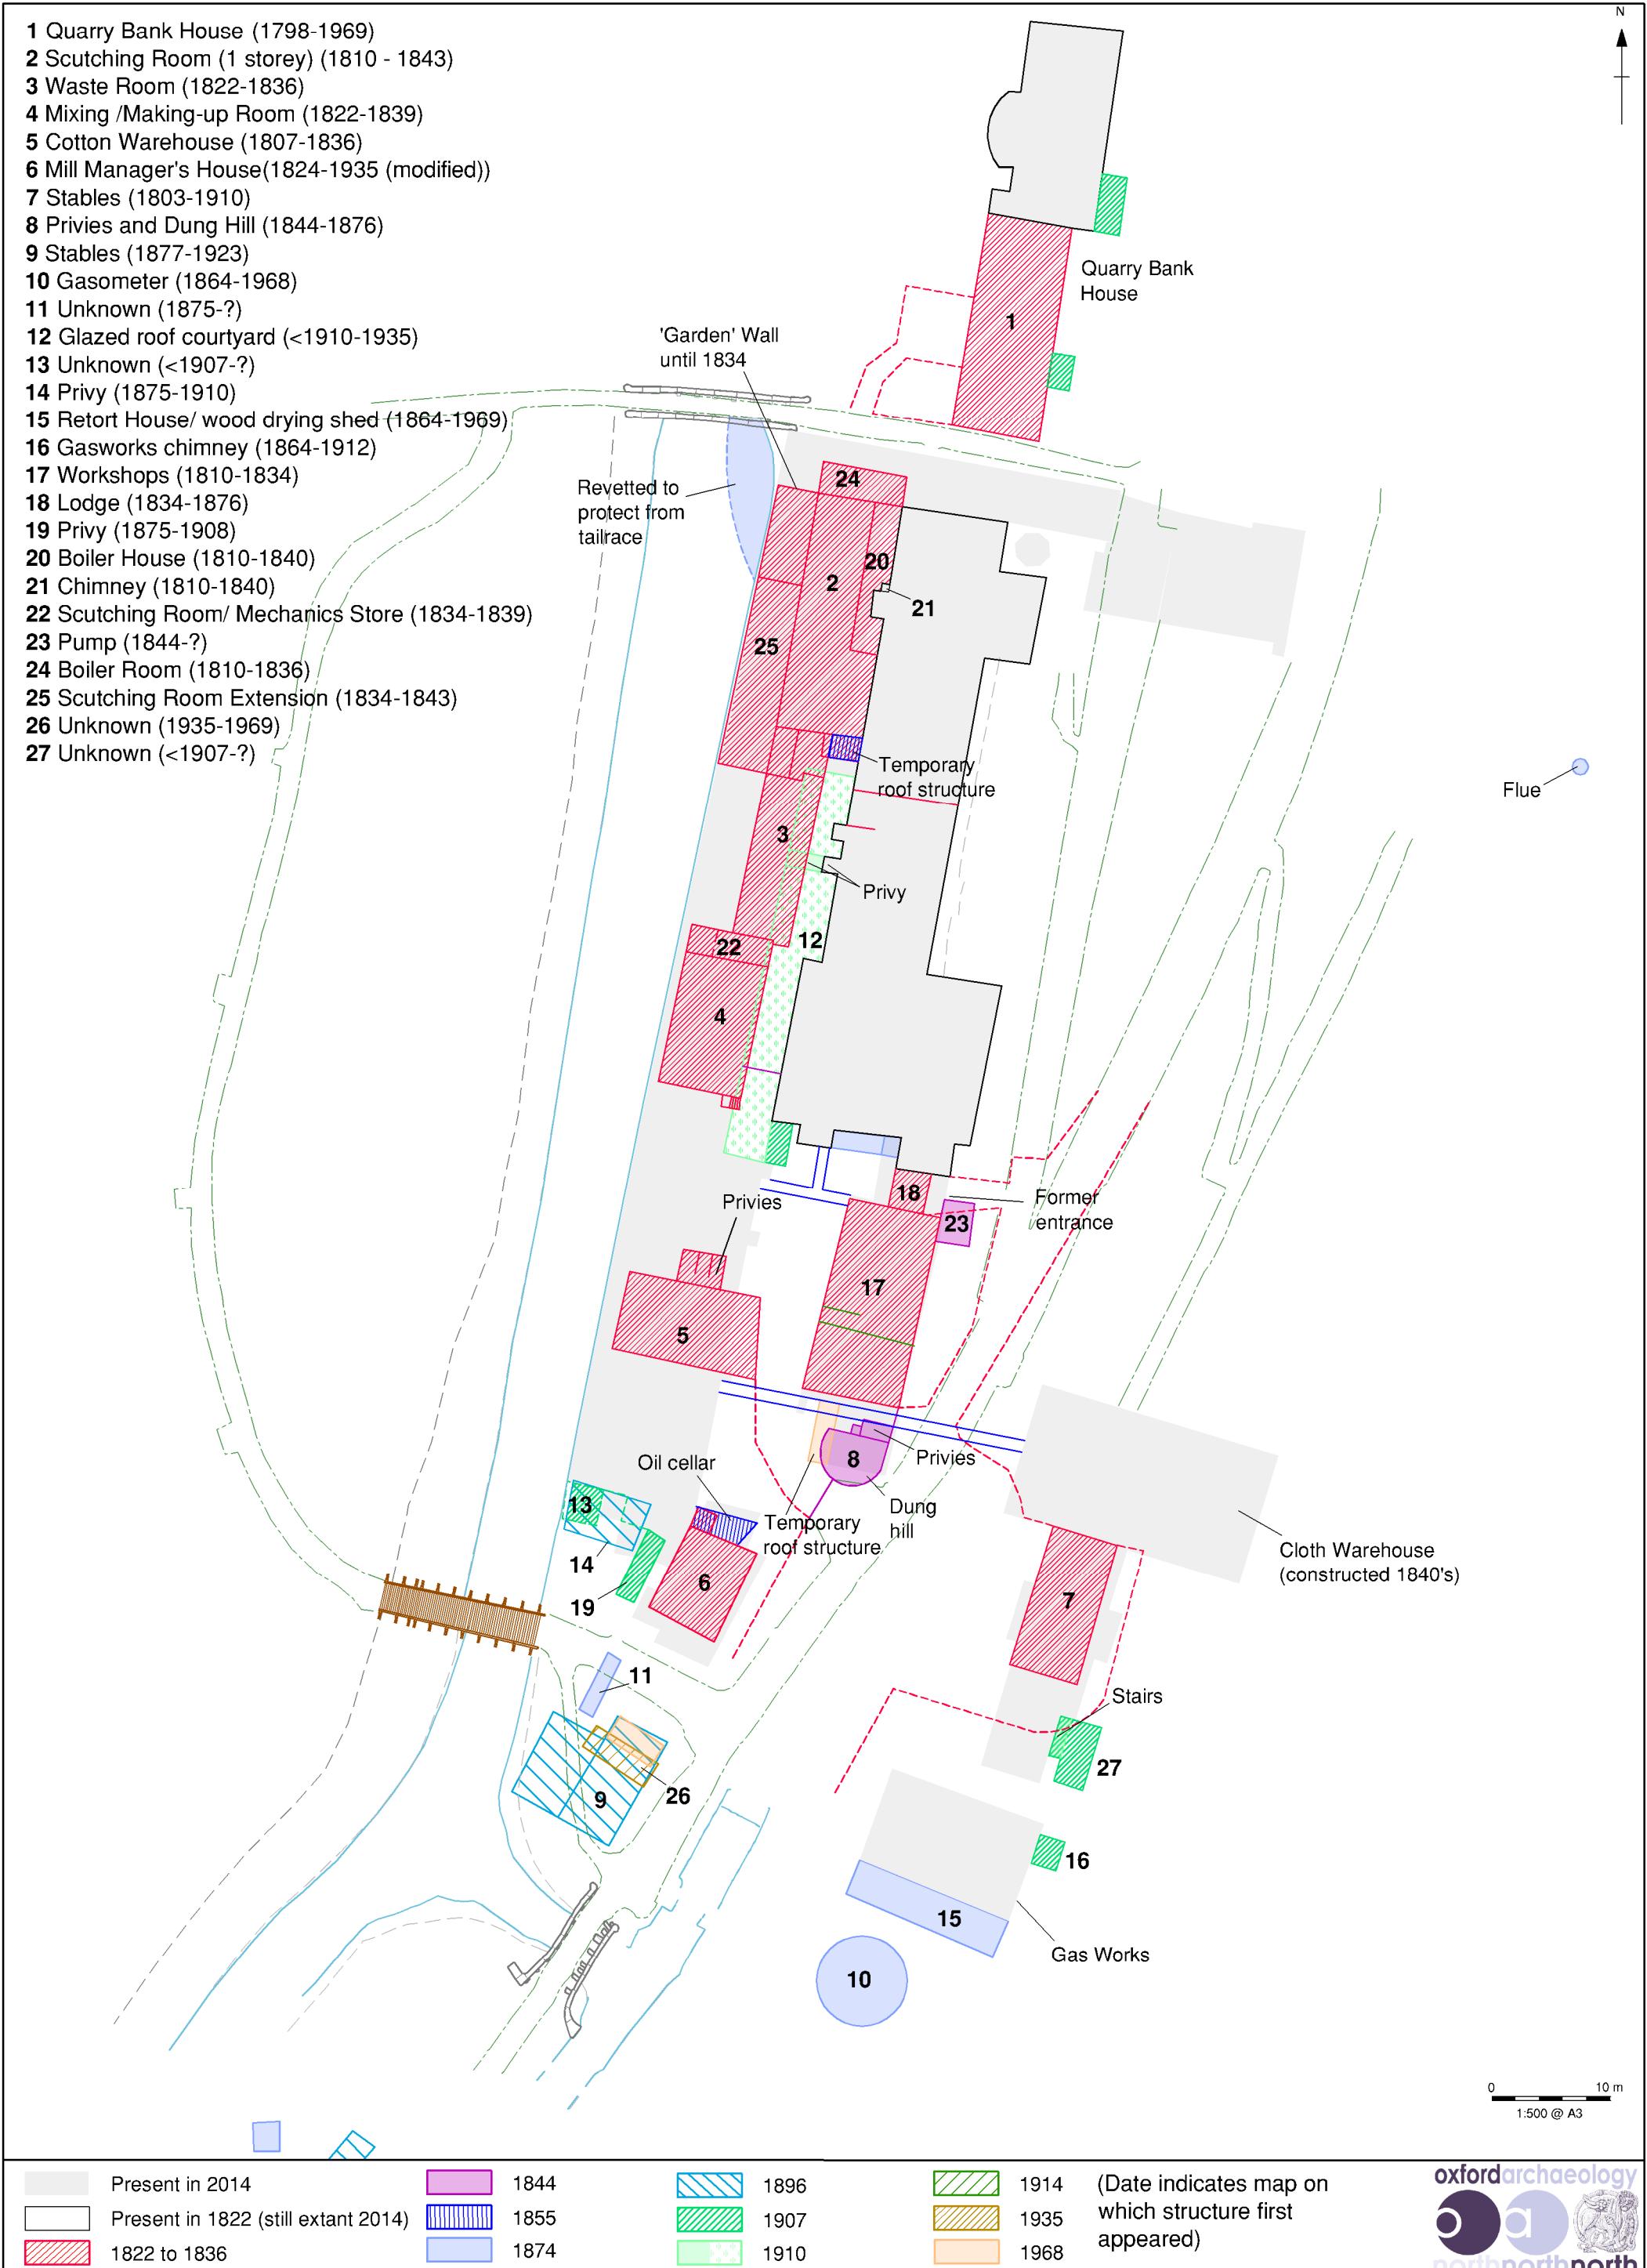


Figure 174: The Quarry Bank Mills Buildings that have been lost or replaced

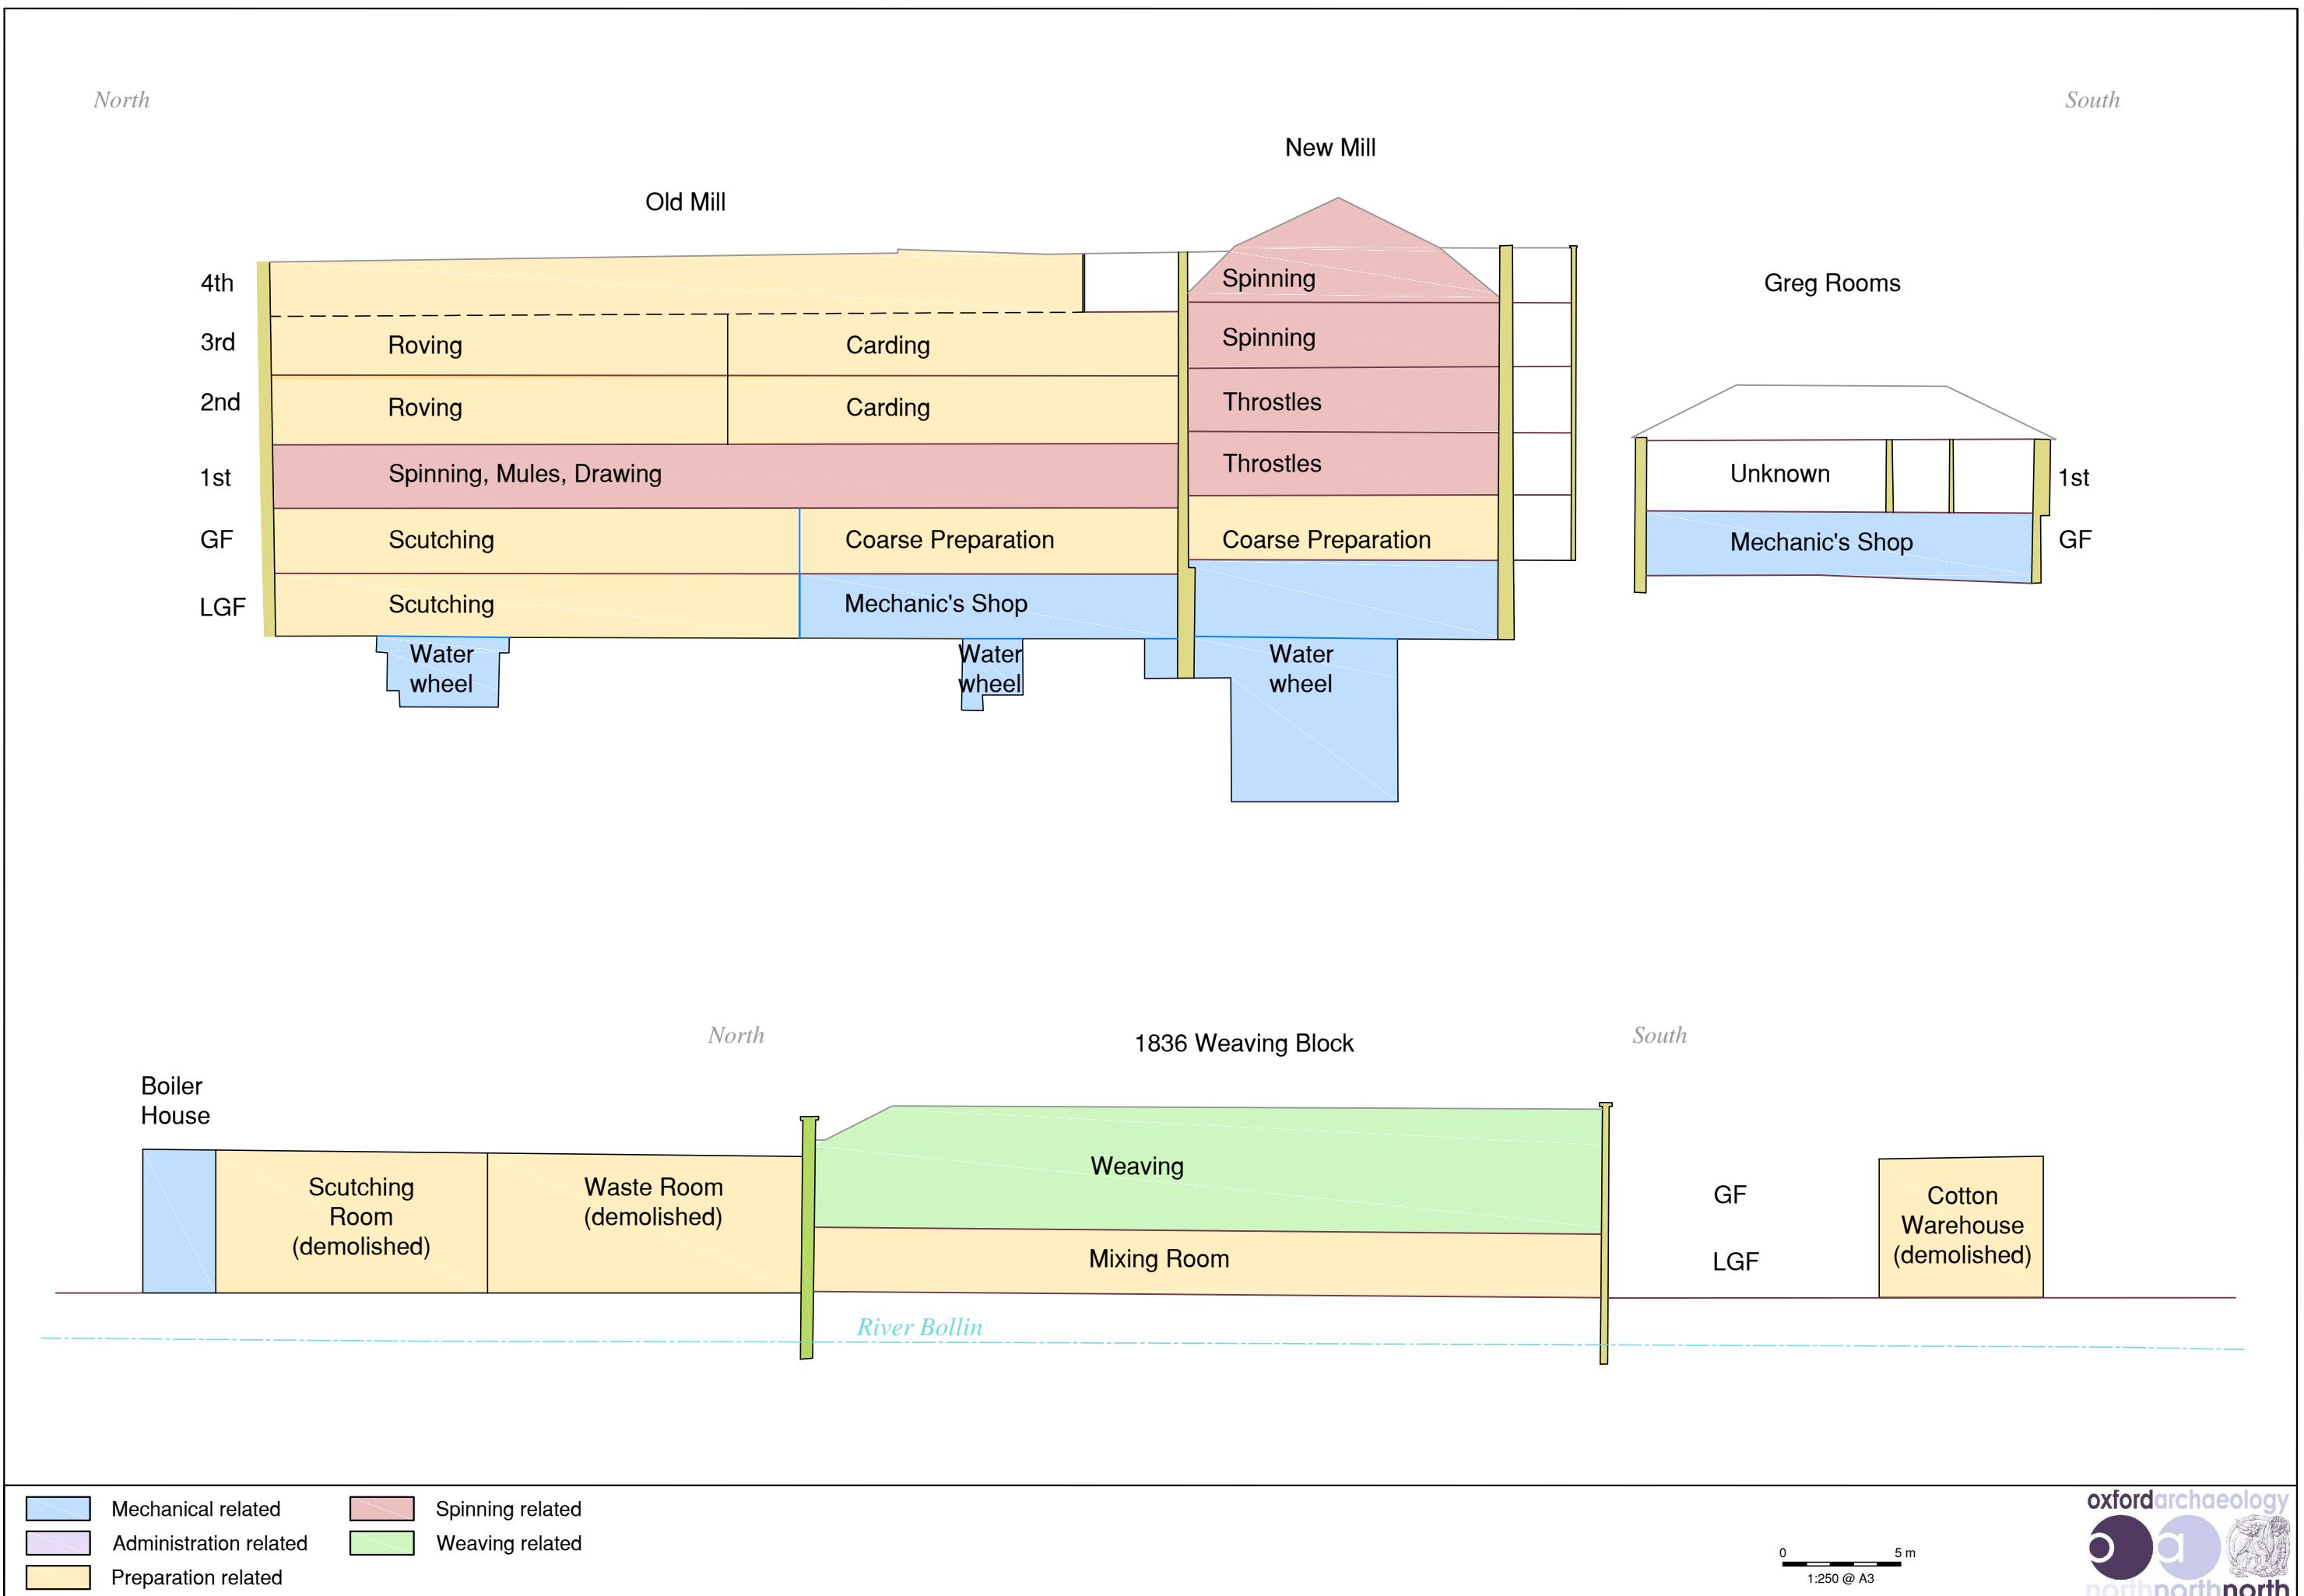


Figure 175: Room usage on cross sections through Quarry Bank Mill in 1836

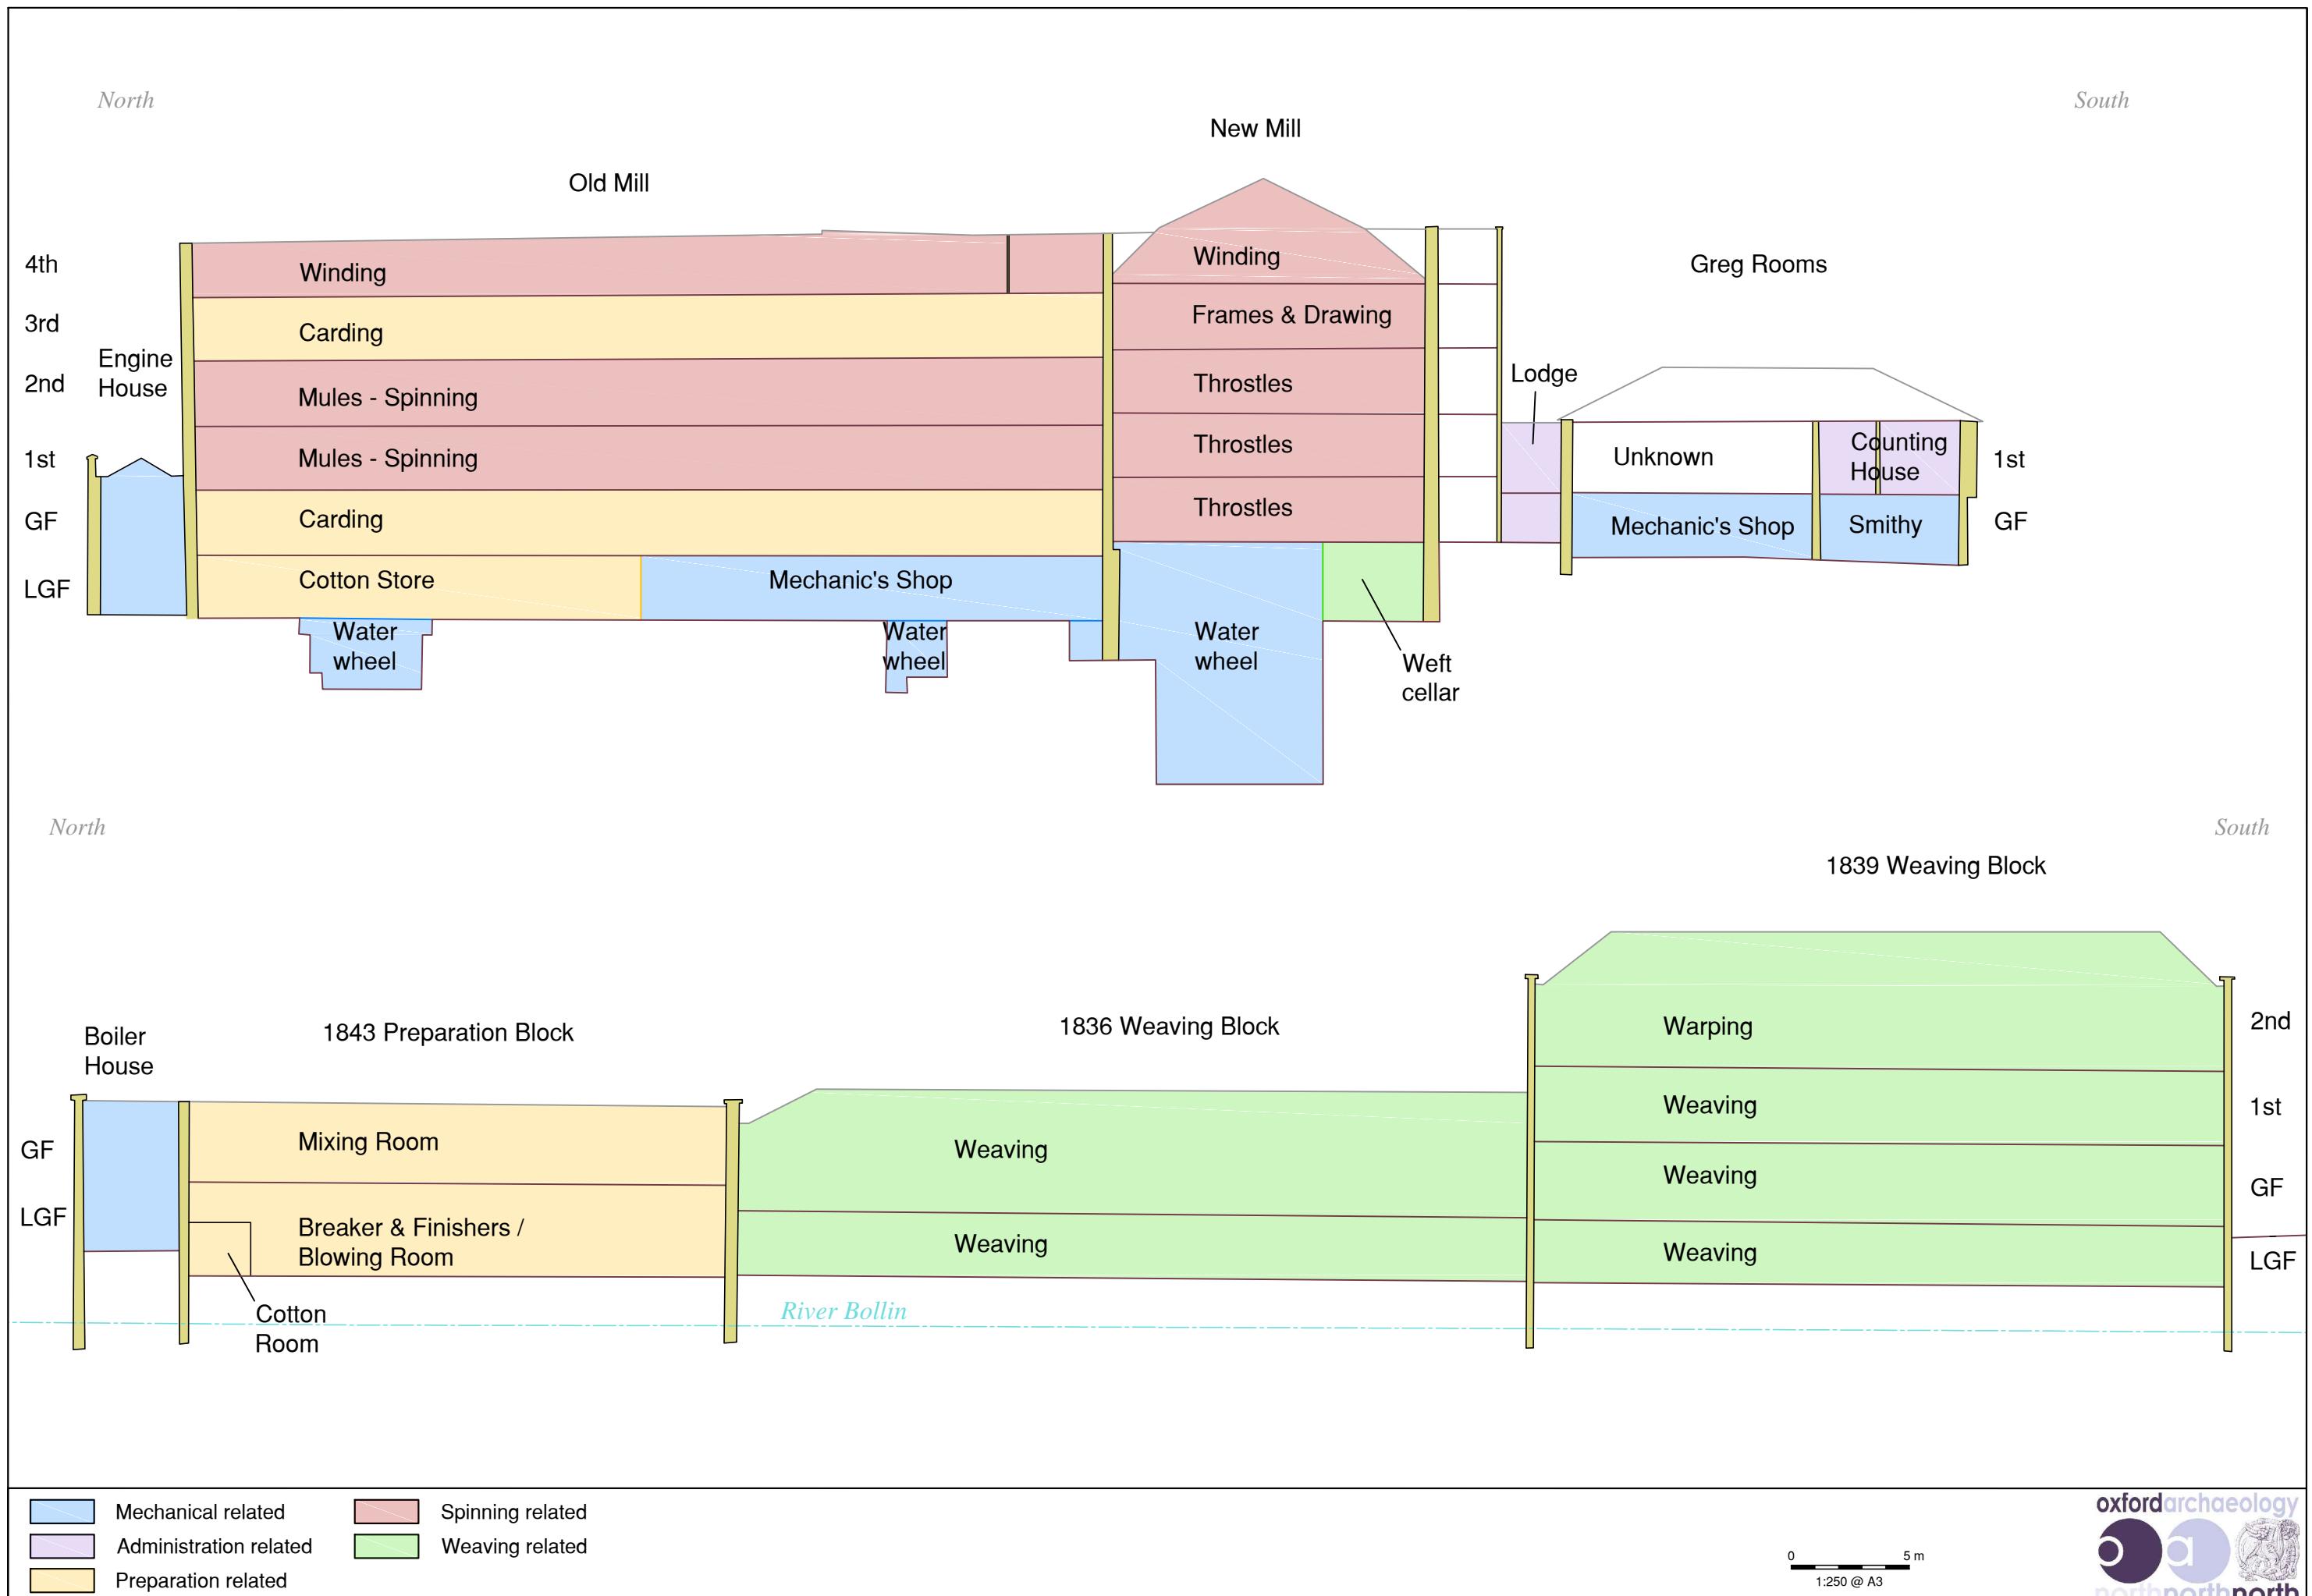


Figure 176: Room usage on cross sections through Quarry Bank Mill in 1844

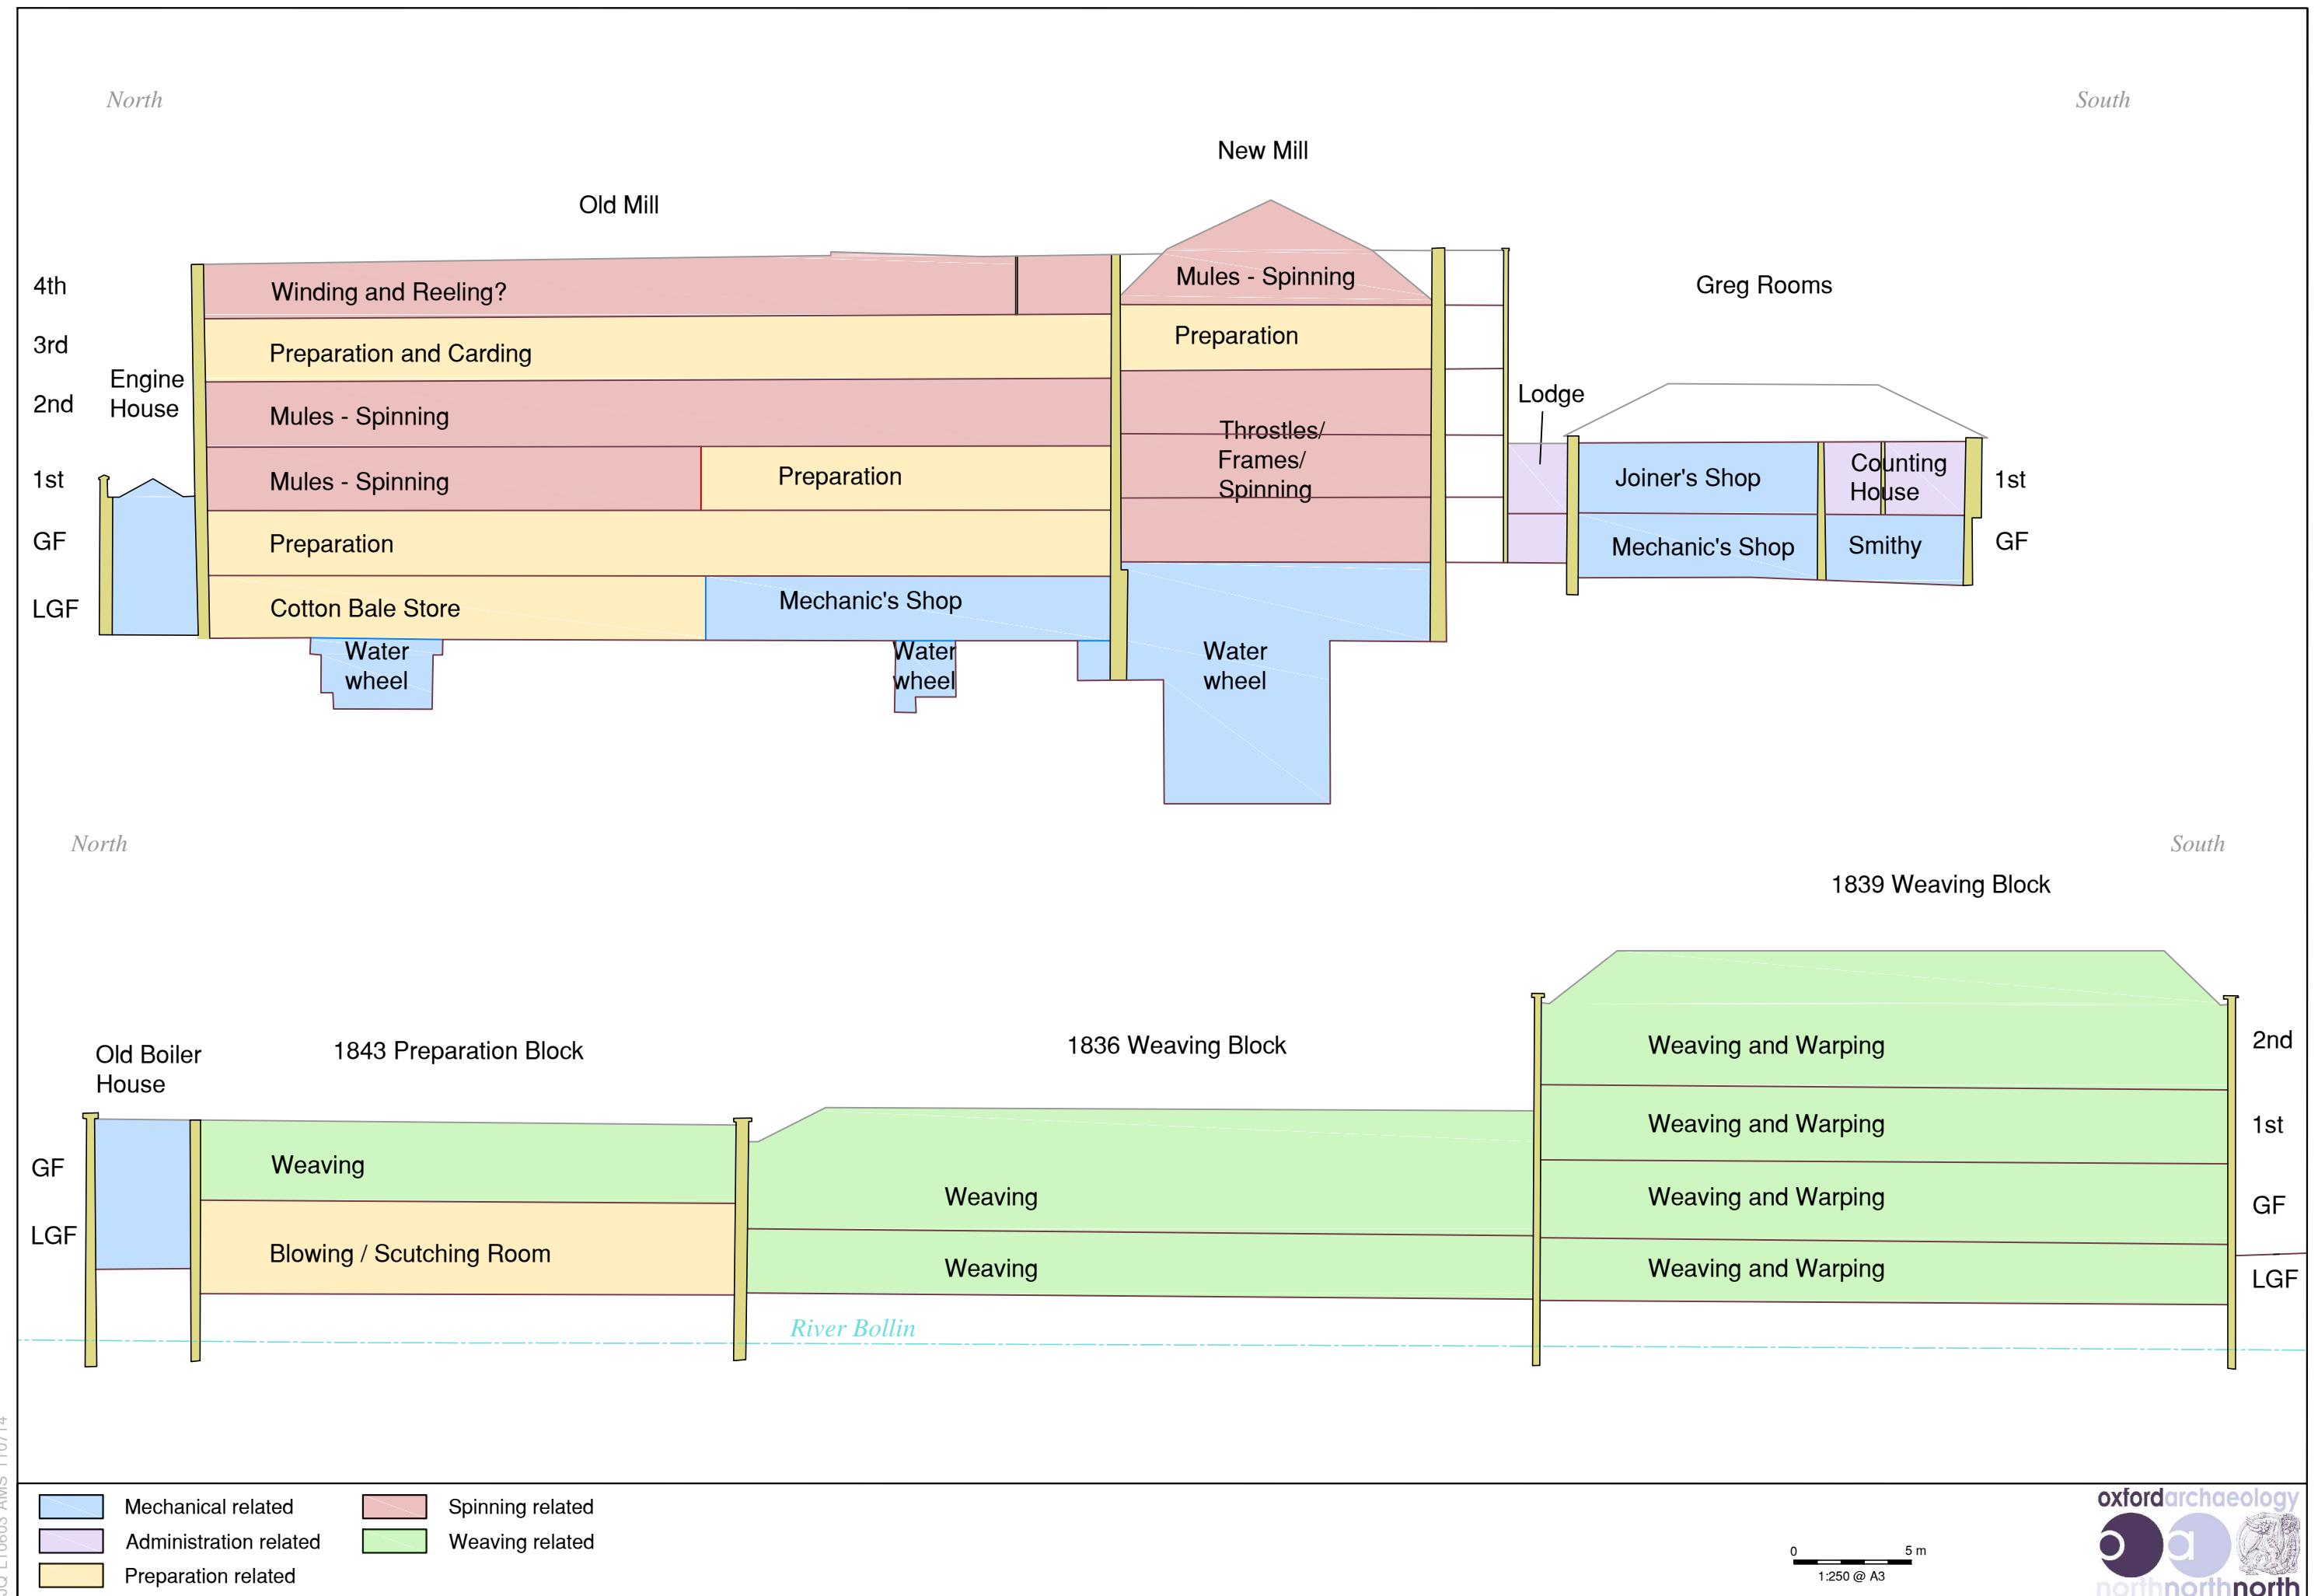


Figure 177: Room usage on cross sections through Quarry Bank Mill in 1855

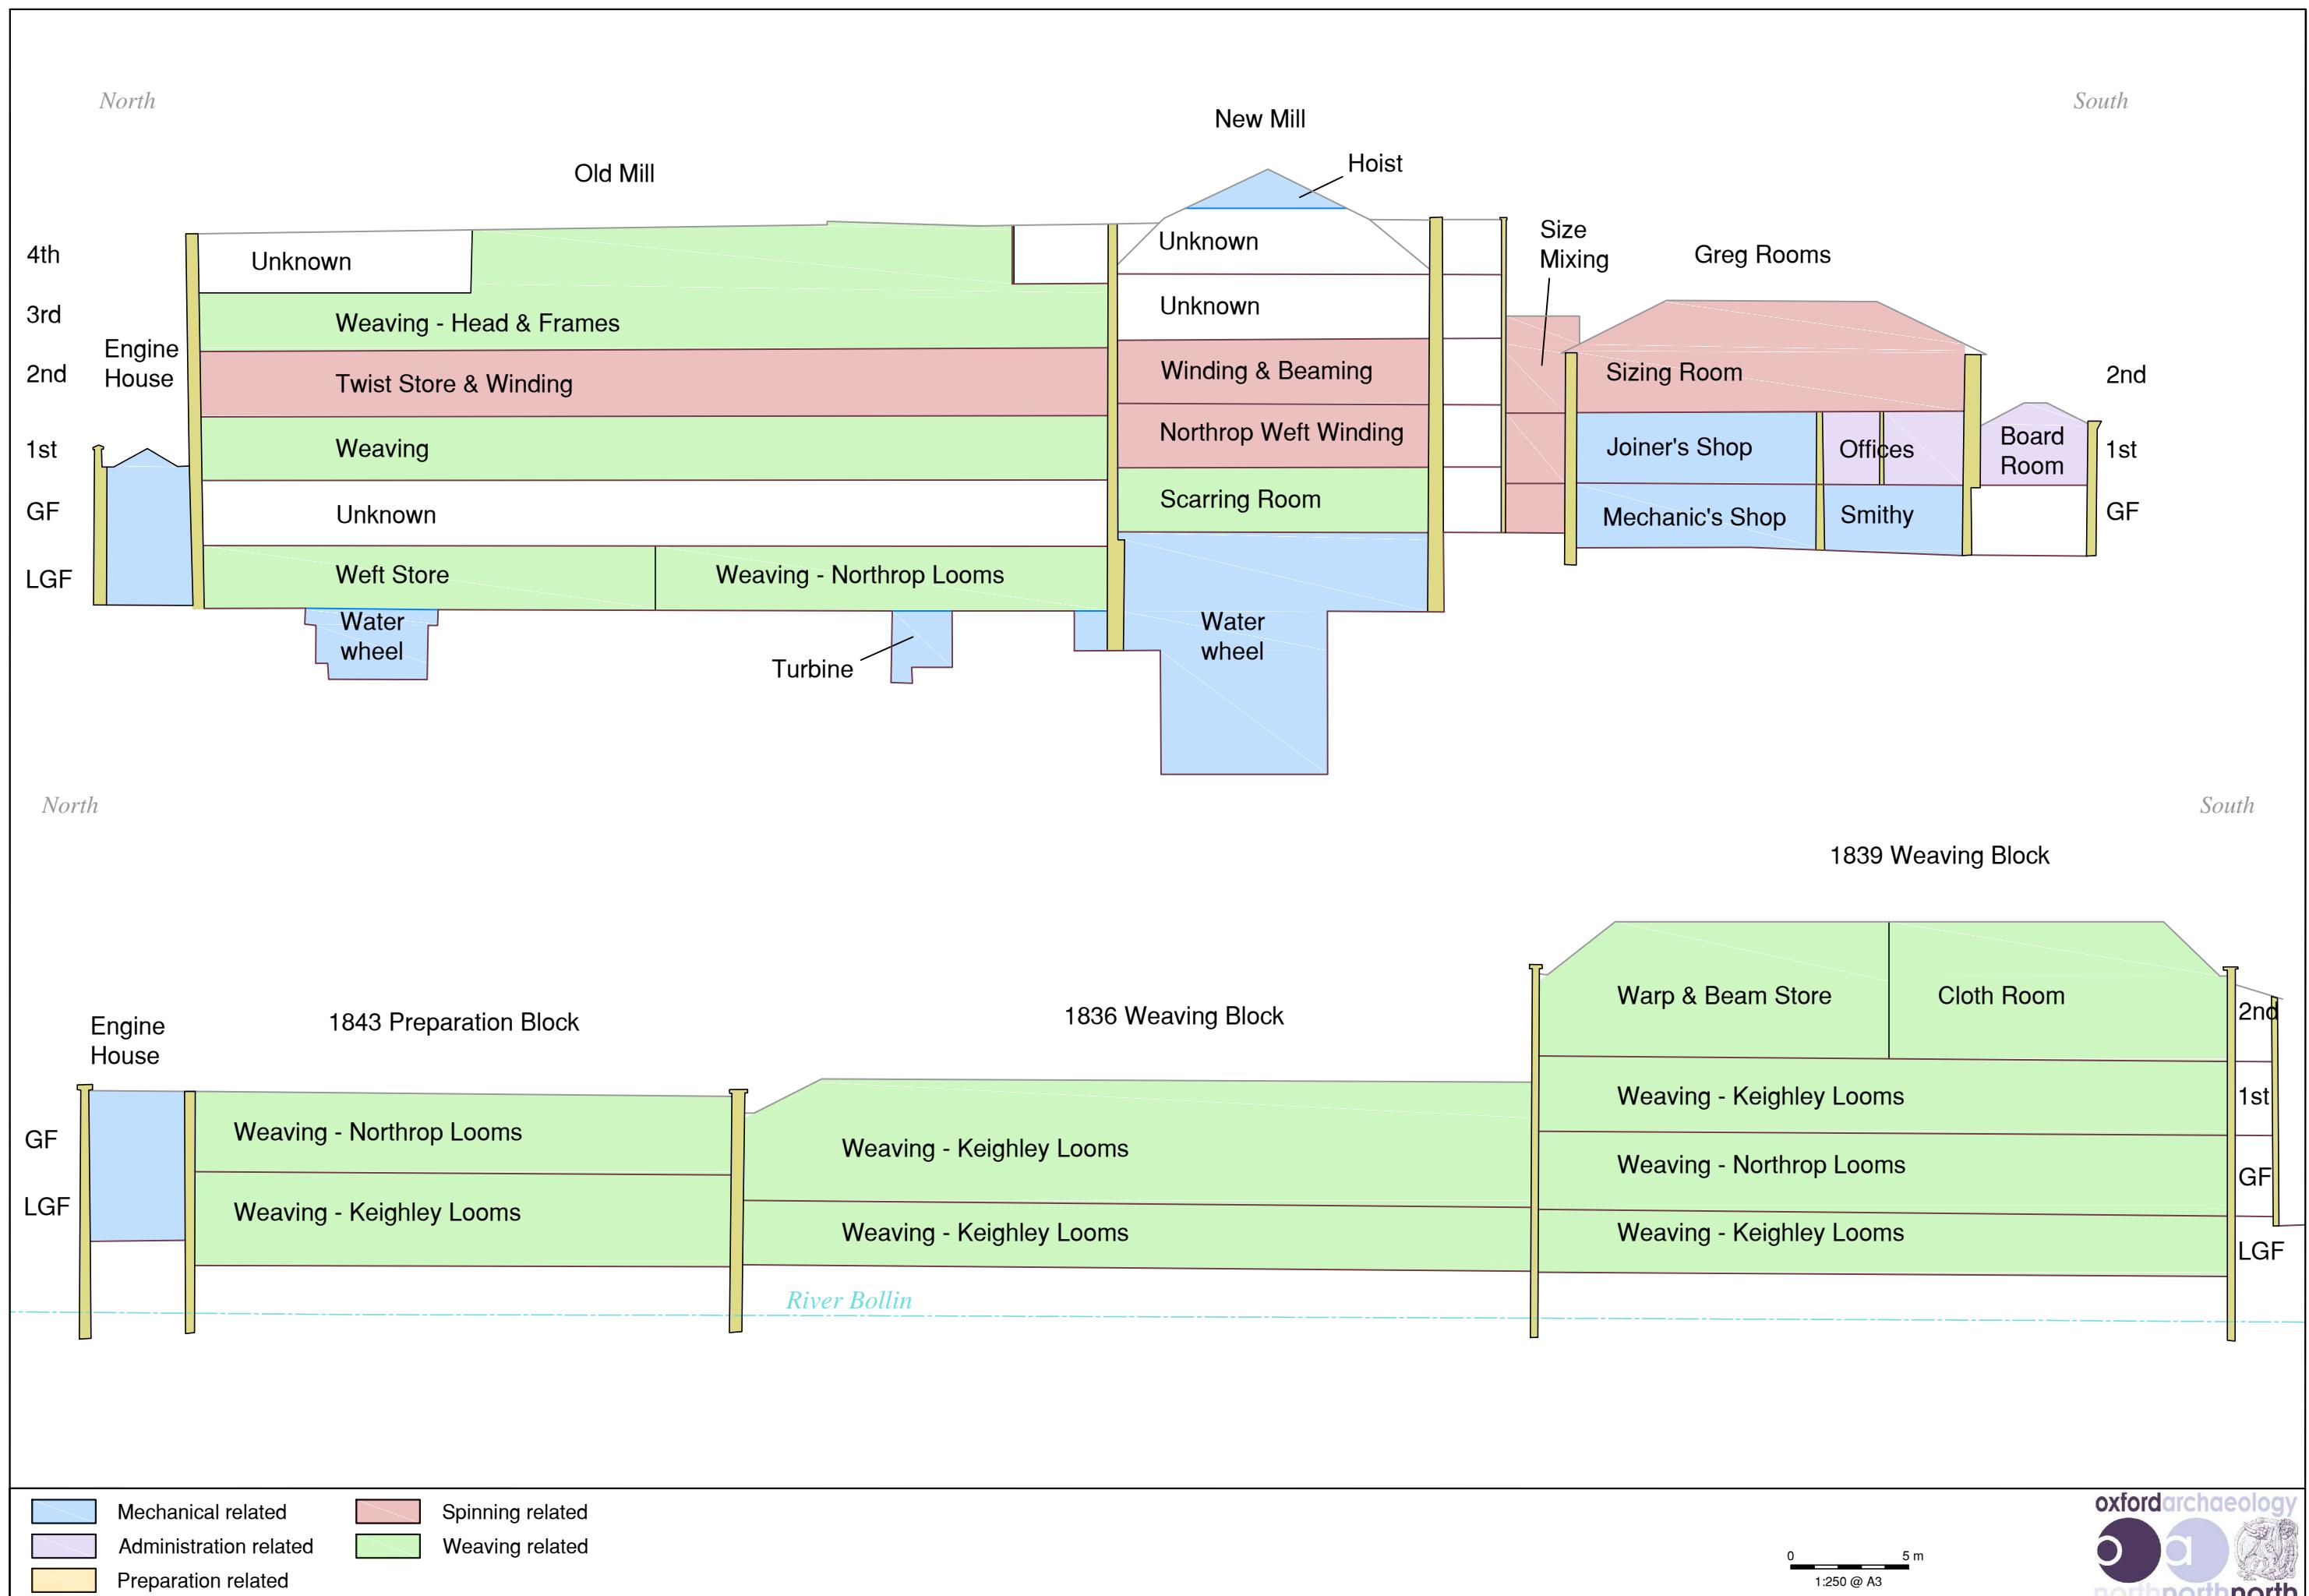


Figure 178: Room usage on cross sections through Quarry Bank Mill in 1922

Oxford Archaeology North

Mill 3
Moor Lane Mills
Moor Lane
Lancaster
LA1 1QD
t: (01524) 541000
f: (01524) 848606
e: oanorth@oxfordarch.co.uk
w: www.oxfordarch.co.uk



Chief Executive Officer:
Dr Gill Hey BA PhD MIfA FSA

Private Limited Company Number: 1618597

Registered Charity Number: 285627

Registered Office: Oxford Archaeology Ltd.
Janus House, Osney Mead, Oxford, OX2 0ES